

CERTIFICATE OF SURVEY

LOT 9

BLOCK 4

JEFFERSON PARK


Scale 10' = 1"

Subscribed and sworn to before me this 14th day of January A.D. 1929.

Charles J. Yackel
Notary Public, Ramsey Co. Minn.
My Commission Expires 20, 1931

St. Paul, Minn. Dec. 29, 1928.
I certify to having surveyed the above described property and that all distances and locations as hereon shown are correct.

Jens Pedersen
Surveyor
215 Olive St. St. Paul, Minn.

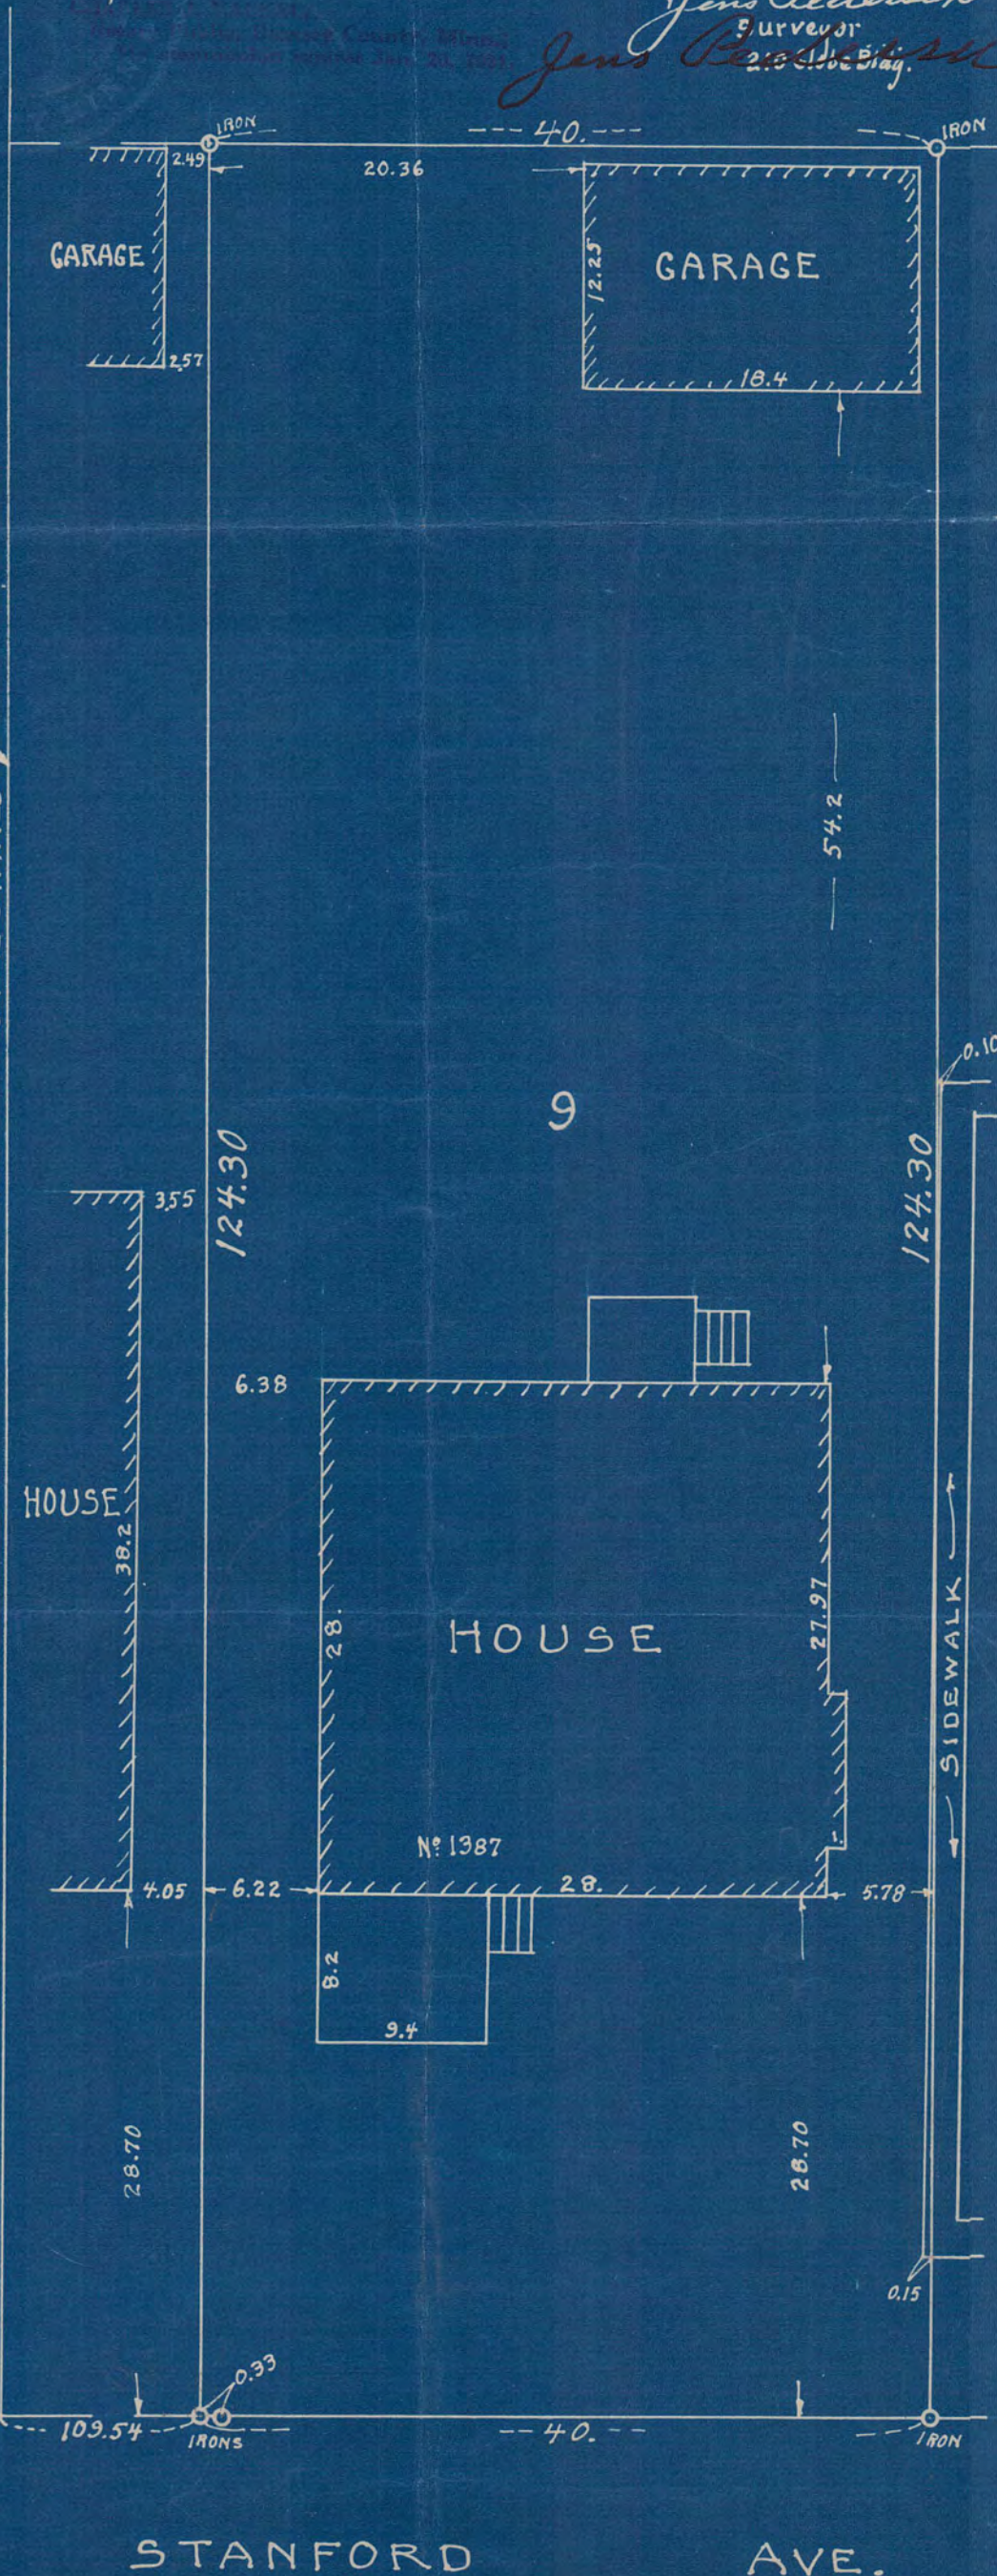

STANFORD AVE.

3635

3635

ABSTRACT OF TITLE

Prepared by The St. Paul Abstract Company

No. 1

To

Lot 9 block 4 of Jefferson Park Addition to the City of Saint Paul,
Ramsey County, Minnesota.

State of Minnesota }
County of Ramsey }

The St. Paul Abstract Company does hereby certify that the following exhibit, consisting of
10 sheets, from 1 to 10 inclusive (each of which bears its Corporate Seal), and
65 entries from 1 to 65 inclusive, is a true and complete Abstract of Title
to the real estate described in No. 1 hereof, as shown by the records in the office of the Register of Deeds
in and for said County and State, up to this 2nd day of February 1928 at 8 o'clock A.M.

THE ST. PAUL ABSTRACT COMPANY
ABSTRACTERS

Henry Toucheray

TREASURER

-2-

*NE 1/4 of NW 1/4
Jan. 9 9. 28 R. 23.*

