


Map Showing
 Lot 2, Bloc 6 of Sabin's Garden Lots.
 Sec. 15, T 118, R. 22.

I certify that all dimensions shown above
 are correct and that the corners of N. 1/2 of
 Lot No. 2 are correctly staked.

St. Paul, Minn. March 27. 30. H. von Hippel, C. E. & Surv.
 Scale 100 Ft = 1 In.

3761

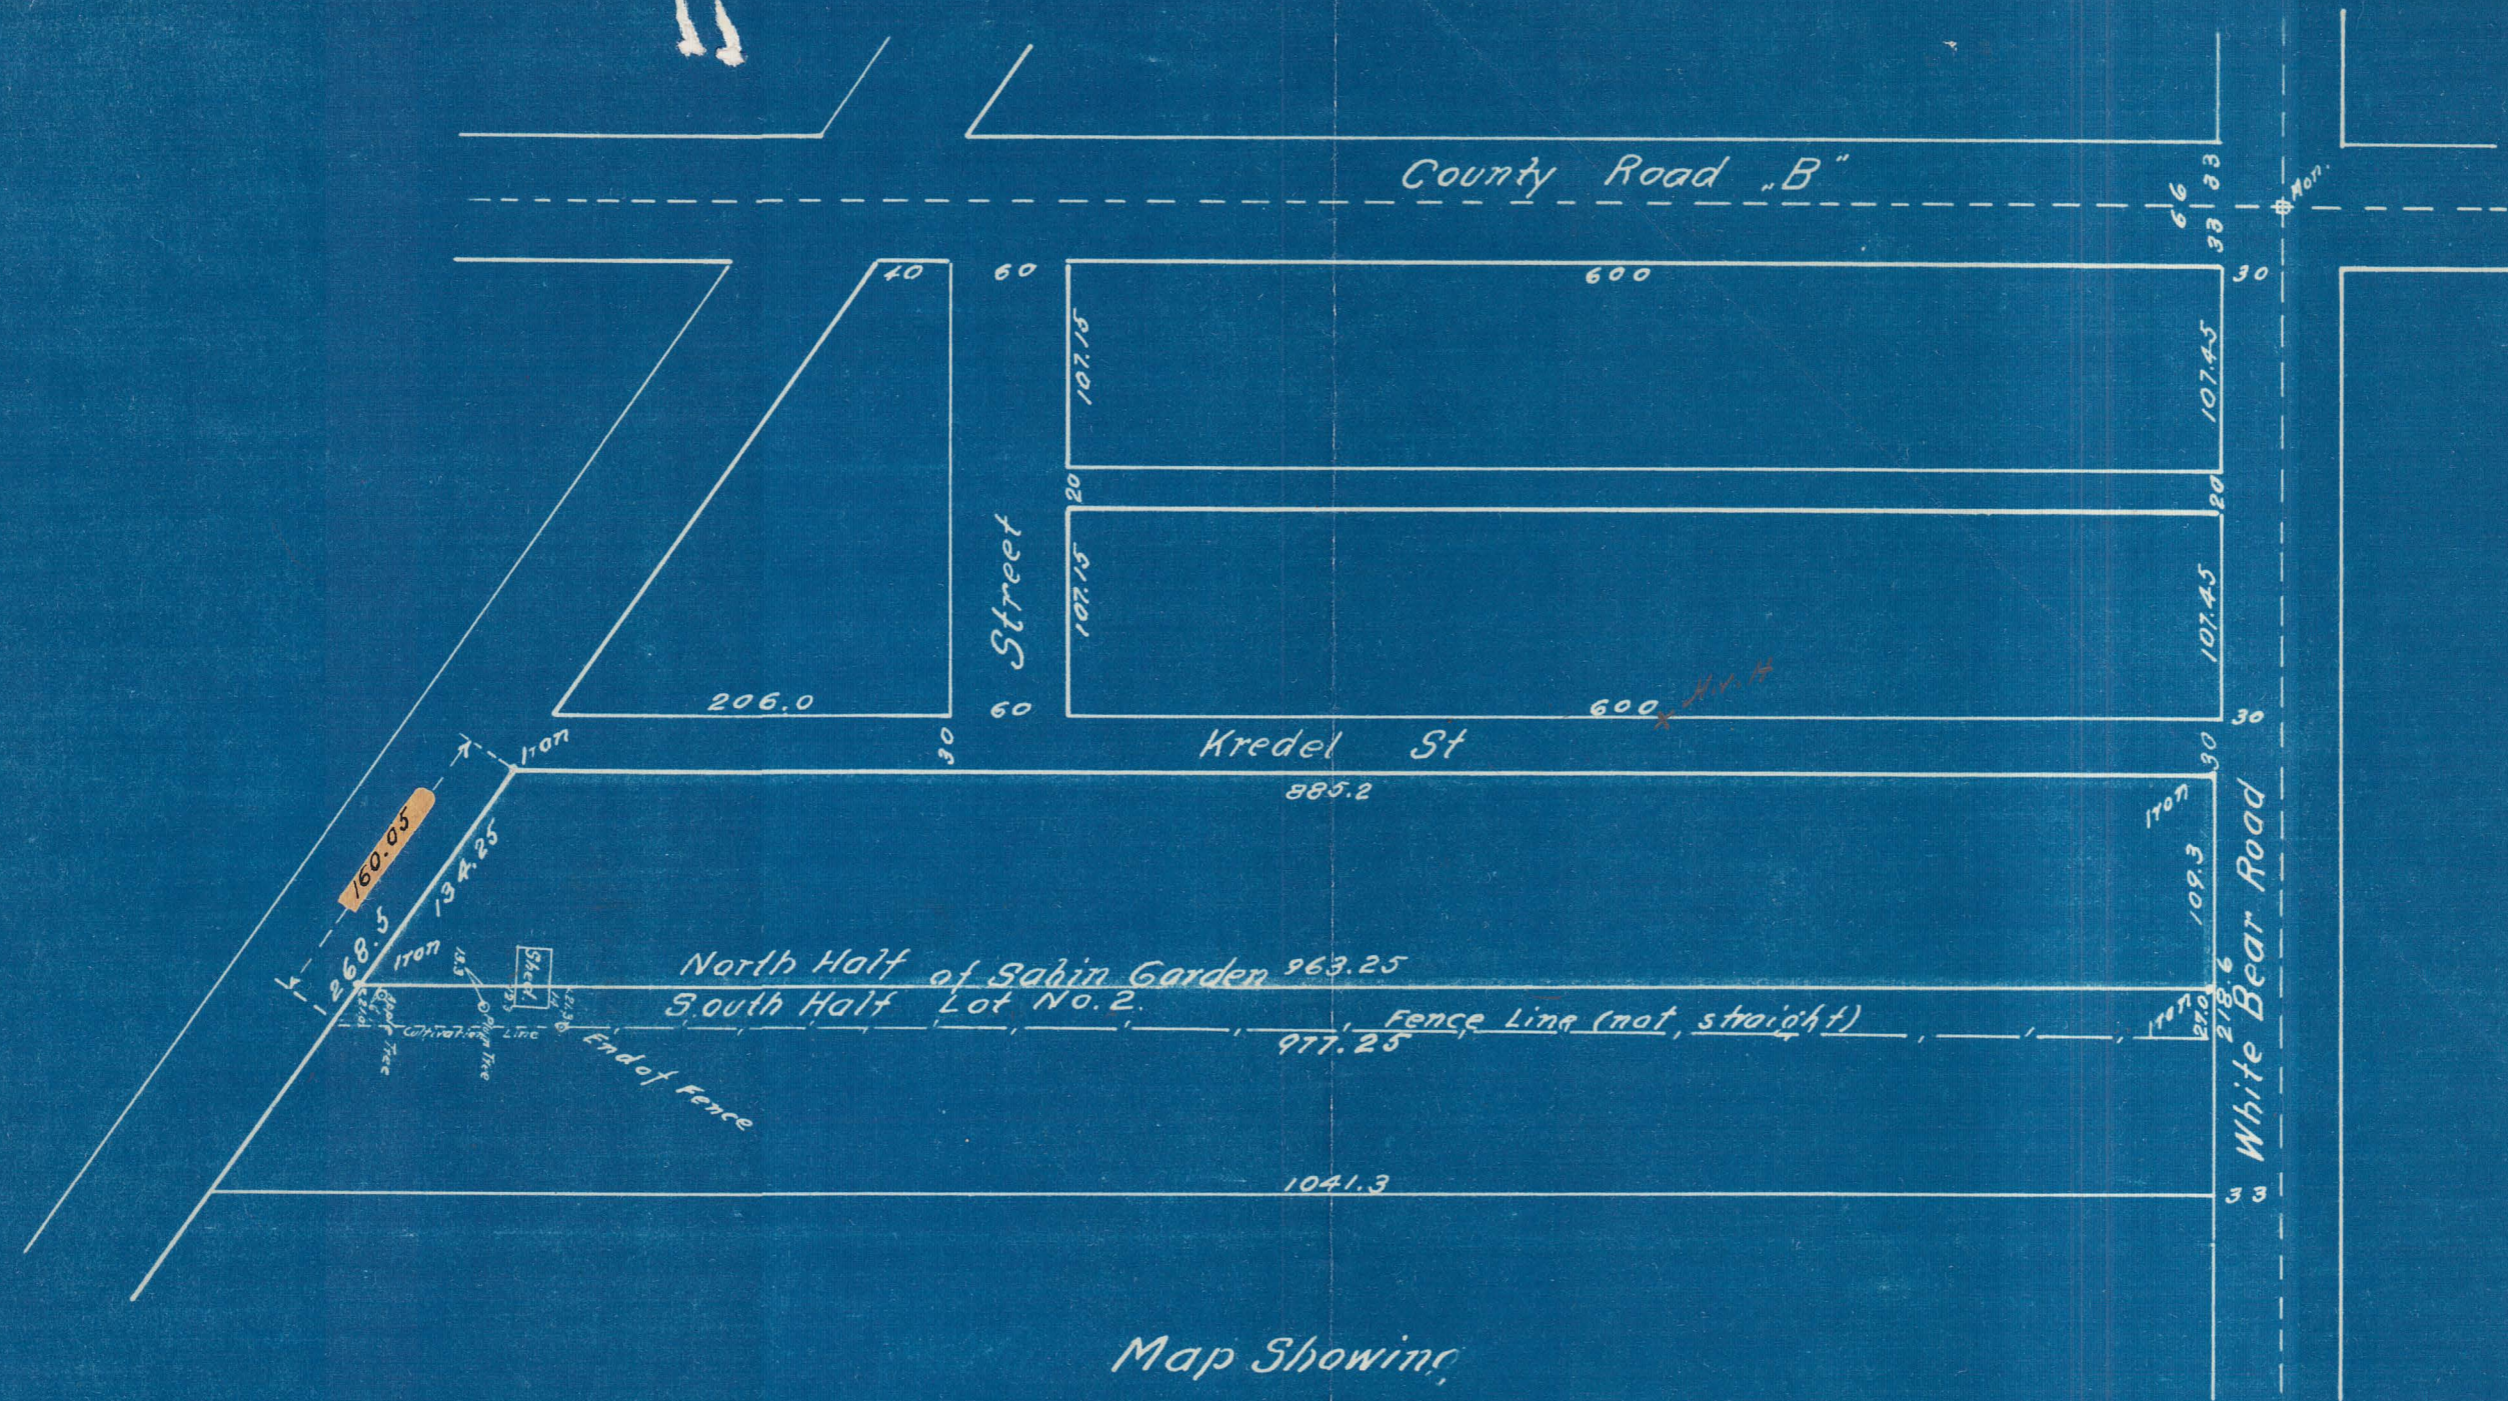

Map Showing
 Lot 2, Bloc 6 of Sabin's Garden Lots.

Sec. 15. T 118. R. 22.

I certify that all dimensions shown above
 are correct and that the corners of N. 1/2 of
 Lot No. 2 are correctly staked.

St. Paul, Minn. March 27. 30.

H. von Hippel, C. E. & Surv.

Scale 100 Ft = 1 In.