


ST

ROBERT

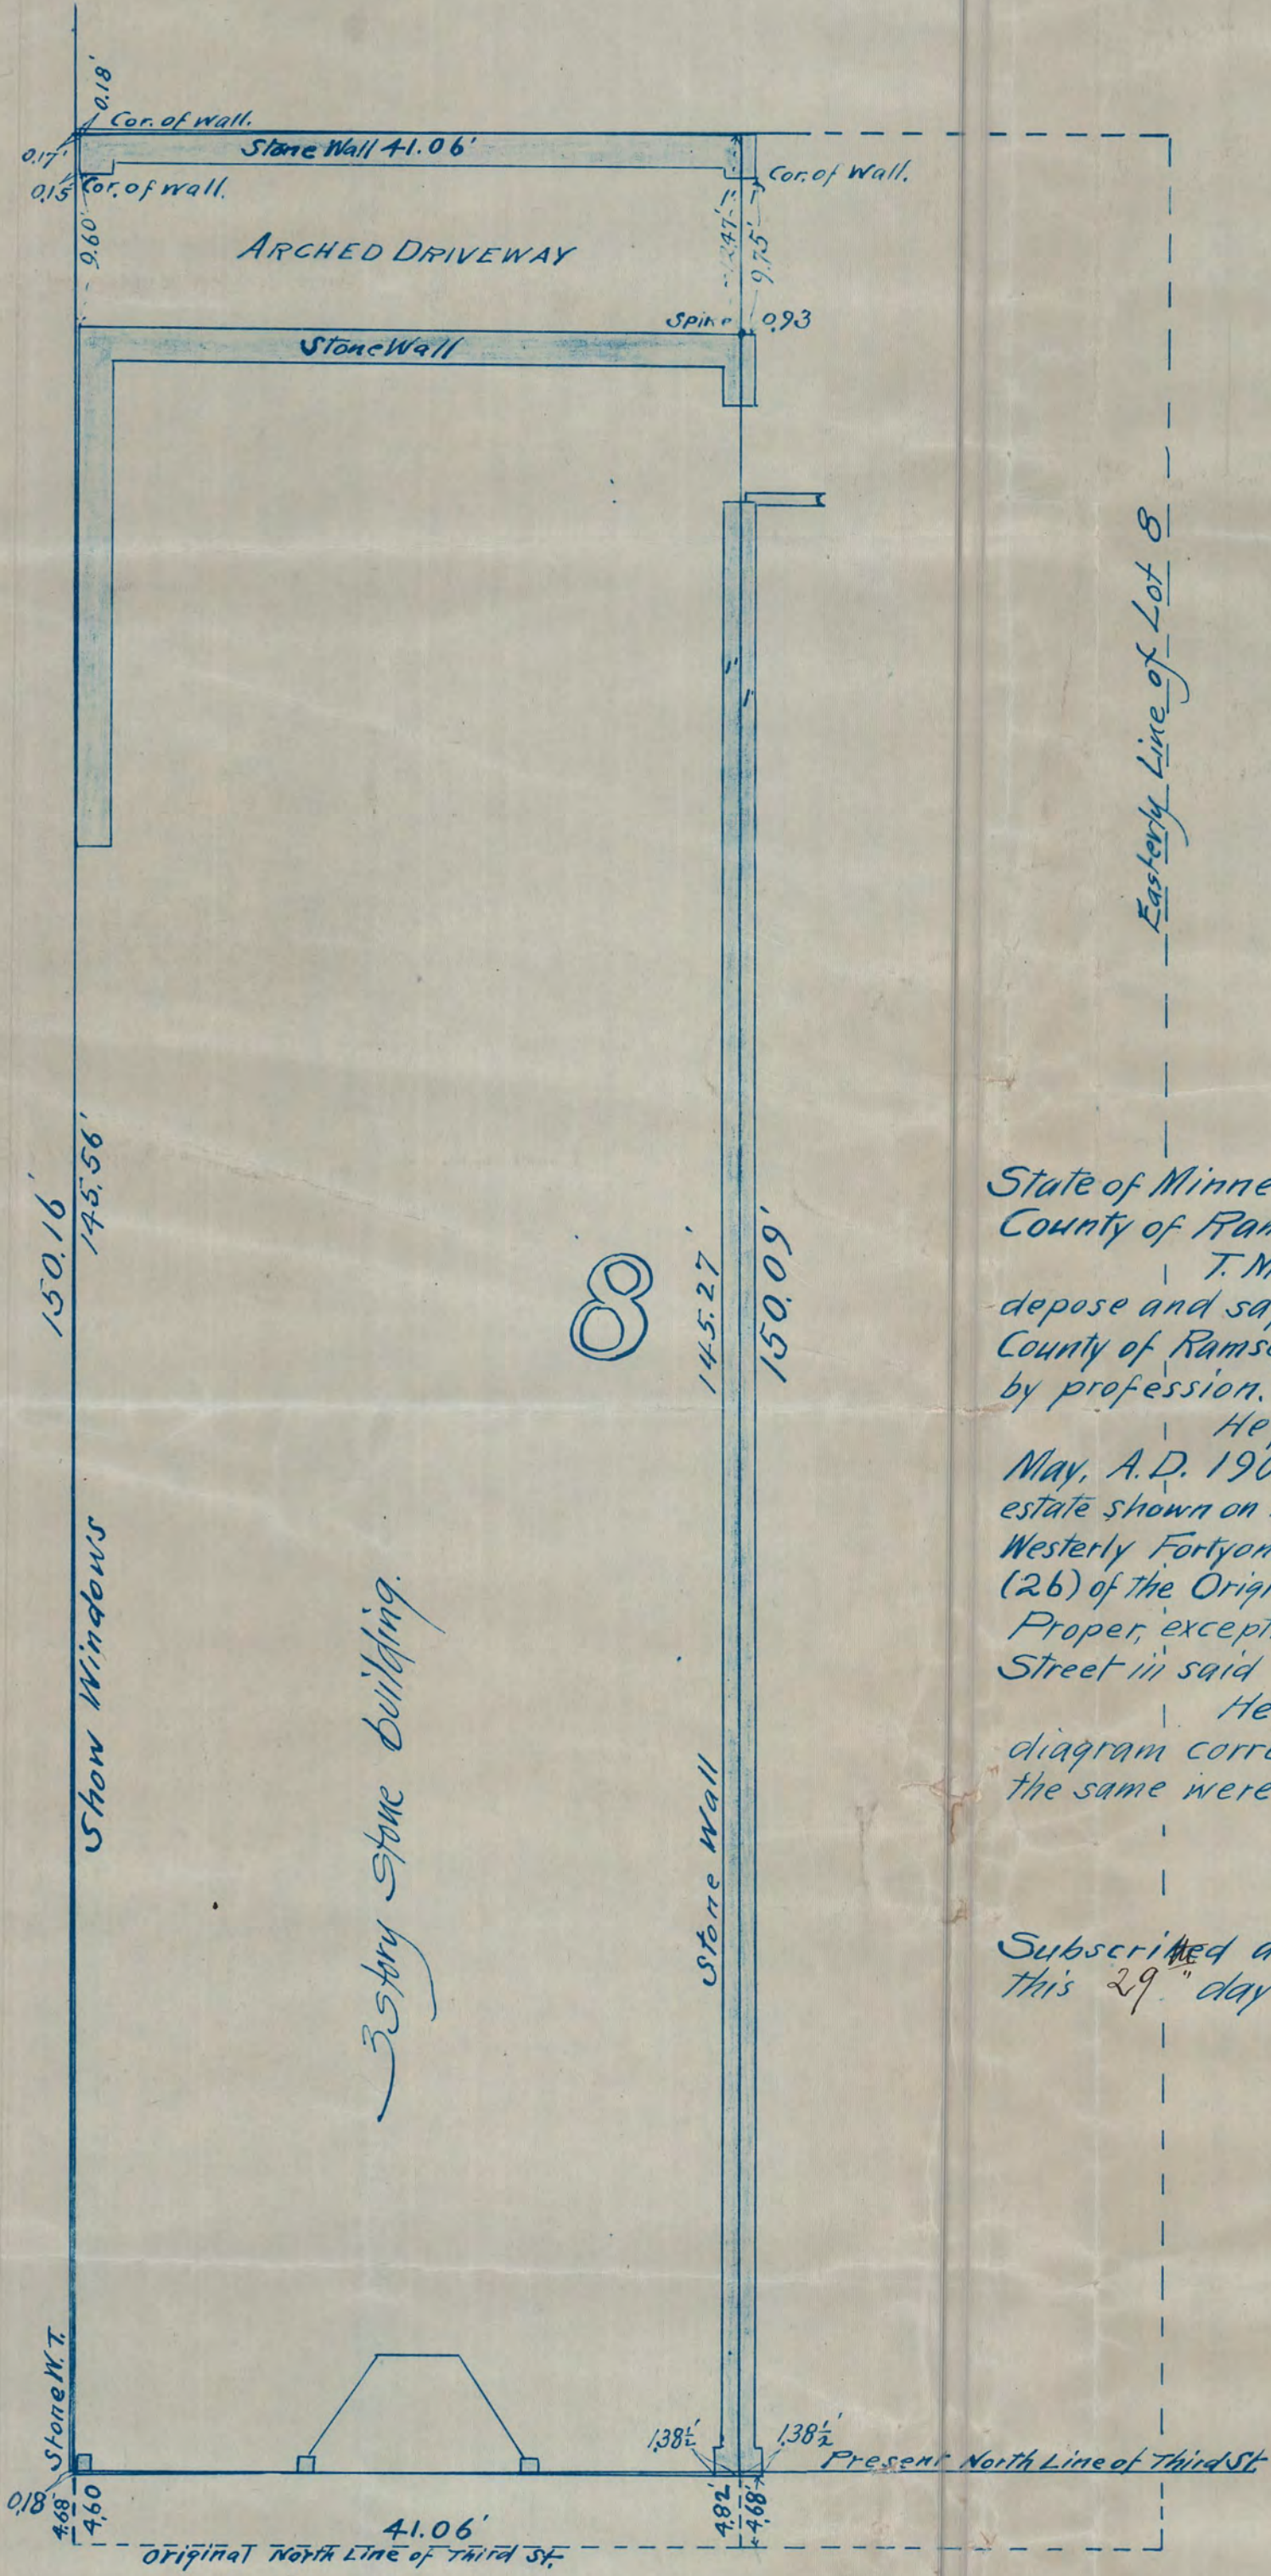

SCALE, 10 ft. per Inch.

SURVEYED FOR
WILLIAM G. WHITE,
ATTORNEY.

State of Minnesota, } ss.
County of Ramsey, }

T. Milton Fowble being first duly sworn doth depose and say that he is a resident of the City of St. Paul, County of Ramsey and State of Minnesota and a Civil Engineer by profession.

He further deposes and says that in the month of May, A.D. 1906 he made a survey of the premises and real estate shown on the accompanying diagram the same being the Westerly Fortyone and 1/100 (41.06) Feet of Lot Eight (8) Block Twentysix (26) of the Original town of St. Paul, commonly known as St. Paul Proper, excepting the part thereof taken for the widening of Third Street in said City of St. Paul.

He further deposes and says that the accompanying diagram correctly and accurately represents said premises, as the same were surveyed by him, as aforesaid.

T. Milton Fowble

Subscribed and sworn to before me
this 29th day of May, A.D. 1906.

William G. White

Notary Public
Ramsey County,
Minnesota.

My Commission Expires November 2, 1906.

E. THIRD ST