


RANDOLPH ST.

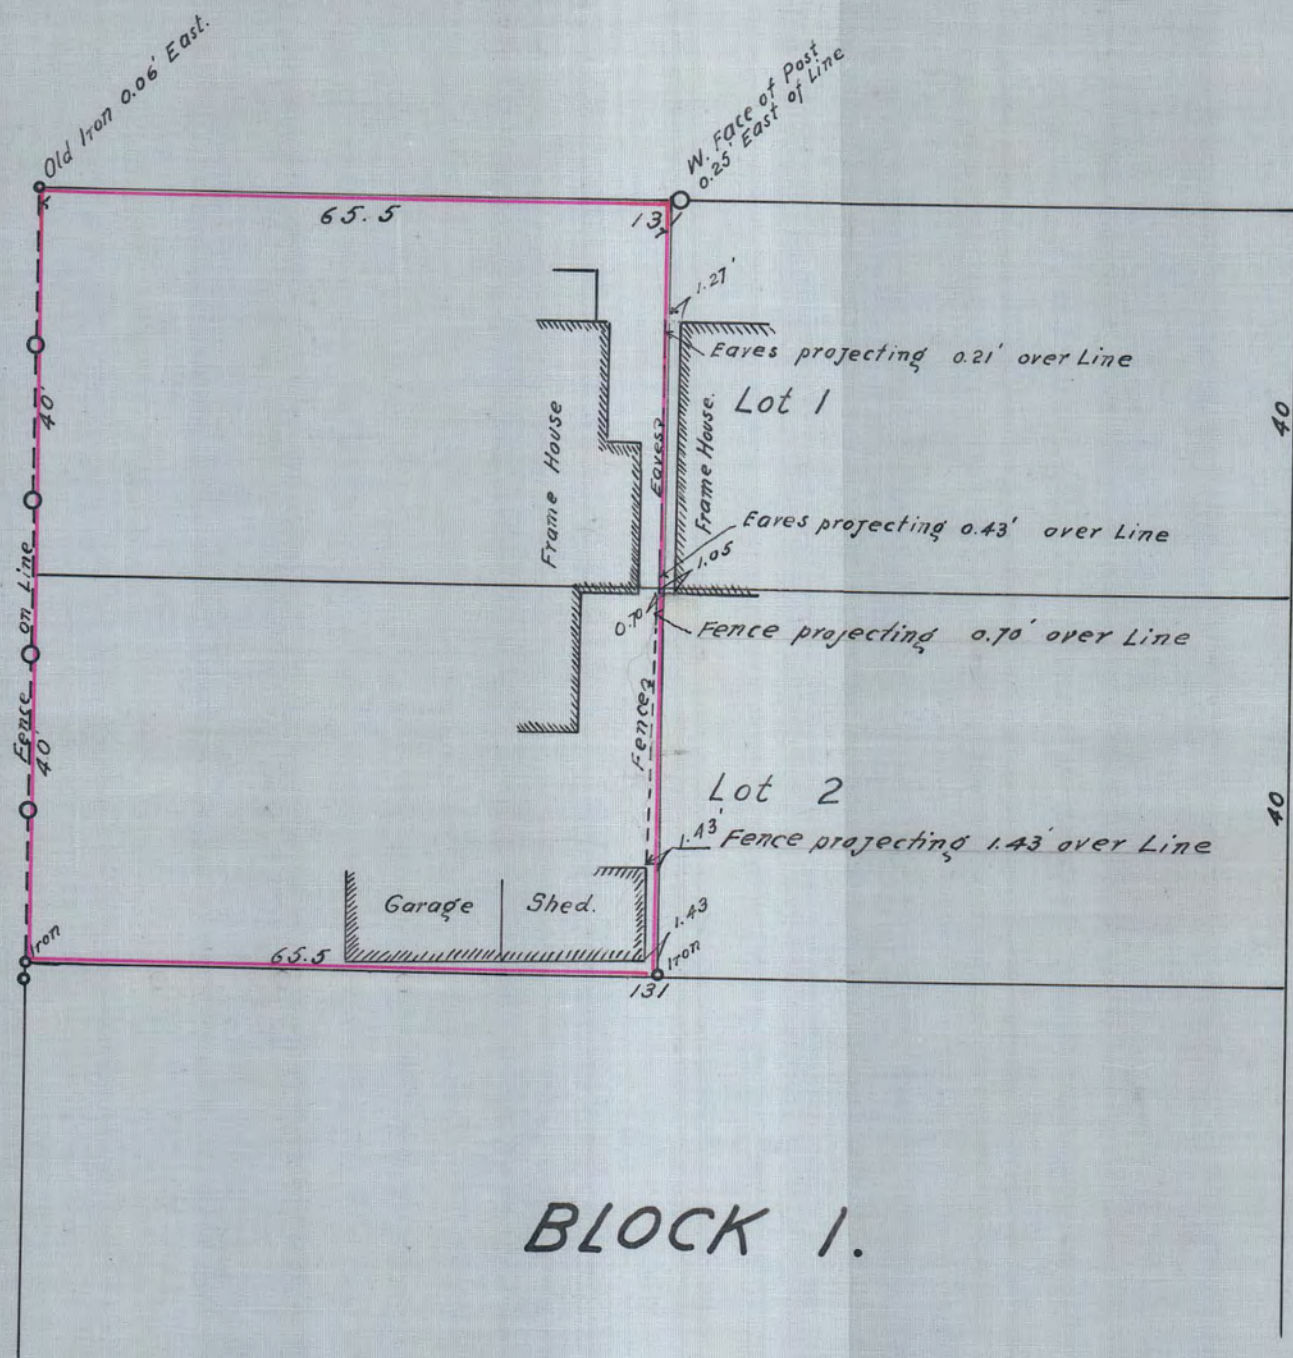

BAY ST.

BLOCK 1.

MAP

Showing Survey of west half of Lots 1 and 2, Block 1  
in Scheffers Addition.

St. Paul, Minn. Dec. 21, 1931

Scale: 20ft. = 1 in.

H. von Hippel.

Civil Engineer & Surveyor.

3859

382d

# 3859