


SURVEY of Lot 6 & So. 6.75' of Lot 7, B1K. 1,
MCKENTYS OUTLOTS to St. PAUL MINN.

Scale 10ft = 1 Inch

o Indicates Irons

April 1932

E. C. Swenson
Reg. Surveyor

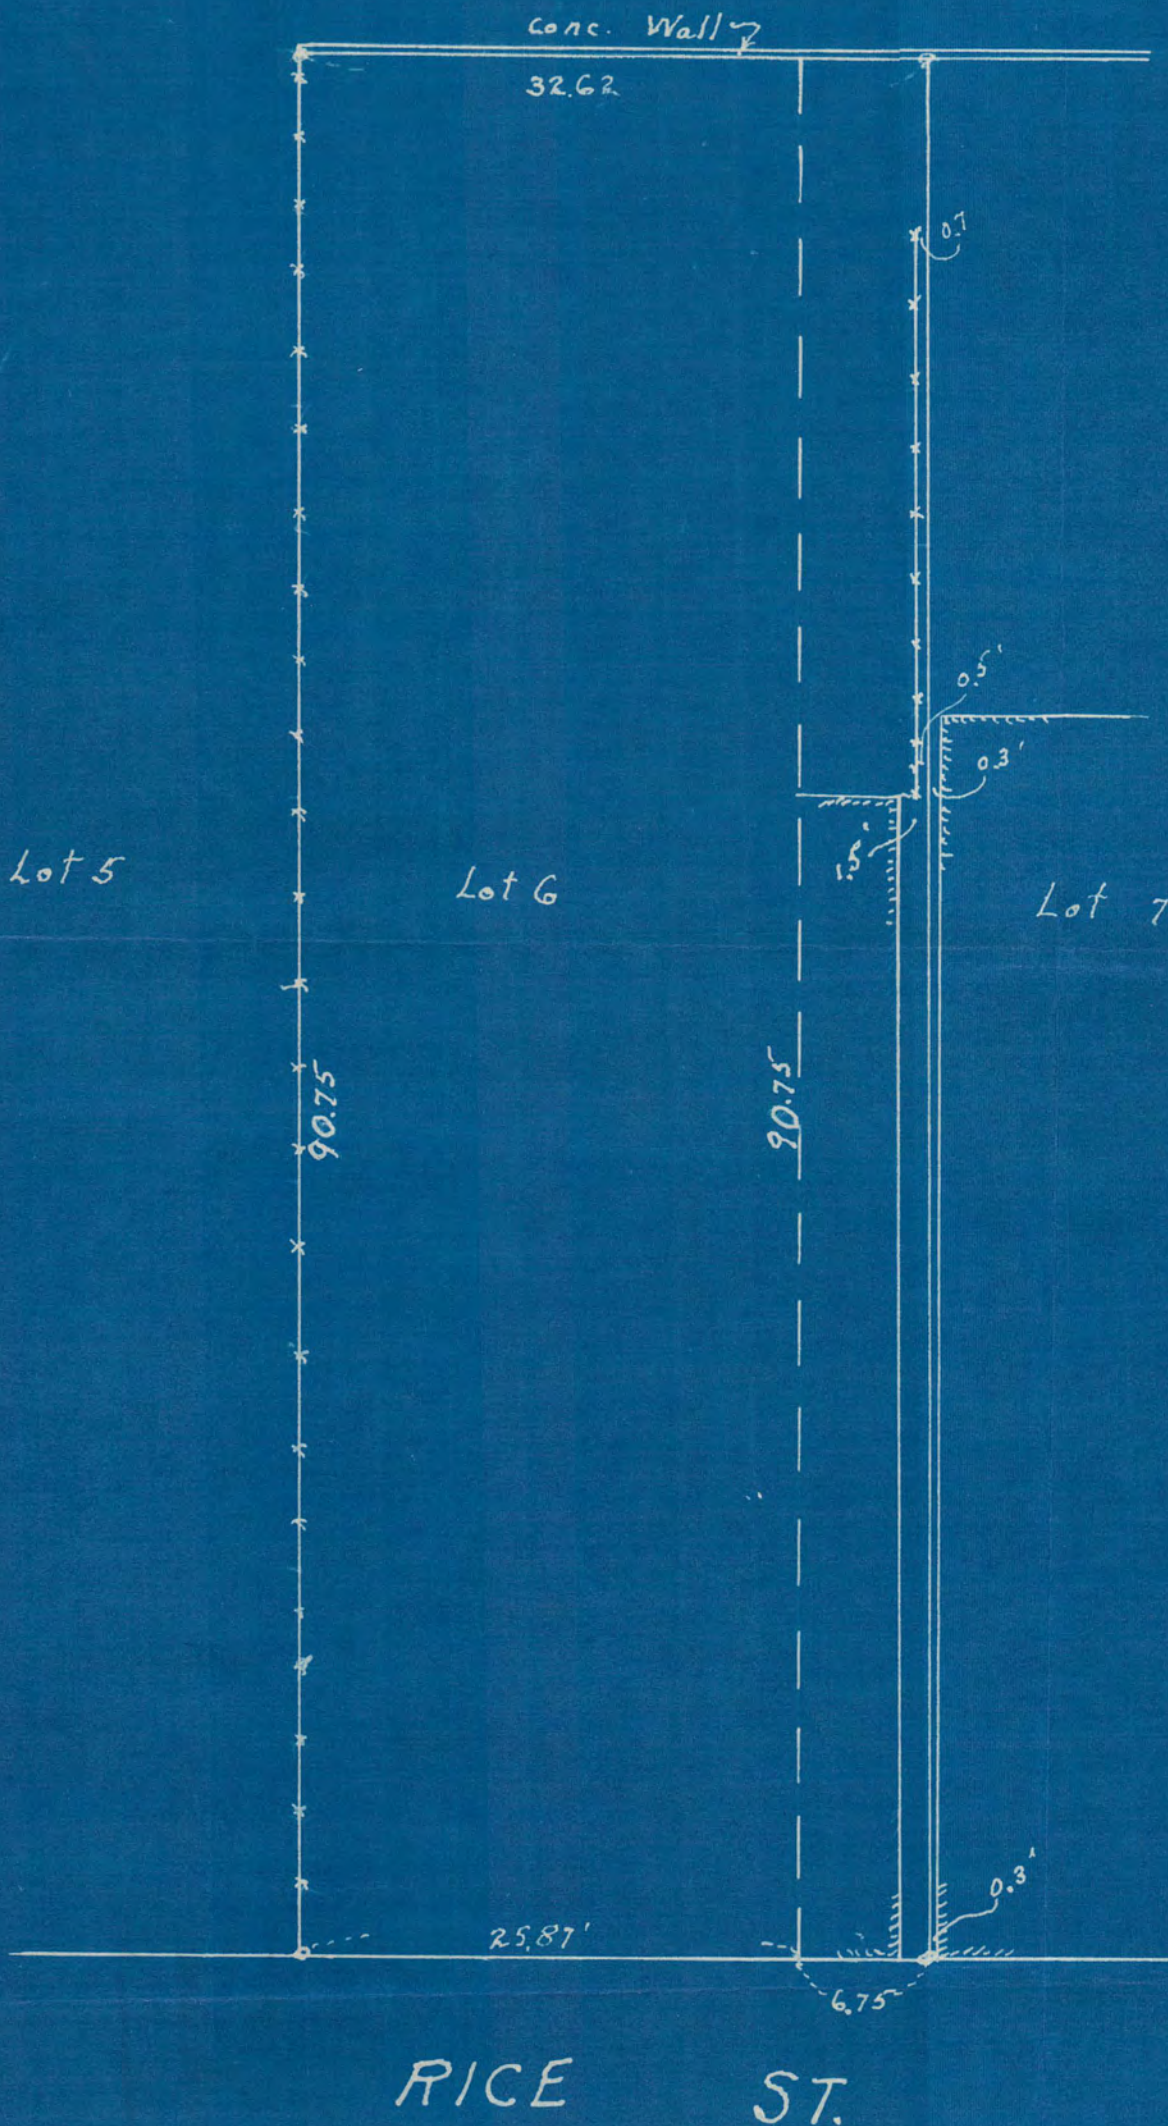

I, E.C. Swenson, do hereby certify that I am a duly licenced Registered Surveyor in and for the State of Minnesota, and that I have Surveyed the land as described on this Plat, being described as Lot 6, & So. 6ft & 9 Inche. of Lot 7, B1K 1 McKentys Outlots, to St Paul Ramsey Co., Minnesota, and that there has been no encroachments by adjoining owners

E. C. Swenson
Surveyor

Subscribed and Sworn to before me
this 11 dayth April 1932

Mark W. Woodruff

MARK W. WOODRUFF,
Notary Public, Ramsey County, Minn.
My Commission expires April 22, 1934

3865