

3866

# ABSTRACT OF TITLE.

Prepared by The St. Paul Abstract Company.

No. 1

To Lot 24 Block 2 Auditor's  
Subdivision No 37 St Paul Minn

State of Minnesota, }  
County of Ramsey.

The St. Paul Abstract Company does hereby certify that the following exhibit, consisting of 7 sheets, from 1 to 7 inclusive (each of which bears its Corporate Seal), and 48 entries from 1 to 48 inclusive, is a true and complete Abstract of Title to the real estate described in No. 1 hereof, as shown by the records in the office of the Register of Deeds in and for said County and State, up to this 19th day of November 1906 at 8 o'clock P.M.

THE ST. PAUL ABSTRACT COMPANY,  
ABSTRACTERS.

J. A. Sawyer  
VICE-PRESIDENT

2

	8	9	10	11	12	13	14
Ross							
	15	24	25	26	27	28	
	45	45	45	45	45	45	432

Sh

2-29

English

3866

# 3866

A

SURVEY

LOT-24- EXCEPT THE WESTERLY 4.5ft. THEREOF  
AND THE WESTERLY 6.5ft. of LOT-25-

3866


BLK-2- AUDITORS SUBDIVISION NO-37-

Scale-1-inch=15ft.

ROSS

ST.

May-23-1931

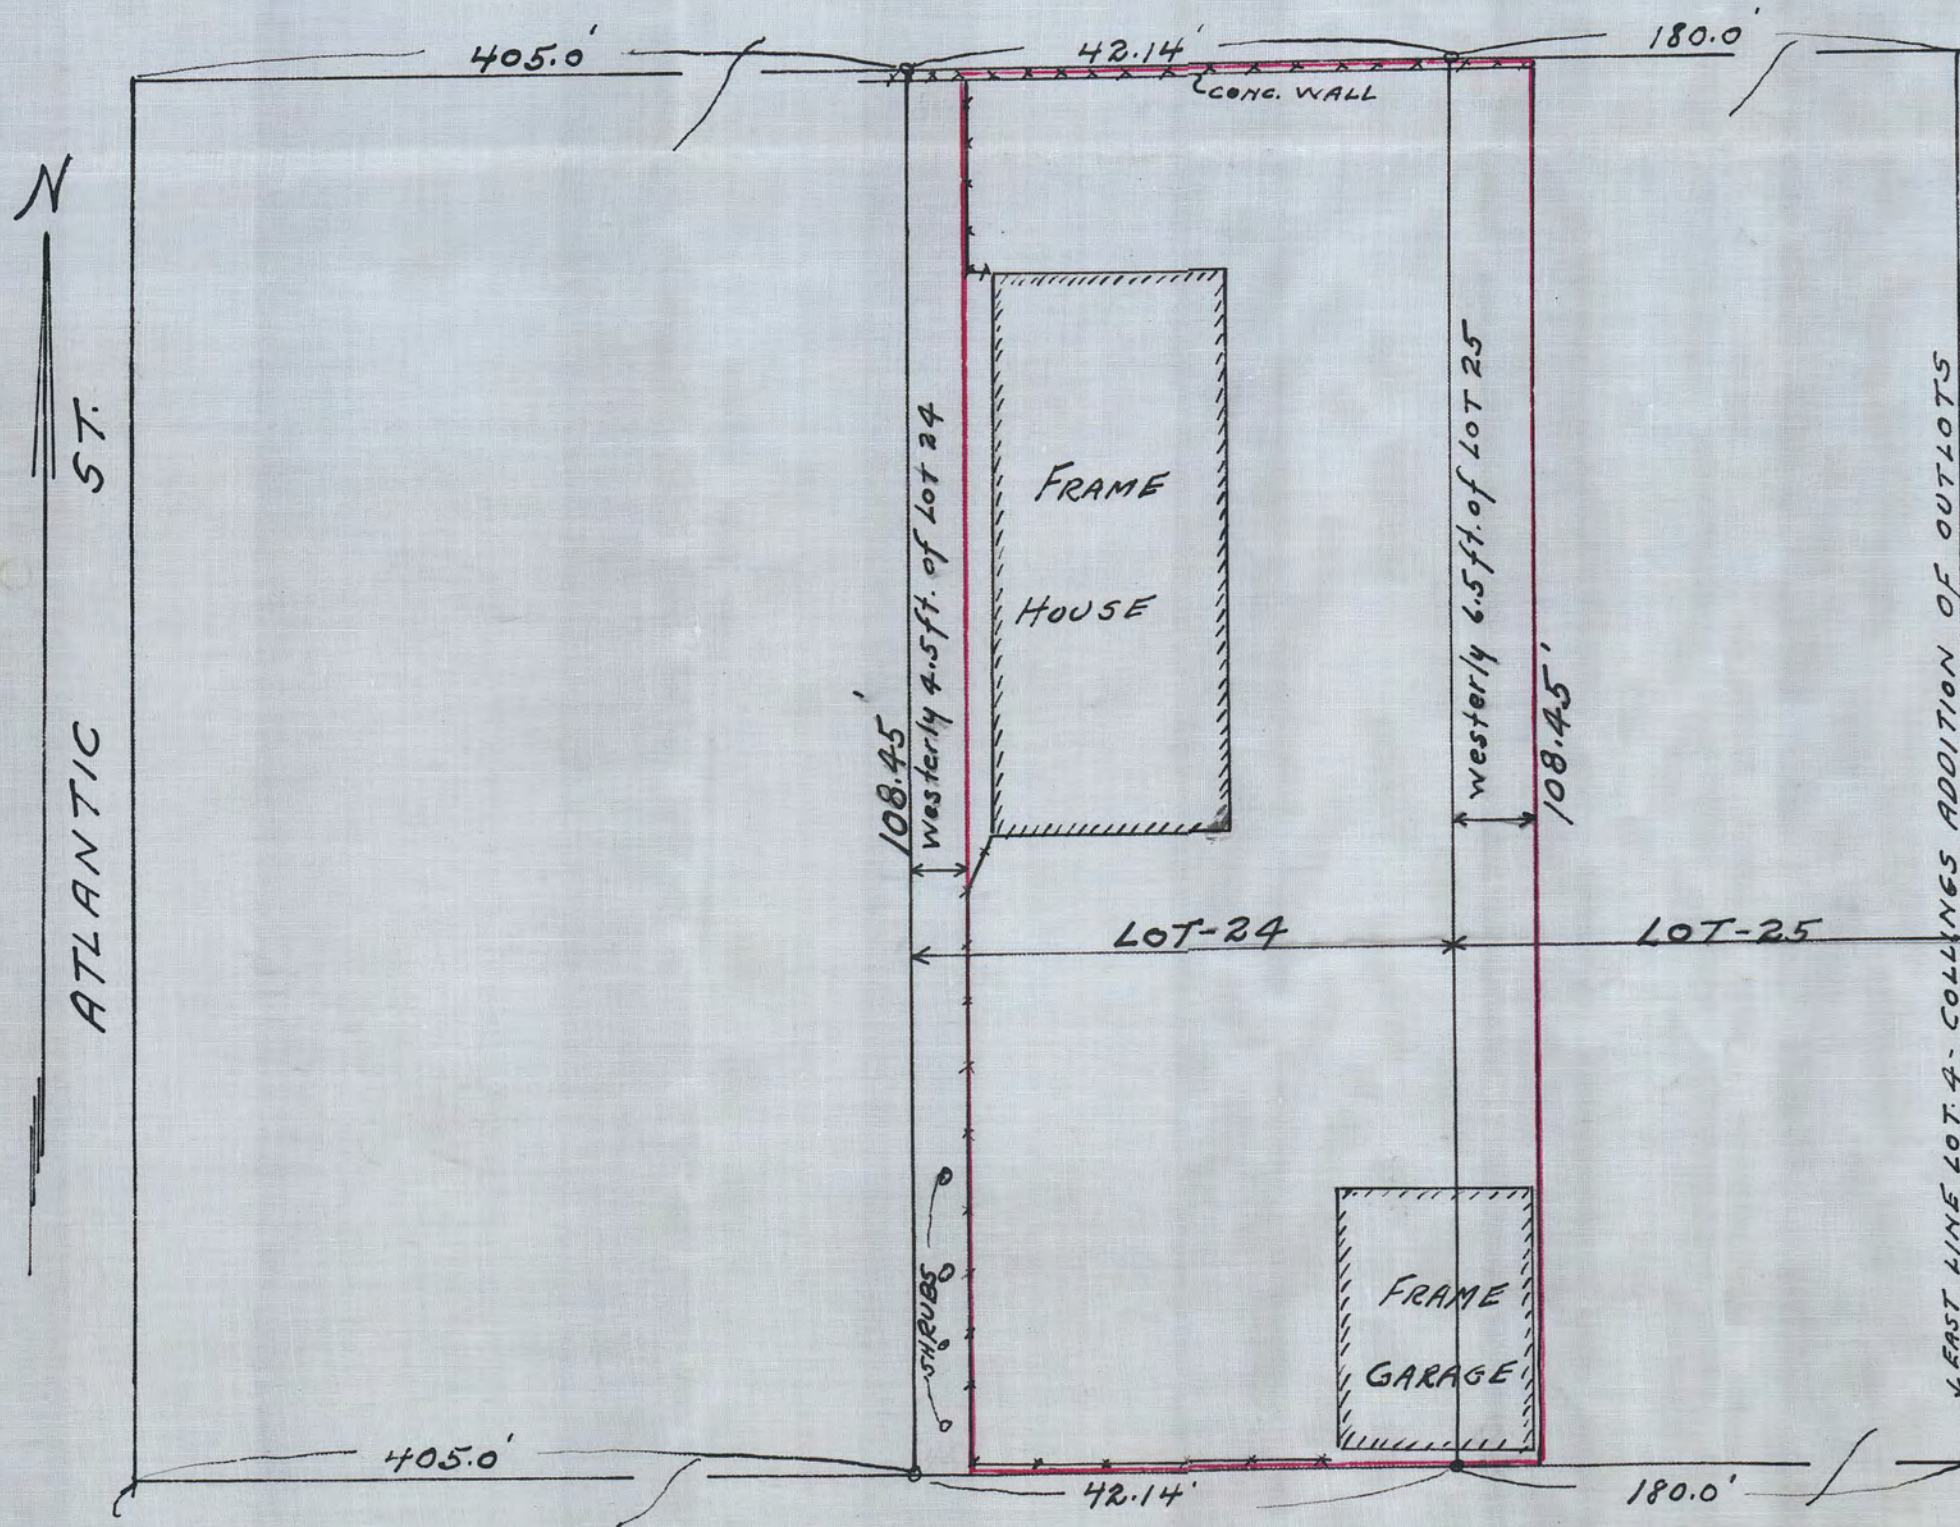

S.W. COR LOT-4-  
COLLINGS ADDITION  
OF OUTLOTS

I hereby certify that this is a true and correct plot  
and that there are no other buildings or obstructions  
except as shown hereon of LOT 24 except the  
westerly 4.5 ft. thereof and the westerly 6.5 ft. of  
LOT-25 all of the above being in BLK-2-  
AUDITORS SUBDIVISION NO-37-.

W. J. Brettschneider  
Surveyor.

State of Minnesota } ss  
County of Ramsey }

Subscribed and sworn to before me this 27<sup>th</sup>  
day of April 1932

Philip Gilbert  
Notary Public Ramsey County  
Minnesota My Commission Expires  
Sept 29 1938

FILED

APR 29 1932

N. C. EBBINSON, Clerk

#3866