

3882

AUDITOR'S SUB. No. 30


SURVEY OF

LOT No. 2

SCALE 20' = 1"

APR-19-1933

JENS PEDERSEN
SURY.

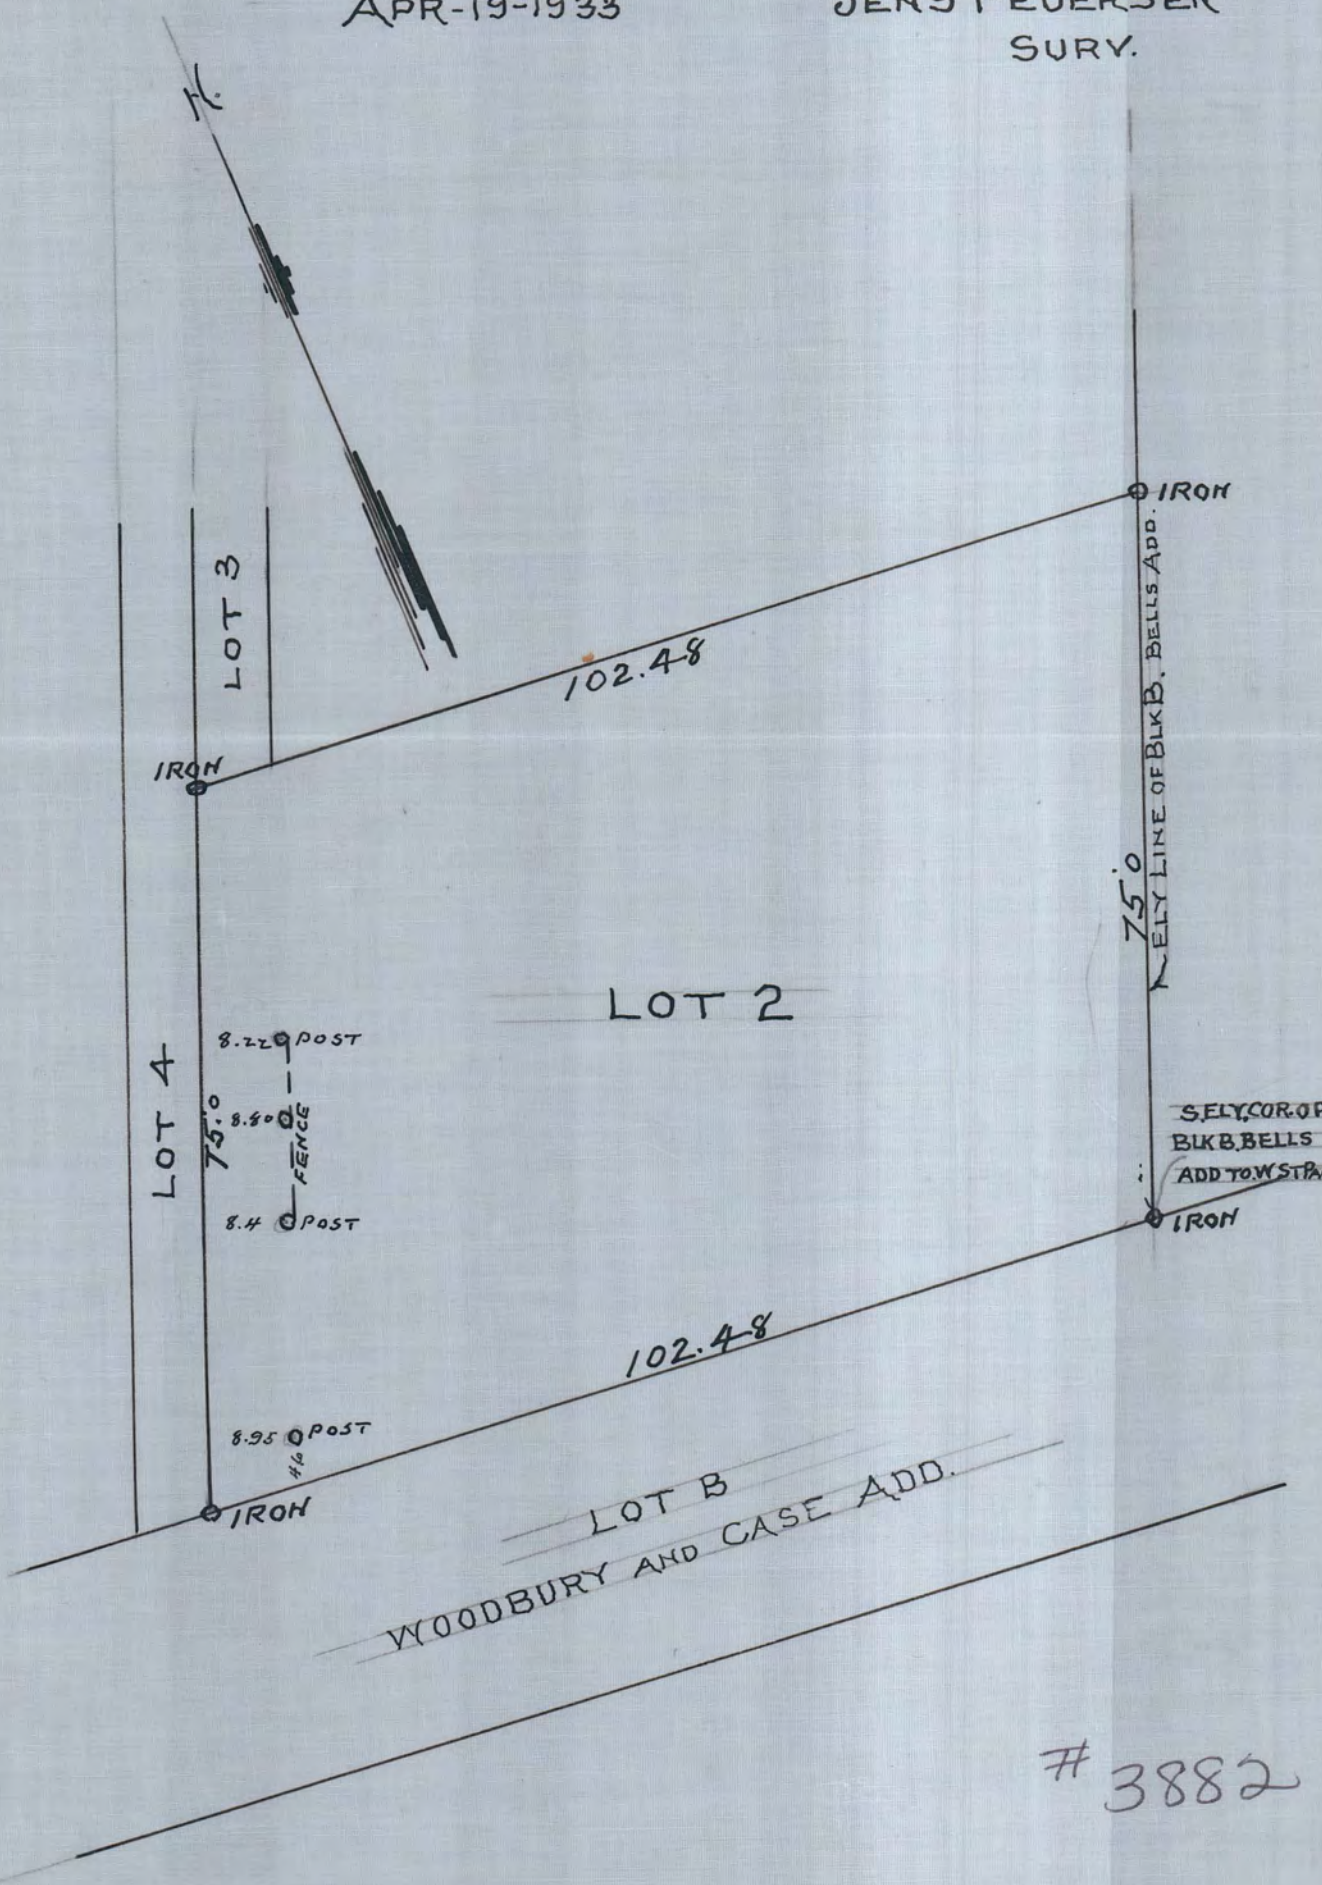

S ELY COR. OF
BLK B, BELLS
ADD TO W ST

LOT B
WOODBURY AND CASE ADD.

3882