

# DESNOYER PARK

## SURVEY OF

LOTS 8, 9, 10, 11, 12 AND 13 BLOCK 60 AND NORTH 1/2 OF LAUREL AVE. NOW VACATED AND  
AND THAT PART OF ALLEY LYING BETWEEN THE ABOVE DESCRIBED LOTS NOW VACATED

ST PAUL AUG 31-1932

I HEREBY CERTIFY TO HAVING SURVEYED  
THE ABOVE DESCRIBED PROPERTY AND ALL  
DISTANCES AS HEREON SHOWN ARE CORRECT  
AND THERE NO ENCROACHMENTS ON SAME


SUBSCRIBED AND SWORN TO  
BEFORE ME THIS 15<sup>th</sup> DAY  
OF September A.D. 1932

NOTARY PUBLIC RAMSEY COUNTY MINN

MY COMMISSION EXPIRES Aug 15, 1939

Jens Pedersen  
SURVEYOR

MISSISSIPPI RIVER BOULEVARD

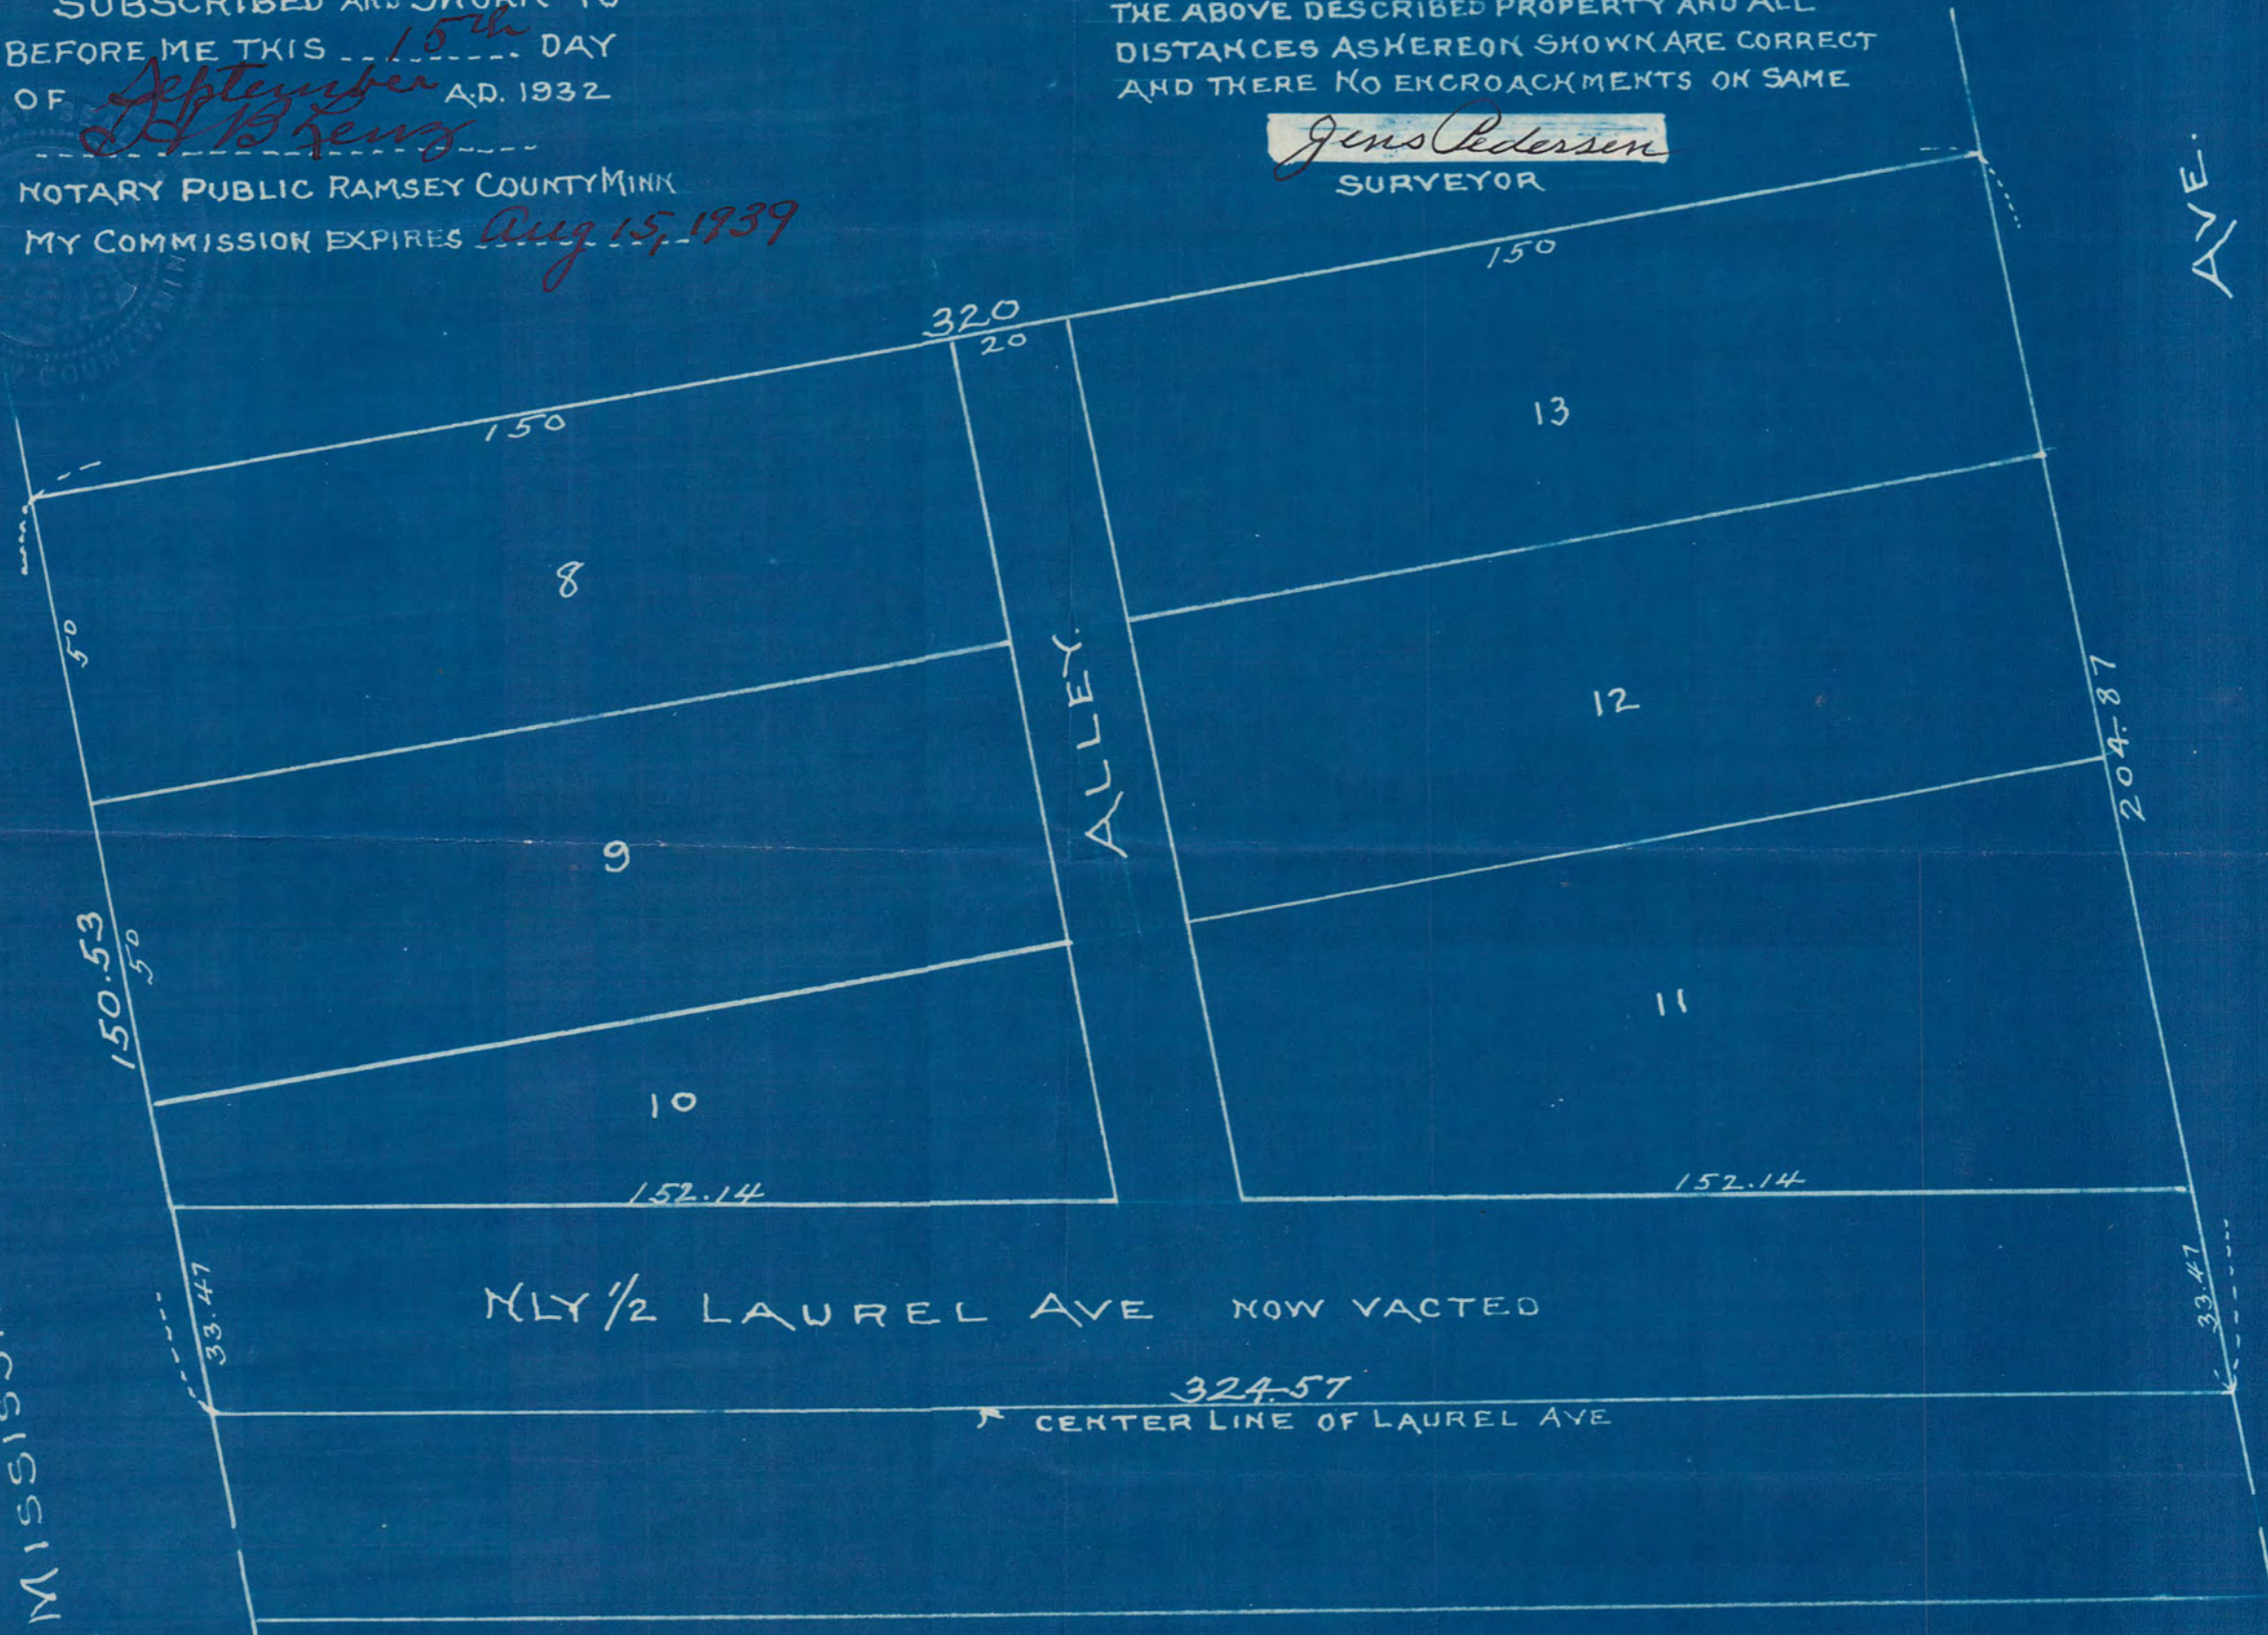

# 3887