CERTIFICATE of SURVEY

F. J. Armstrong
Civil Engineer & Surveyor
St. Paul, Minn.

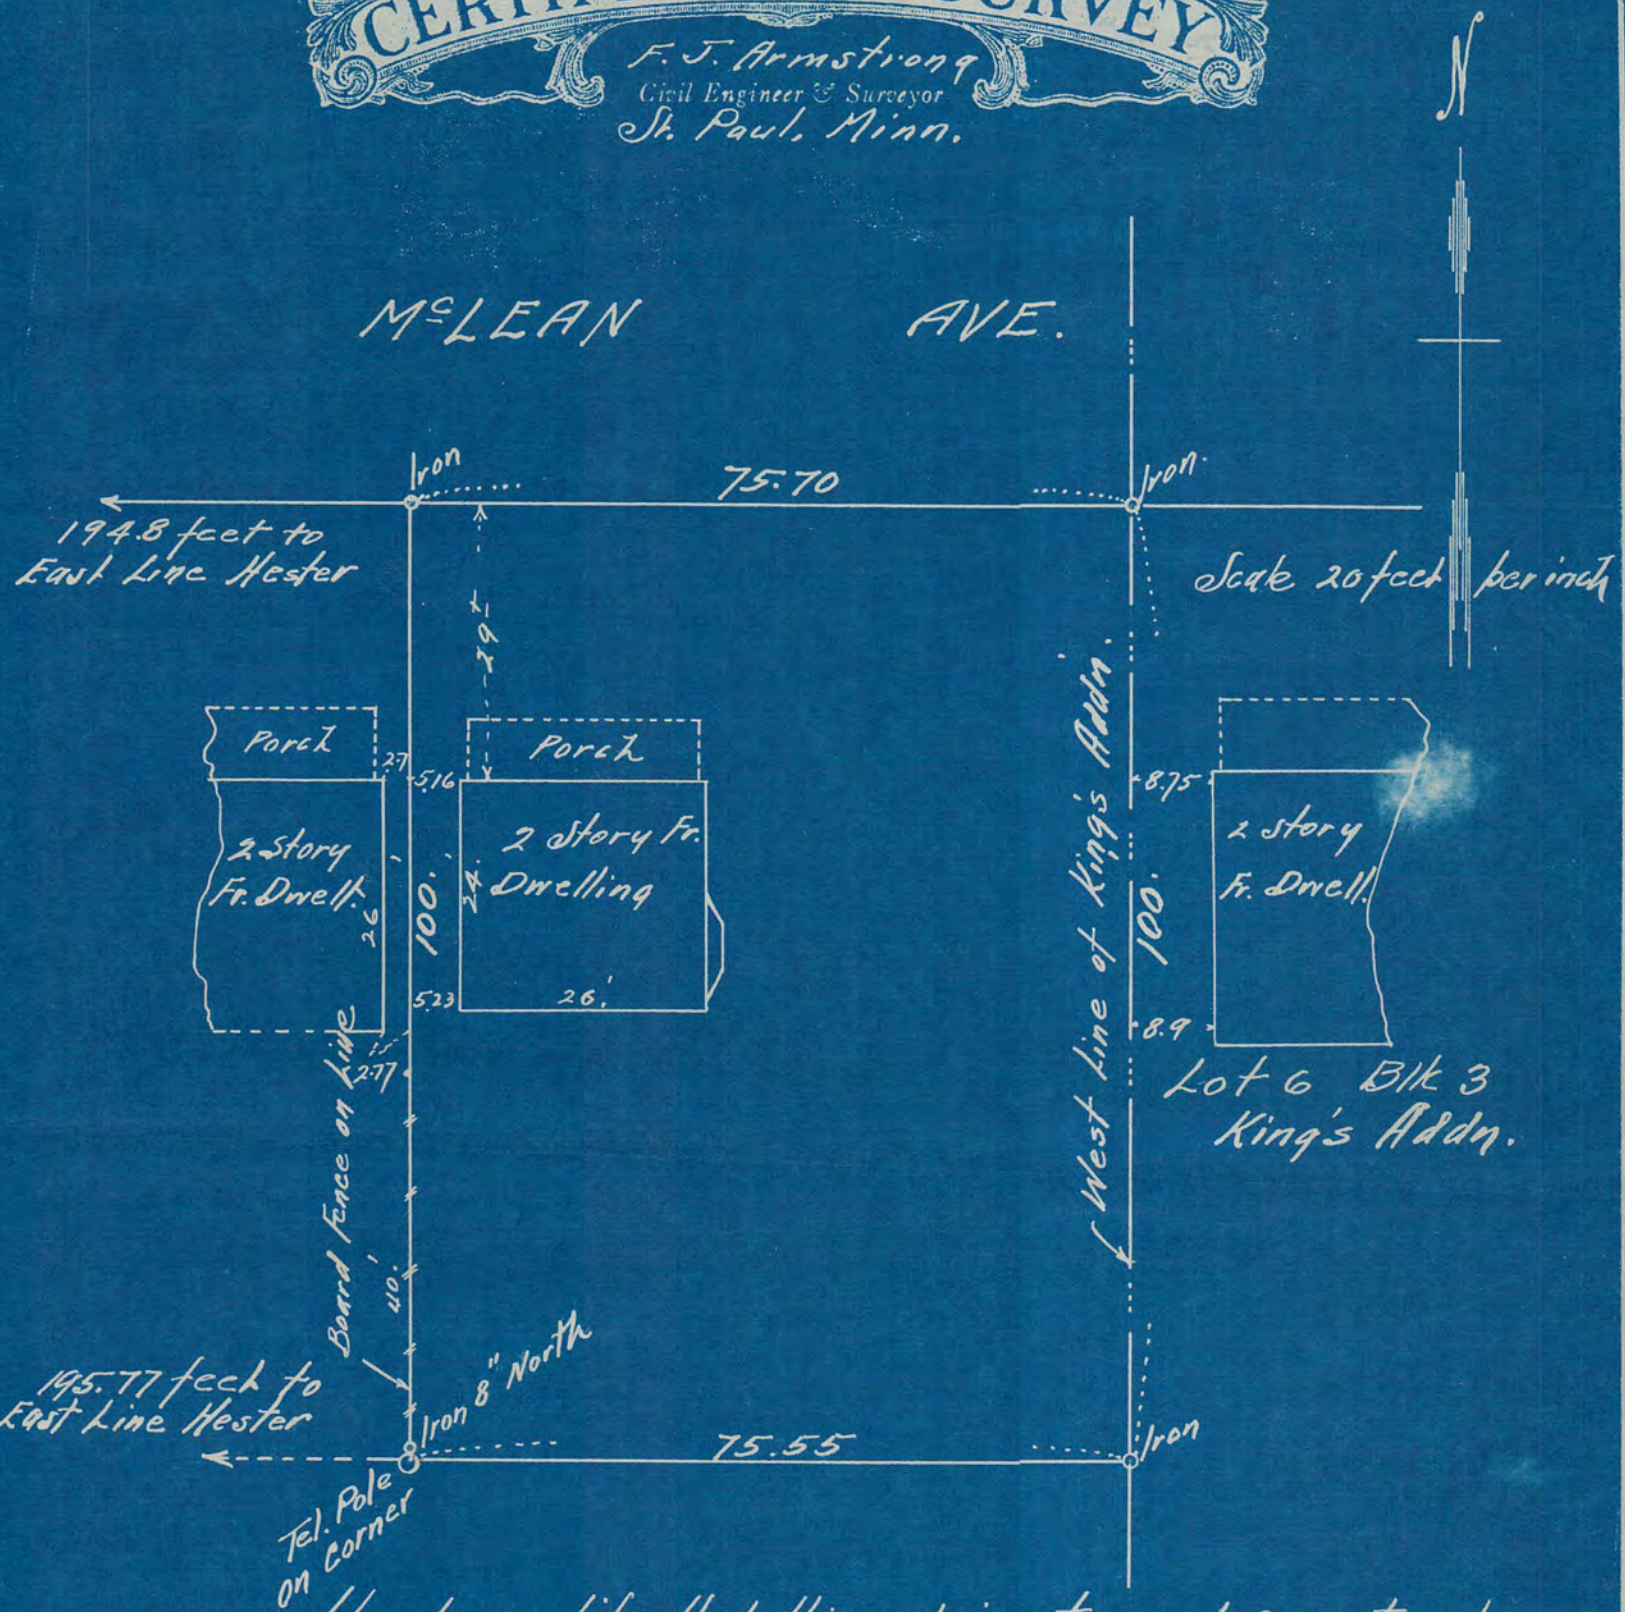

I hereby certify that this map is a true and correct map of the following described property situated in the City of St. Paul, Minn. to wit: Commencing at a point on the south Line of McLean Ave. 194.8 feet east of the east Line of Hester Street; thence south 100 feet to a point 195.77 feet east of the east Line of Hester Street; thence west 75.55 (deed 76.66) feet to the west Line of King's Addn; thence north 100 feet to the south Line of McLean Ave; thence west along the south Line of McLean Ave. 75.70 (Deed 76.45) feet to the place of commencement; as surveyed by me this 13th day of August 1932

F. J. Armstrong
Civil Engr.

Subscribed and sworn to before me this

_____ day of _____, 19____

_____
Notary Public.

My Commission Expires _____

I HEREBY CERTIFY that on the _____ day of _____, A. D. 19____,
I made a survey of the following described property, to-wit: _____

_____

_____

and the map hereon shown is a true and correct map of said survey and that the improvements thereon indicated are correctly shown.

_____
Civil Engineer.

PATENT APPLIED FOR

#3890