


# CERTIFICATE of SURVEY

Franklyn J. Armstrong  
Civil Engineer & Surveyor

St. Paul

Minnesota

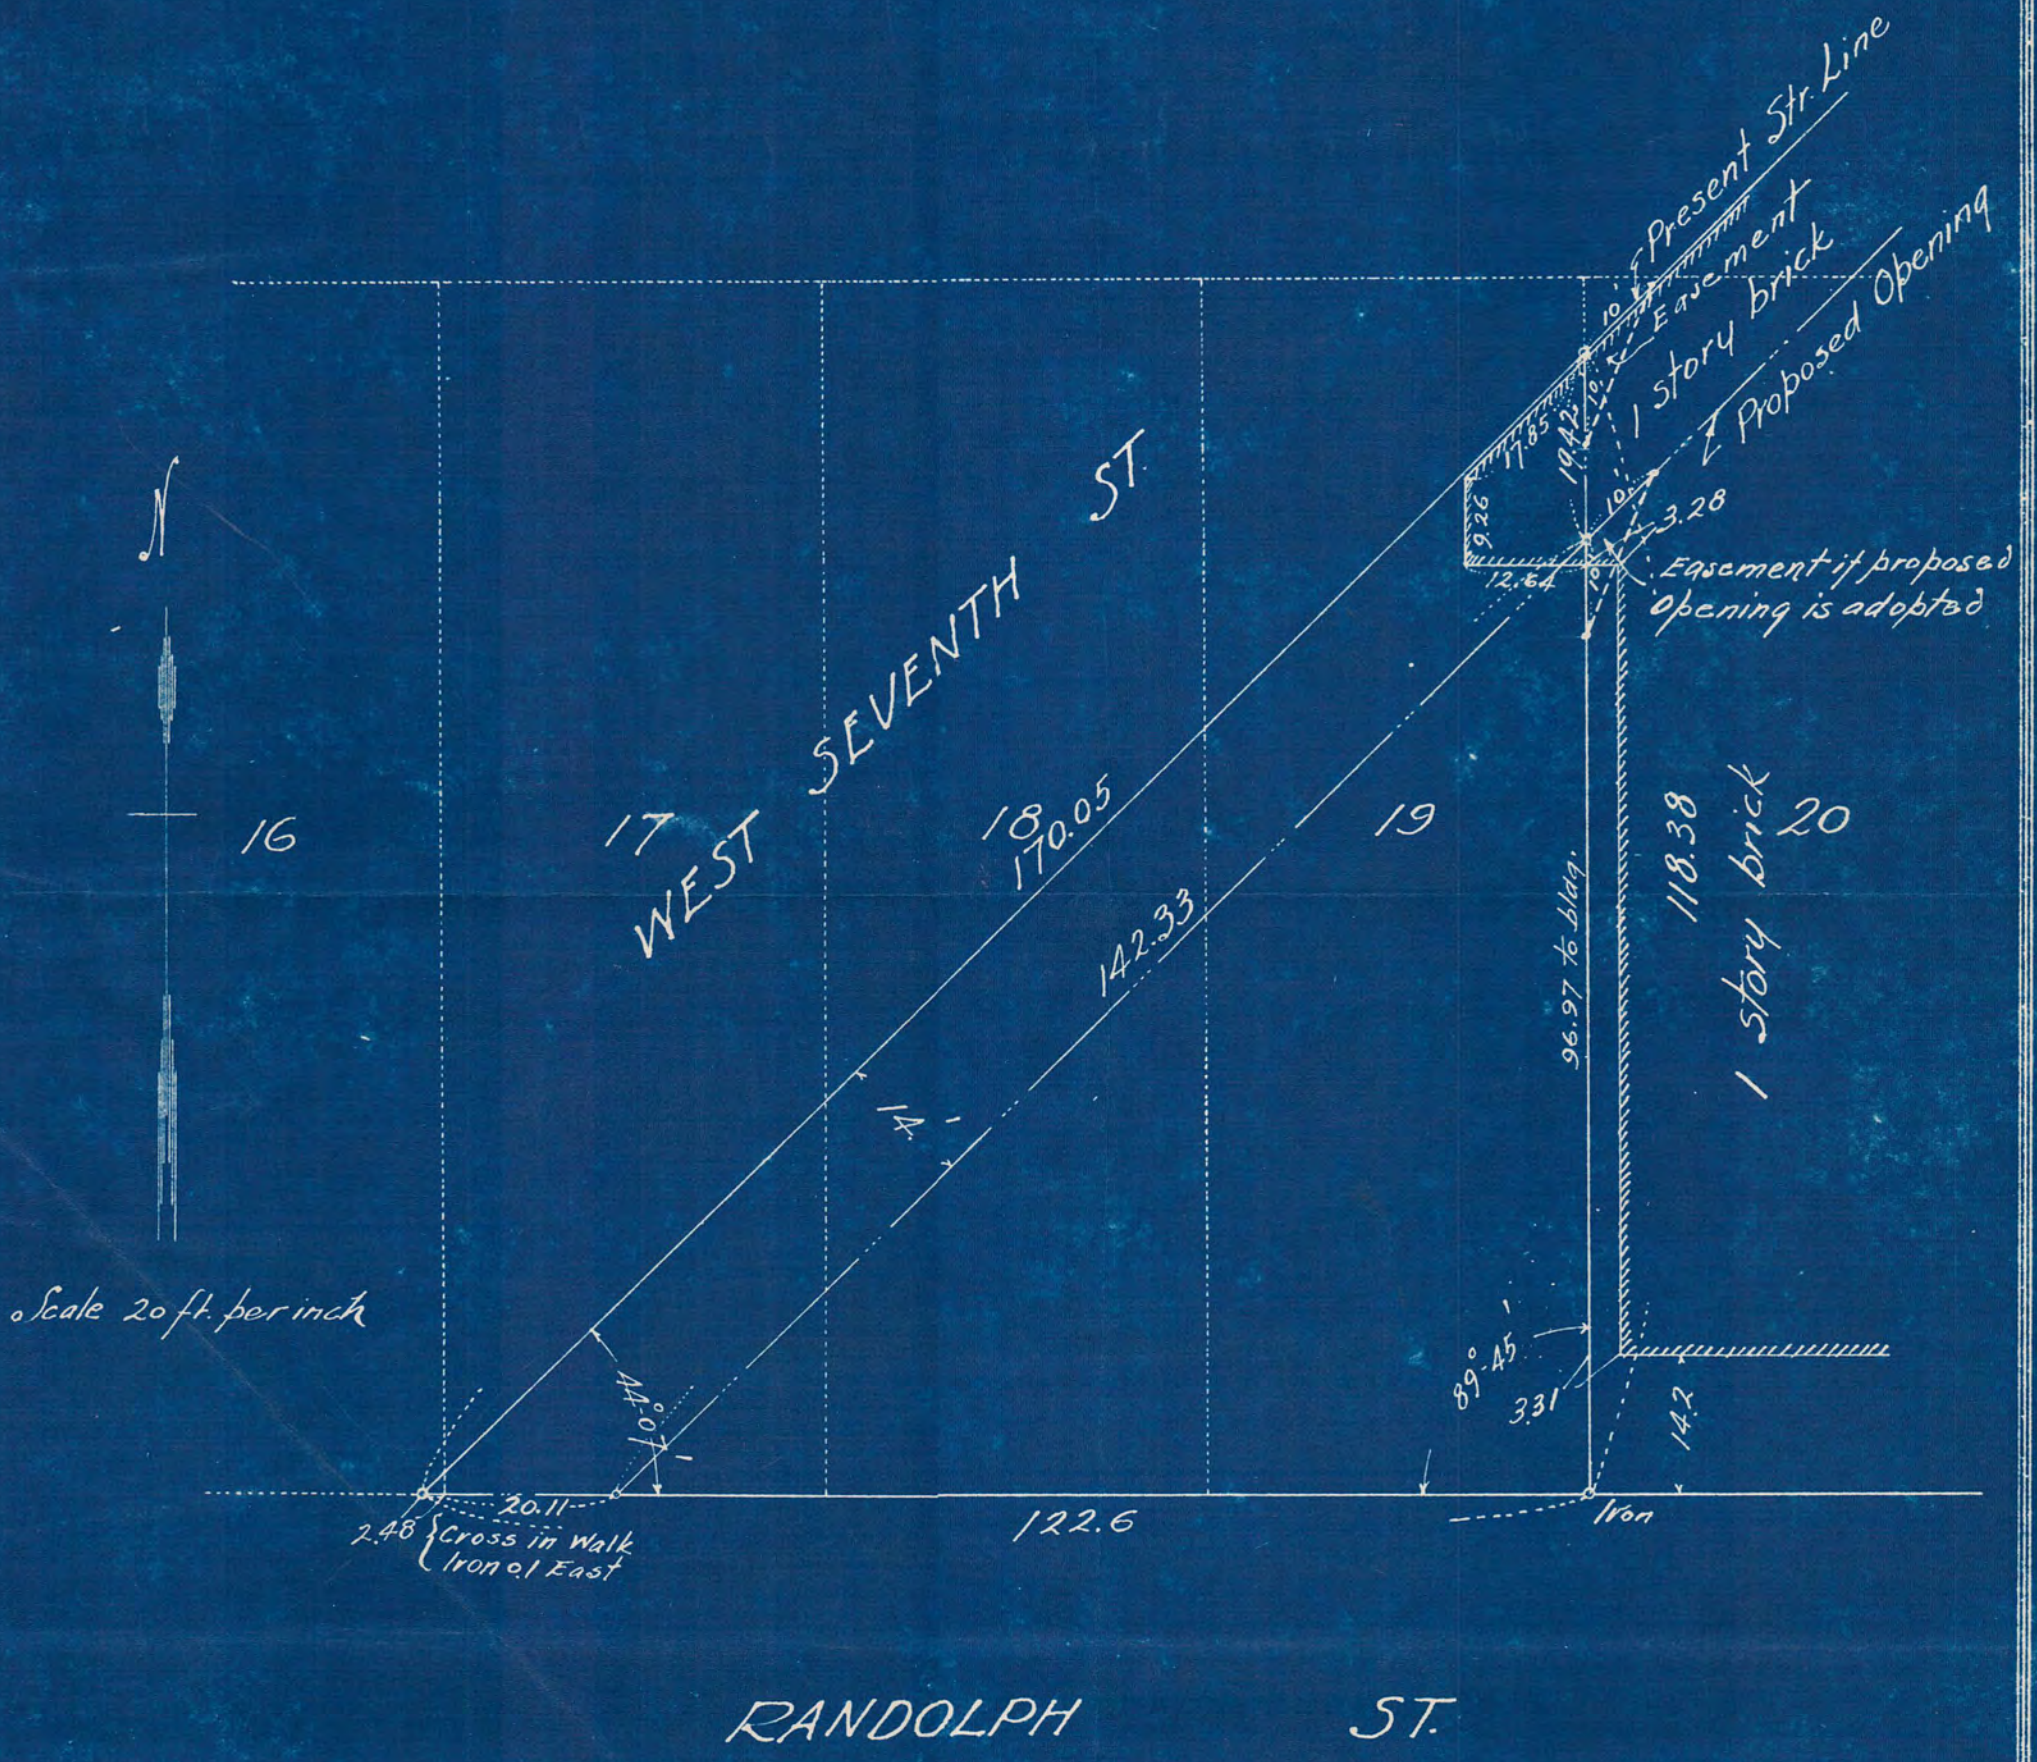

For White Eagle Oil Co.

Subscribed and sworn to before me this \_\_\_\_\_ day of \_\_\_\_\_ 19\_\_\_\_

Notary Public

My Commission Expires \_\_\_\_\_

I hereby certify that on the 18<sup>th</sup> day of November A. D. 1929, I made a survey of the following described property, to wit: Lots 17-18<sup>th</sup> & 19 Block 31 T. Daly's Subdivision of Blks. 18<sup>th</sup> & 31 Stinson, Brown & Ramseys Addition. St. Paul, Minn., lying Sly of 7<sup>th</sup> St. and the map hereon shown is a true and correct map of said survey and that the improvements thereon indicated are correctly shown.

*F. J. Armstrong* Civil Engineer  
F. J. Armstrong

# 3892