

N

ENGINEERING DEPARTMENT C.M. ST. P. & P. R. R. CO.
 PLAT SHOWING Proposed Track
 serving Snell Sash & Door Company.

St. Paul Ramsey Minnesota
 TOWN COUNTY STATE
 SCALE--100 FEET PER INCH JCF

DIVISION ENGINEER'S OFFICE
 MINNEAPOLIS, MINN. DATE Dec. 7, 1940


EXHIBIT "A"

#3901

I hereby certify that this map correctly represents the southerly rail of the spur track across part of Block 6 Boulevard Addition to the City of St. Paul, Minn. as surveyed by me in September 1938

Dated this 27th day of September 1938
 F. J. Armstrong - Civil Engr.

Scale 30 feet per inch

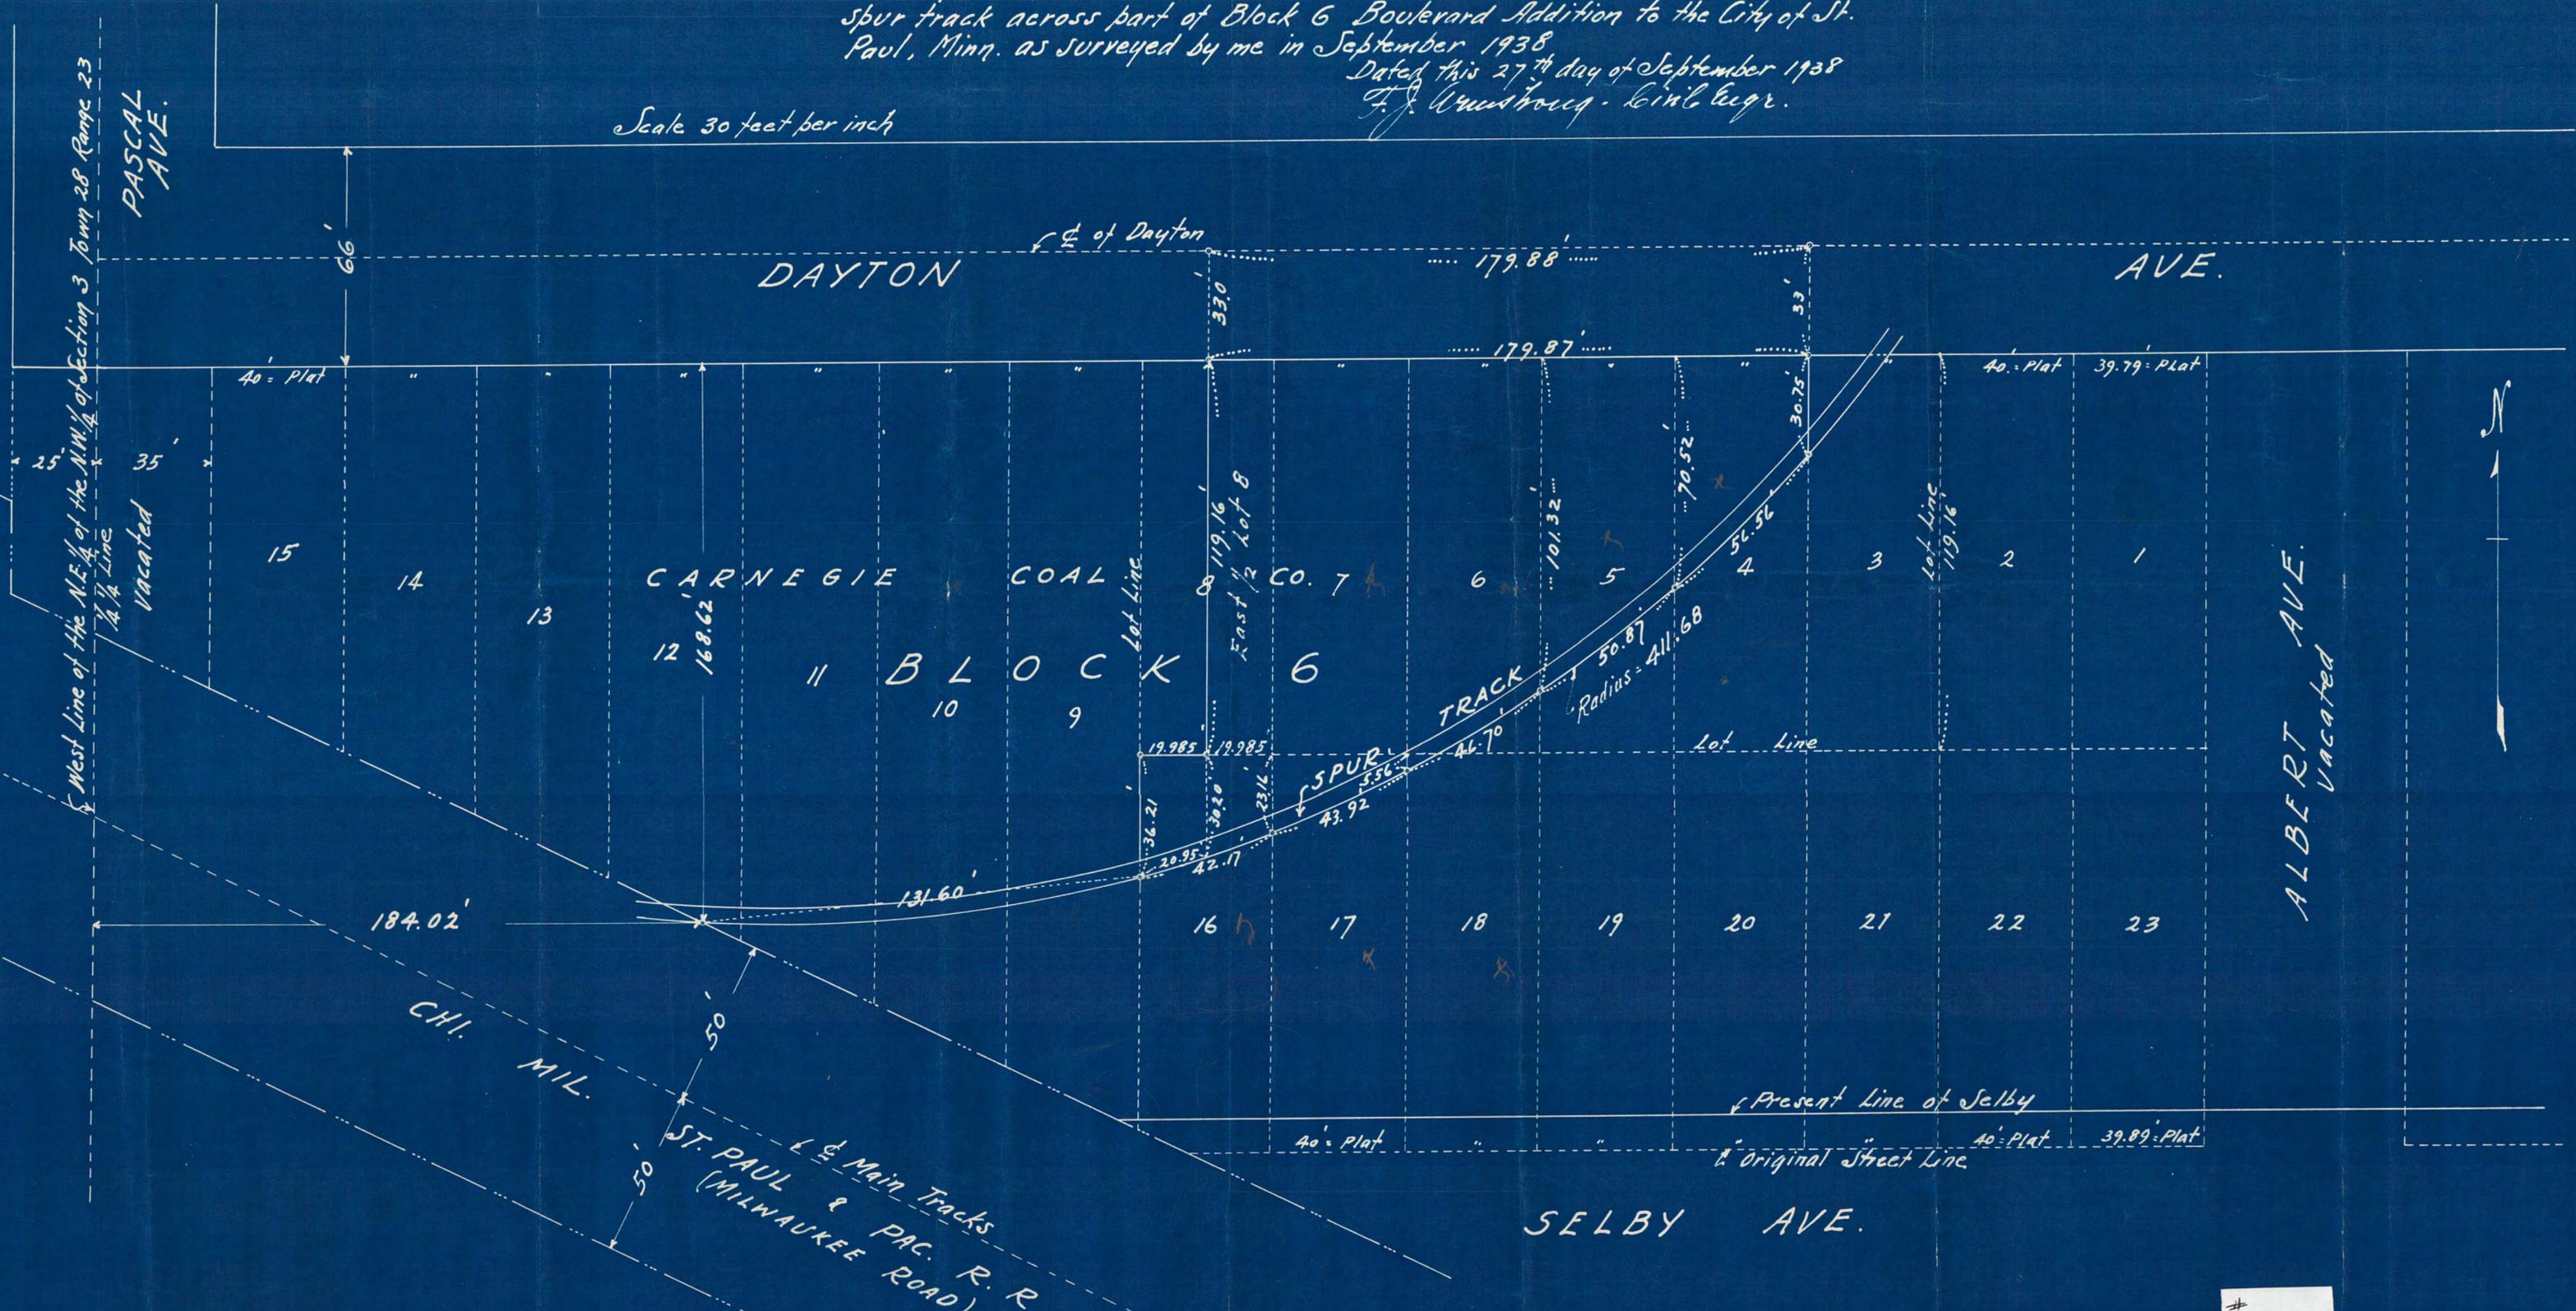

3901