

88933

# LEECH'S ADD.

SURVEY OF


## WEST 39 FT. OF LOT 12 BLOCK 9

THIS SURVEY IS MADE ACCORDING TO RECORD DISTANCE OF 51' 10" (ACCORDING TO RECORDED PLAT) FROM SMITH AVE. ALL DIVIDING FENCES WALLS & C IN ENTIRE BLOCK ARE PLACED ON SAME LINES

SCALE 20 FT = 1 INCH

ST PAUL MINN AUG 4-1933  
I HEREBY CERTIFY TO HAVING SURVEYED THE ABOVE DESCRIBED PROPERTY AND HAVE PLACED IRONS AT THE CORNERS AND ALL DISTANCES AND LOCATIONS AS HEREON SHOWN ARE CORRECT.

*Jens Pedersen*  
SURVEYOR

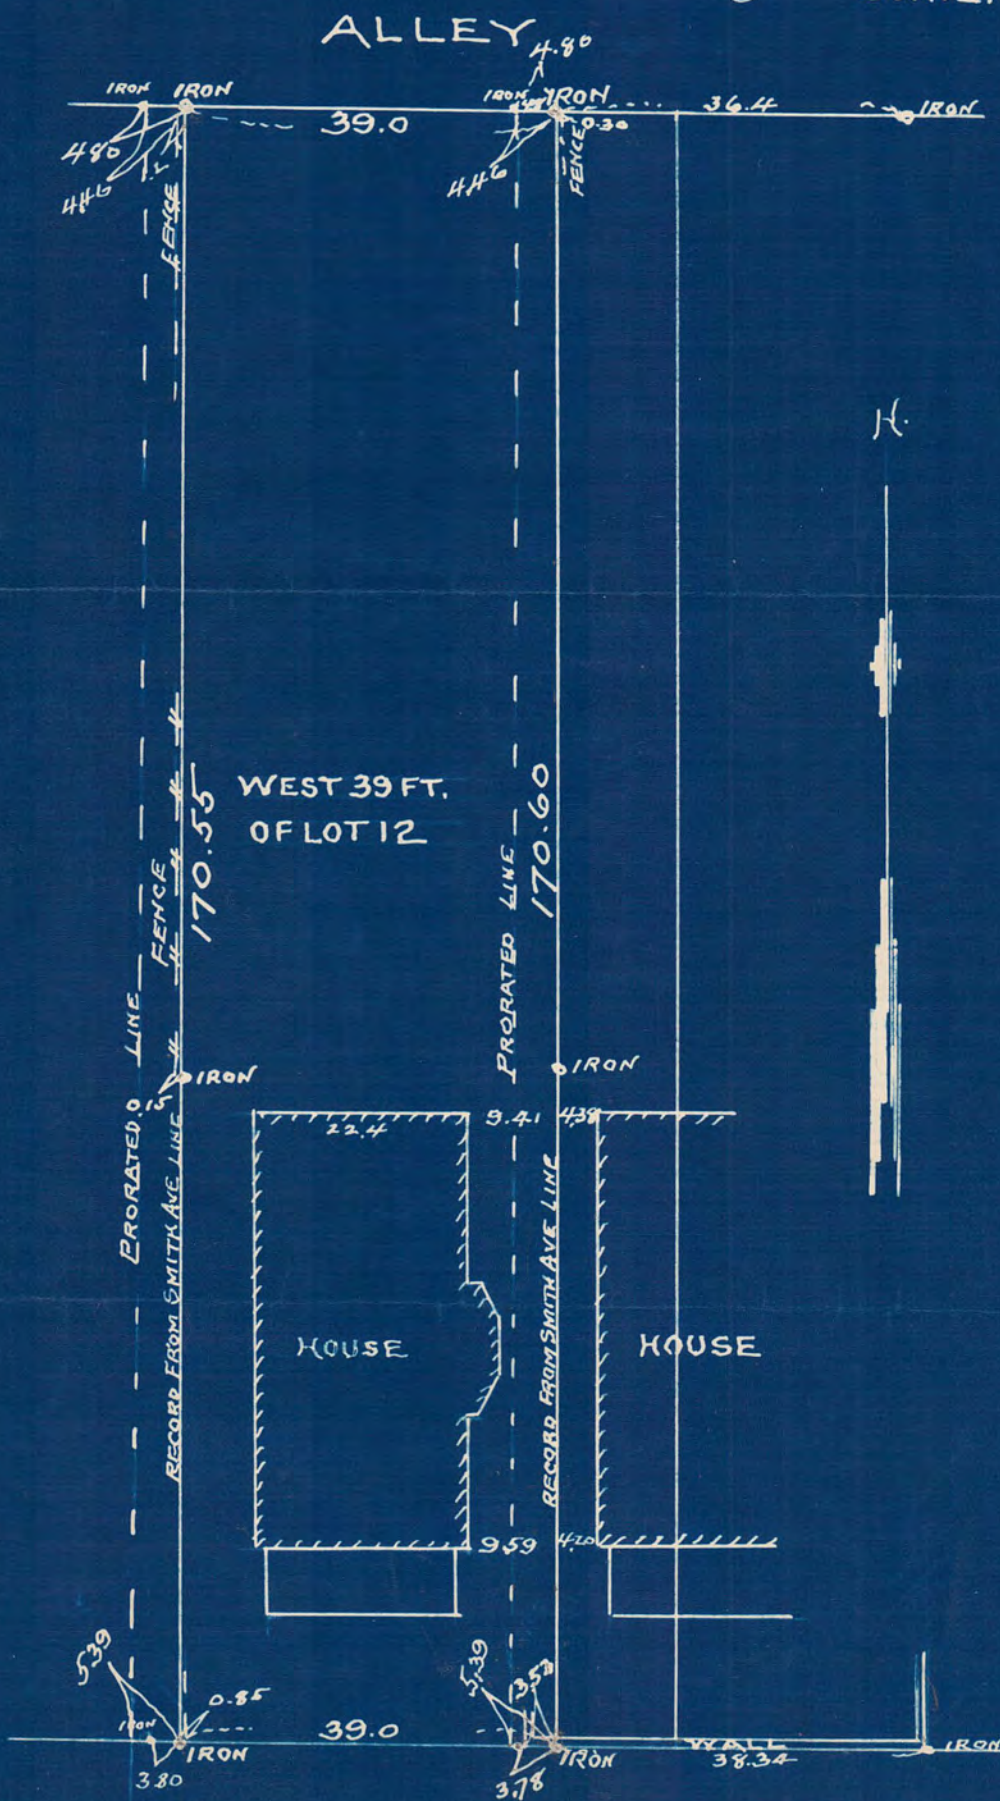

GOODRICK AVE.

#  
3906