

# WEST ST. PAUL PROPER

## SURVEY OF

### LOTS 9 AND 10 EXCEPT WEST 50 FT. BLOCK 126

MORE PARTICULARLY DESCRIBED AS FOLLOWS TO-WIT


COMMENCING AT A POINT ON THE NORTH LINE OF LOT 10 BLOCK 126 WEST ST. PAUL PROPER 50 FT. EAST OF THE NORTHWEST CORNER OF SAID LOT 10 THENCE SOUTH PARALLEL TO THE WEST LINE OF LOTS 9 AND 10  $95\frac{52}{100}$  FT. TO THE SOUTH LINE OF SAID LOT 9 THENCE EAST ALONG THE SOUTH LINE OF SAID LOT 9  $7\frac{81}{100}$  FT. TO THE SOUTHEASTERLY CORNER OF SAID LOT 9 THENCE NORTHEASTERLY ALONG THE EASTERLY LINE OF LOTS 9 AND 10  $102\frac{94}{100}$  FT. TO THE NORTHEASTERLY CORNER OF LOT 10 THENCE WEST ALONG THE NORTH LINE OF SAID LOT 10  $46\frac{91}{100}$  FT. TO POINT OF BEGINNING

Nov 1934

JENS PEDERSEN  
SURVEYOR

SCALE 20 FT. = 1 INCH

ELIZABETH ST.

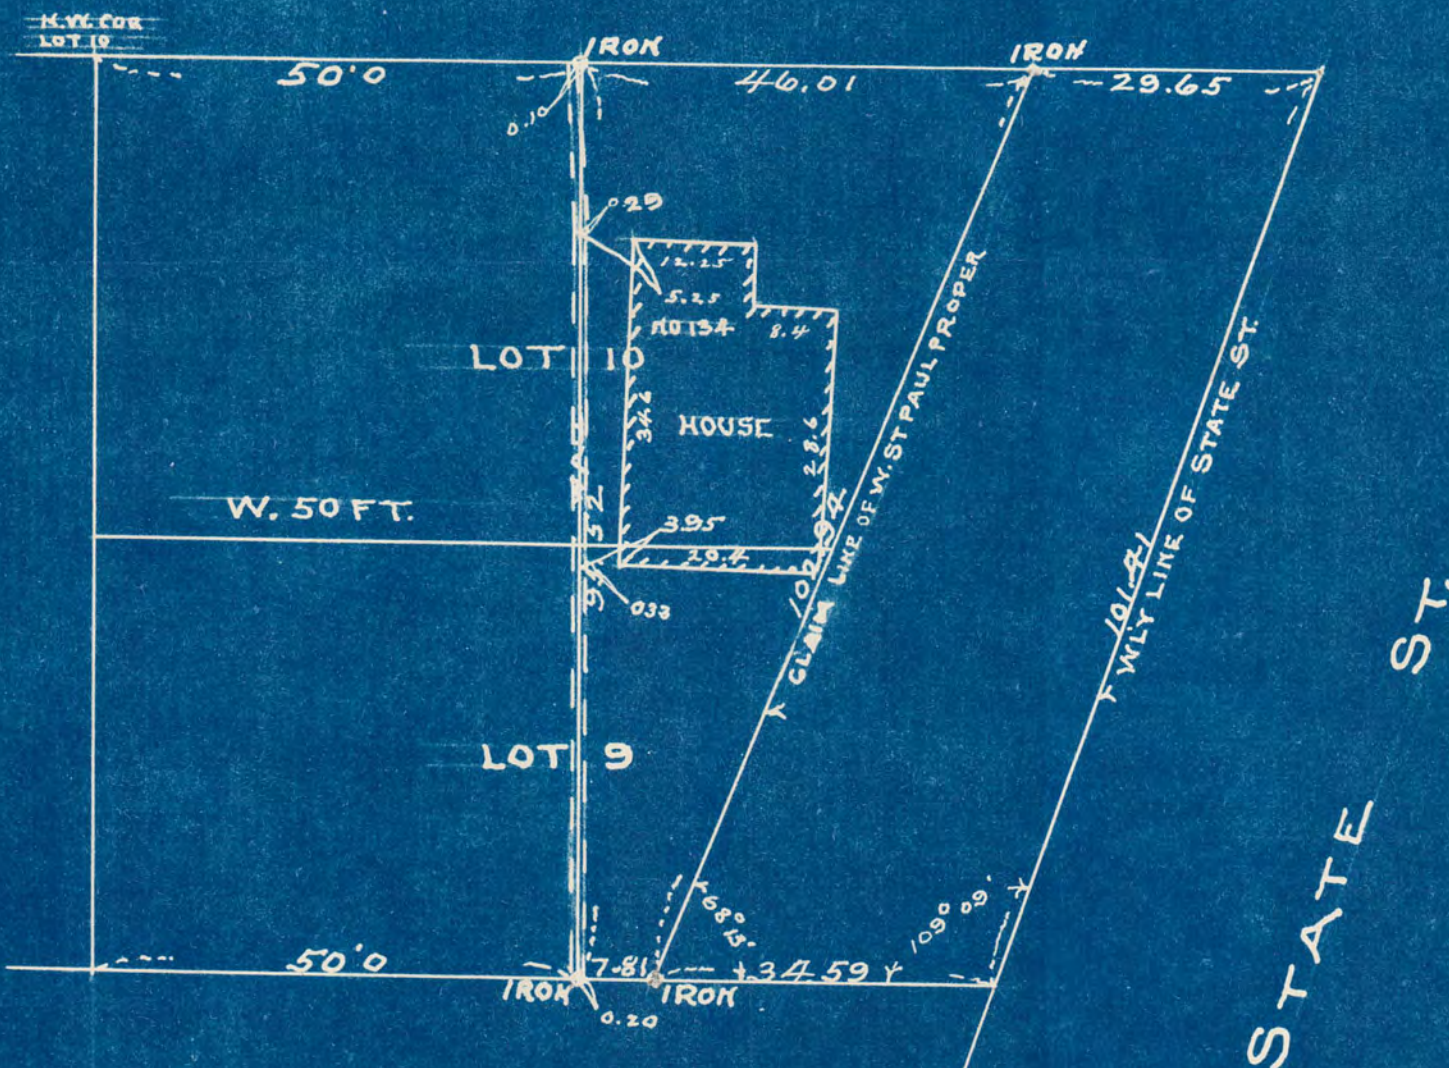

# 3931