


I hereby certify that this map correctly represents Lot 15 and the north 2 feet of Lot 16 in Kuhn's Subdivision of a part of Lafonds Addition to St. Paul; as surveyed by me in September 1936

Dated this 21st day of September 1936

F. J. Armstrong - Civil Engr.

Scale 10 feet per inch

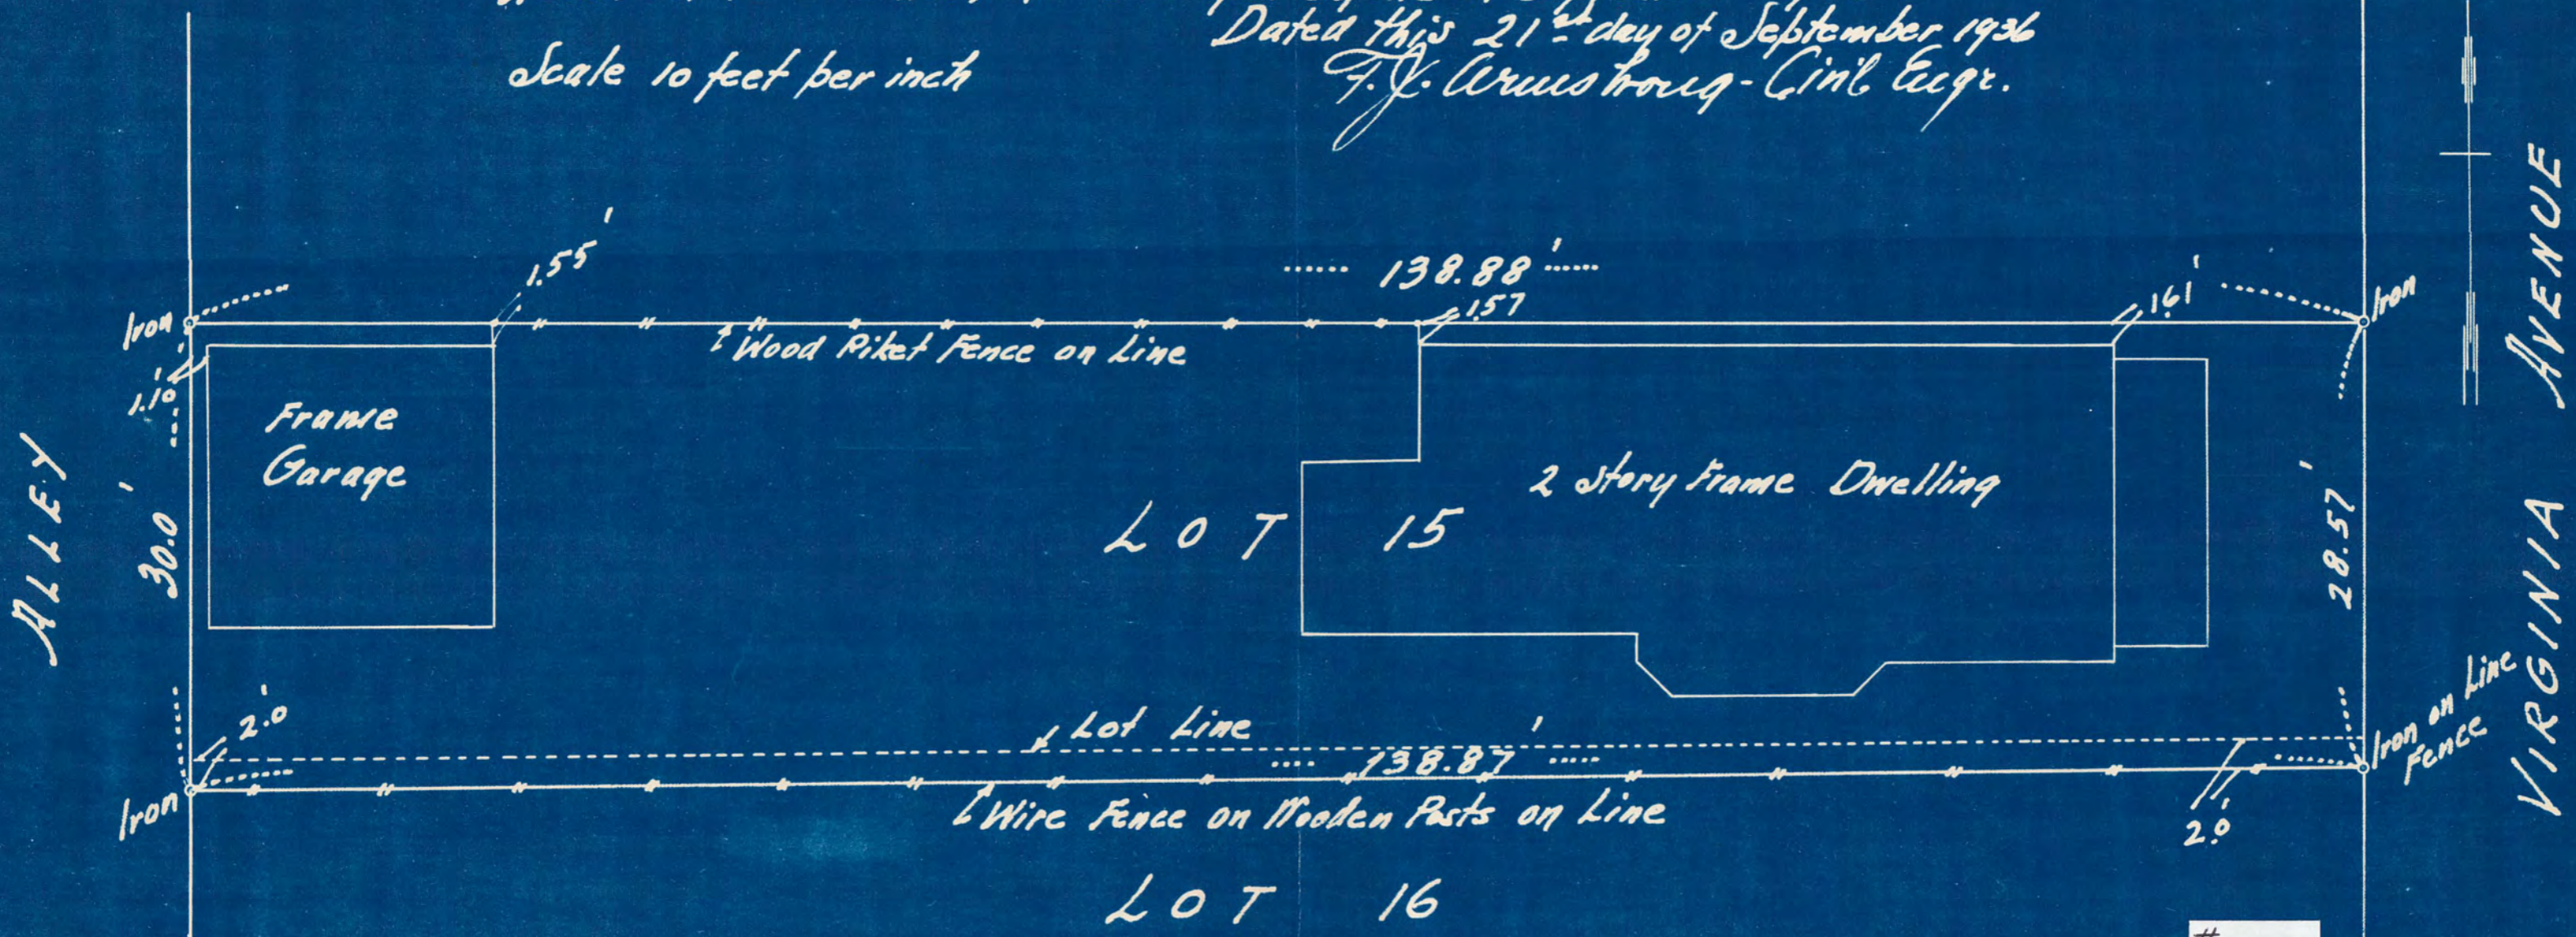

3963