


SURVEY OF LOTS 25-26 & 27 BLOCK 4 KIDD'S REA.
OF BLOCKS 5 & 6 HALDEMAN'S ADDN. ST. PAUL, MINN.

Scale 20 ft. per inch

June 11th 1936
St. Paul, Minn.

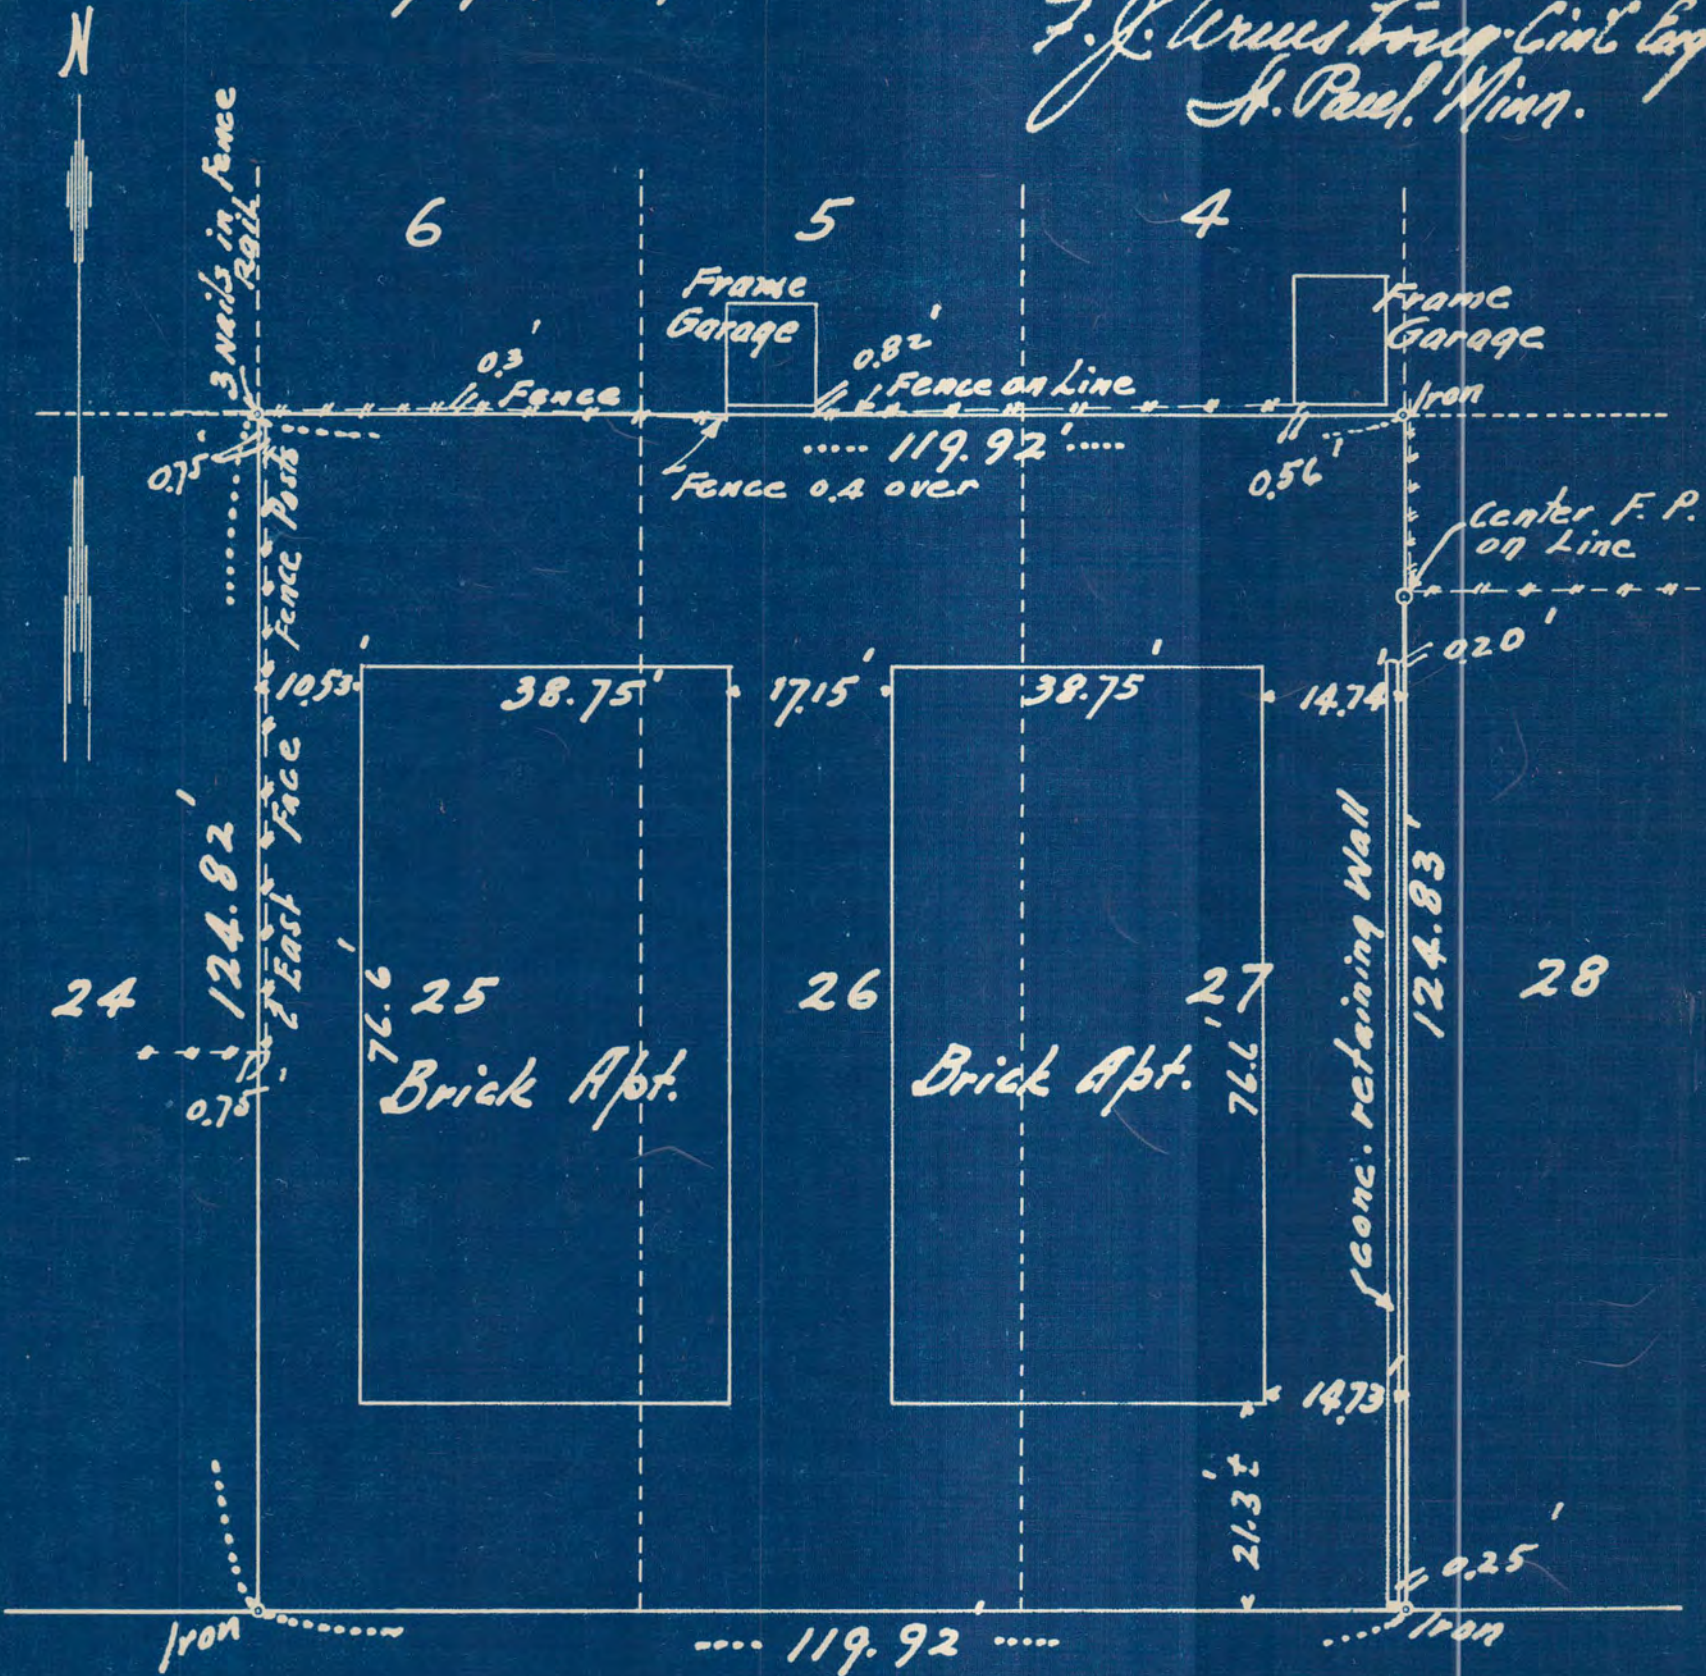

ST. CLAIR ST.

Note: Lots 25-26-27 are recorded as 40 ft. in width

3973