

4007

# WHITACRE BRISBON AND MULLINS SUB. OF LEECH'S ADDITION OF OUT LOTS

SURVEY OF W. 1/2 LOT 52 & E. 1/2 LOT 53.


May 10, 1937

Jens Pedersen

SCALE 1 IN. = 20 FT.

Surveyor

## LISBON ST.

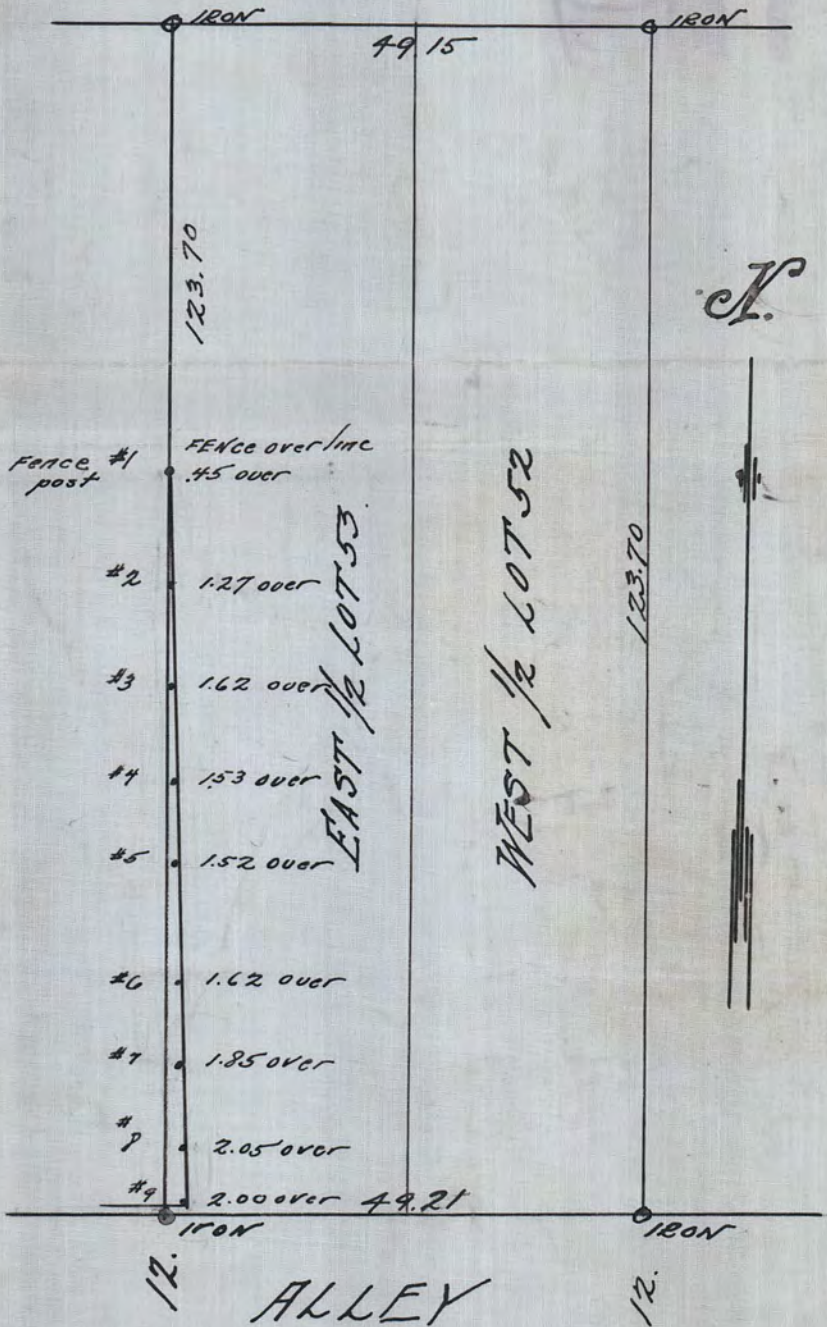

# 4007