


OAKRIDGE

RAMSEY CO. MINN.

LOT 8

DEC. 1939

SCALE
1 IN. = 20 FT.

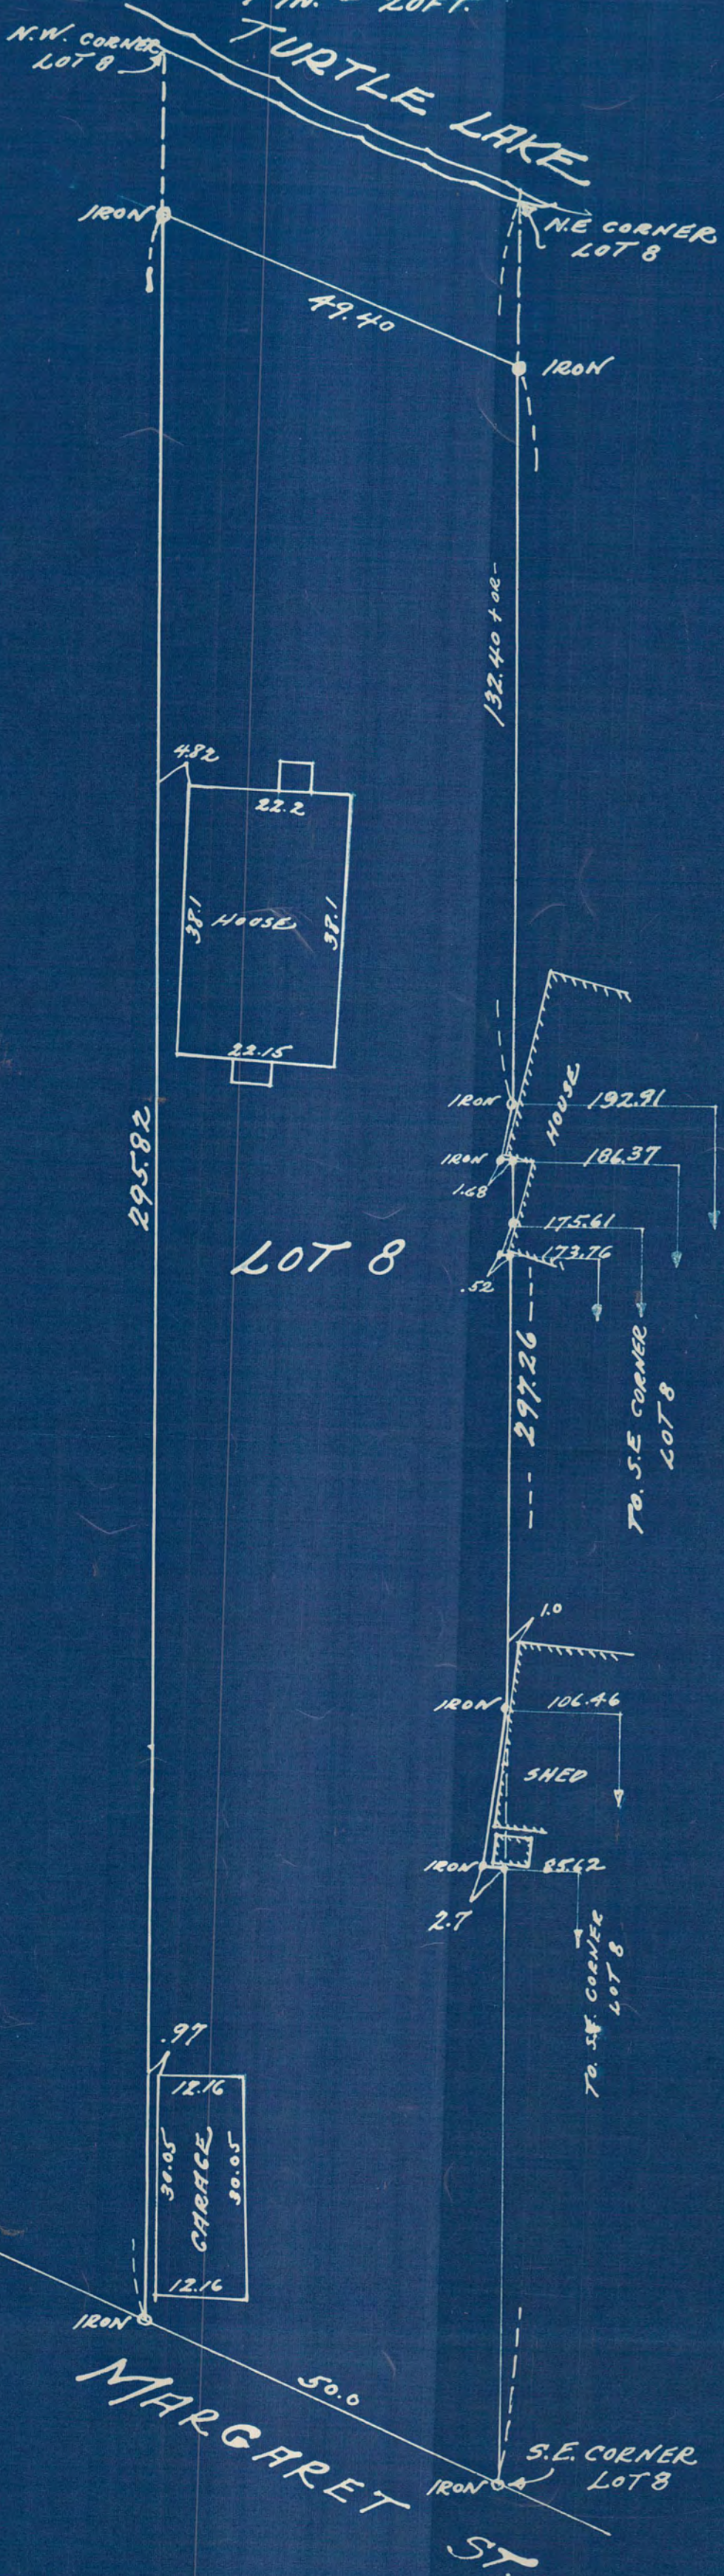

STATE OF MINNESOTA
COUNTY OF RAMSEY

4021

DISTRICT COURT
SECOND JUDICIAL DISTRICT

In Re. Application of
Harry K. Lieberman, to register
the title to land,

Applicant,

vs.

F. J. Metzger and Mary Metzger,
his wife; Emma S. Ellison and
Jay T. Ellison, her husband,
and all other persons etc.

Defendants.

JUDGMENT AND DECREE

FILED

DEC 23 1939

W. C. ROBINSON, Clerk

By *[Signature]* Deputy

G. W. MANTOR
ATTORNEY-AT-LAW
PIONEER BUILDING
ST. PAUL, MINNESOTA