

ABSTRACT OF TITLE

Prepared by The St. Paul Abstract Company

No. 1

To

Lot 14 Auditor's Subdivision No. 43 Ramsey Co., Minn.

State of Minnesota }


County of Ramsey }

The St. Paul Abstract Company does hereby certify that the following exhibit, consisting of 8 sheets, from 1 to 8 inclusive (each of which bears its Corporate Seal), and 43 entries from 1 to 43 inclusive, is a true and complete Abstract of Title to the real estate described in No. 1 hereof, as shown by the records in the office of the Register of Deeds in and for said County and State, up to this 12th day of August 1921 at 8 o'clock A. M.

THE ST. PAUL ABSTRACT COMPANY
ABSTRACTERS.

Henry C. Toucheray
TREASURER
VICE-PRESIDENT

-2-

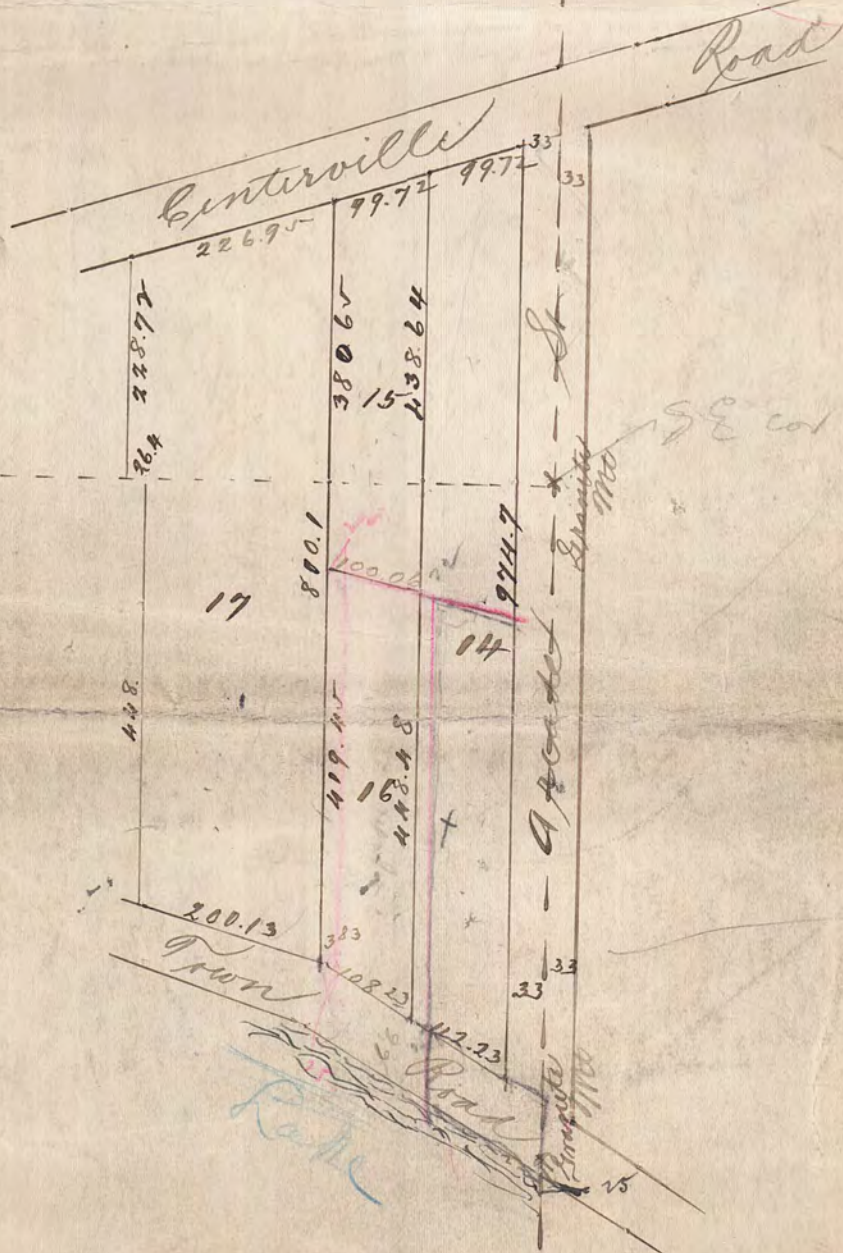

4033

No. 1

4033

