

# CERTIFICATE OF SURVEY

SURVEY OF  
A 5 FT. STRIP OF LAND LYING EASTERLY OF AND ADJOINING  
LOTS 1-2-3, BLOCK 13, OLIVER'S ADDITION TO WEST ST. PAUL AND  
LYING WESTERLY OF AND ADJOINING LOTS 25-26-27, BLOCK 5,  
DAWSON'S ADD. TO ST. PAUL.


Subscribed and sworn  
to before me this 19 day  
of April, A.D. 1938  
D. B. Reay.

NOTARY PUBLIC, RAMSEY CO. MINN.  
MY COMMISSION EXPIRES Aug 15, 1939

SCALE 1 INCH = 30 FT.

ST. PAUL, MINN. APRIL 18, 1938  
I certify to having surveyed  
the above described property and  
that all distances and location  
as hereon shown are correct.

J. L. Johnson  
SURVEYOR  
210 GLOBE BLDG.

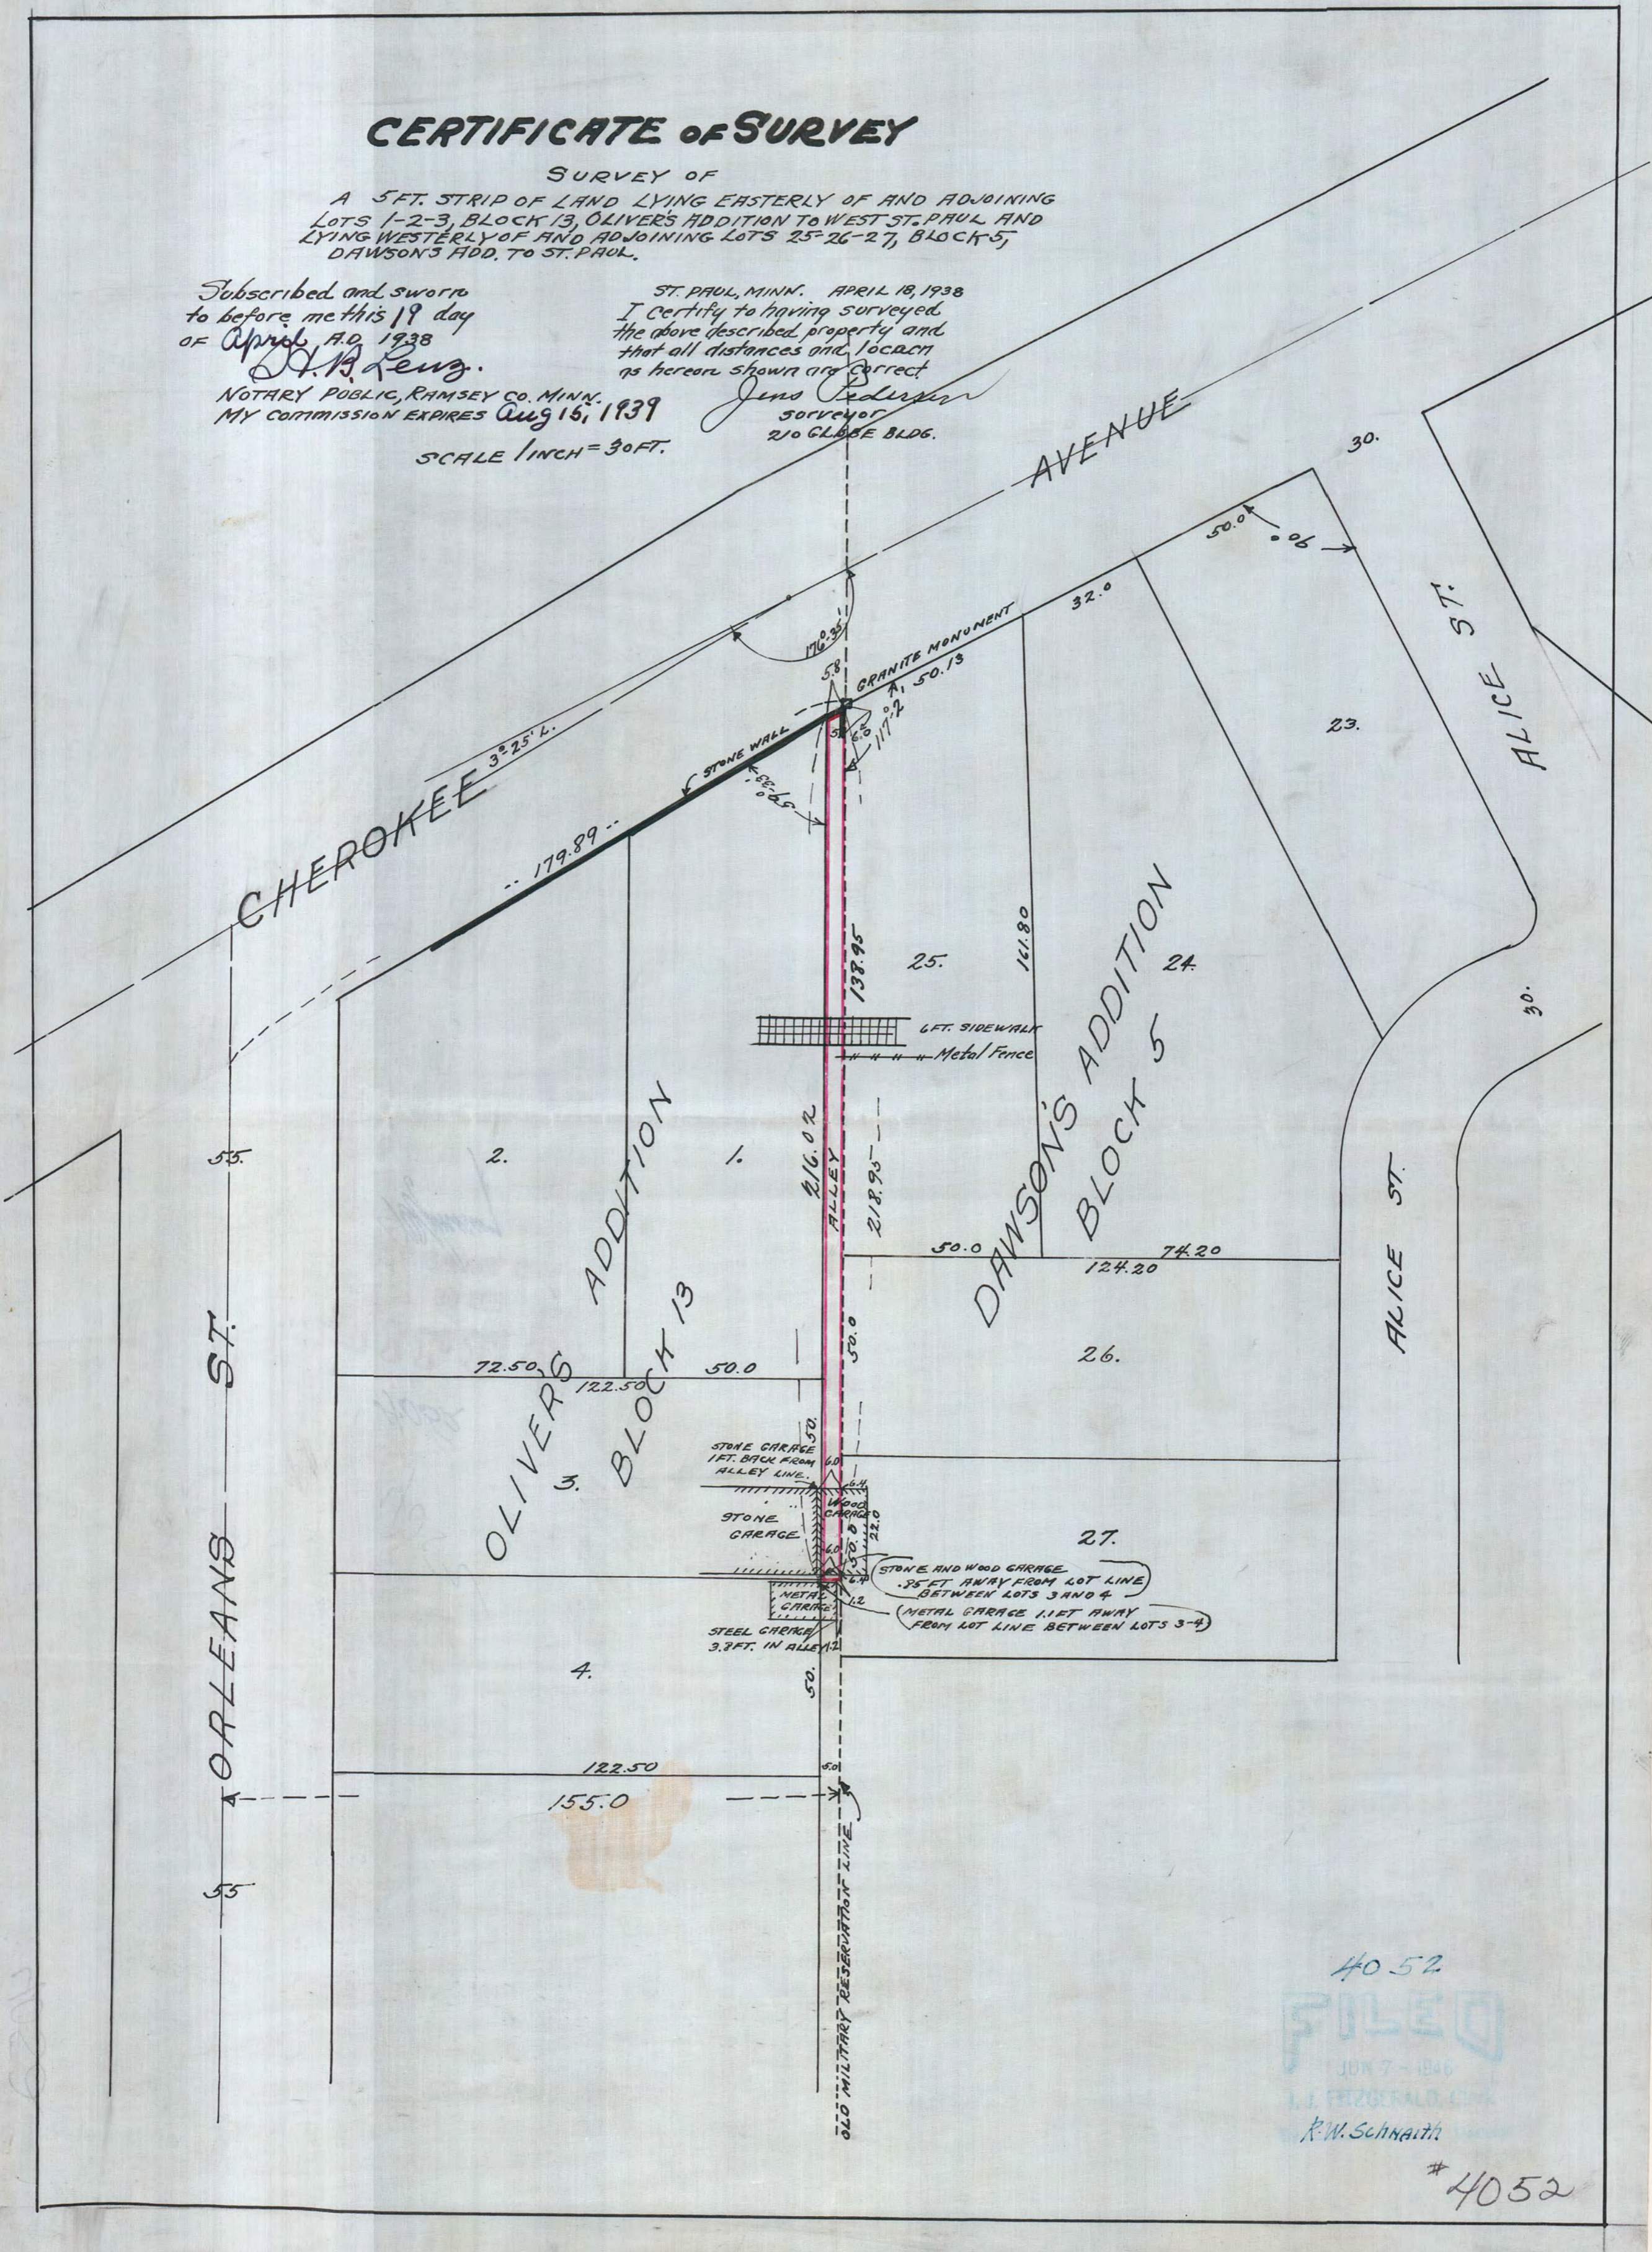

4052  
FILED  
JUN 7 - 1938  
L. J. FITZGERALD, CLERK  
R. W. Schnaith

# 4052