

4082

ABSTRACT OF TITLE

Prepared by The St. Paul Abstract and Title Guarantee Company

No. 1

To Lot 10, Block 25, Merriams Rearrangement of Blocks 24, 25, 26, 27, 28 & 29 Merriam Park

State of Minnesota }
County of Ramsey }

The St. Paul Abstract and Title Guarantee Company does hereby certify that the following exhibit, consisting of 17 sheets, from 1 to 17 inclusive (each of which bears its Corporate Seal), and 117 entries from 1 to 117 inclusive, is a true and complete Abstract of Title to the real estate described in No. 1 hereof, as shown by the records in the office of the Register of Deeds in and for said County and State, up to this 20th day of May, 1938, at 8 o'clock A.M.

St. Paul Abstract AND TITLE Company
Guarantee


ABSTRACTERS

H. J. ...

AN AUTHORIZED SIGNATURE

-2-

4082

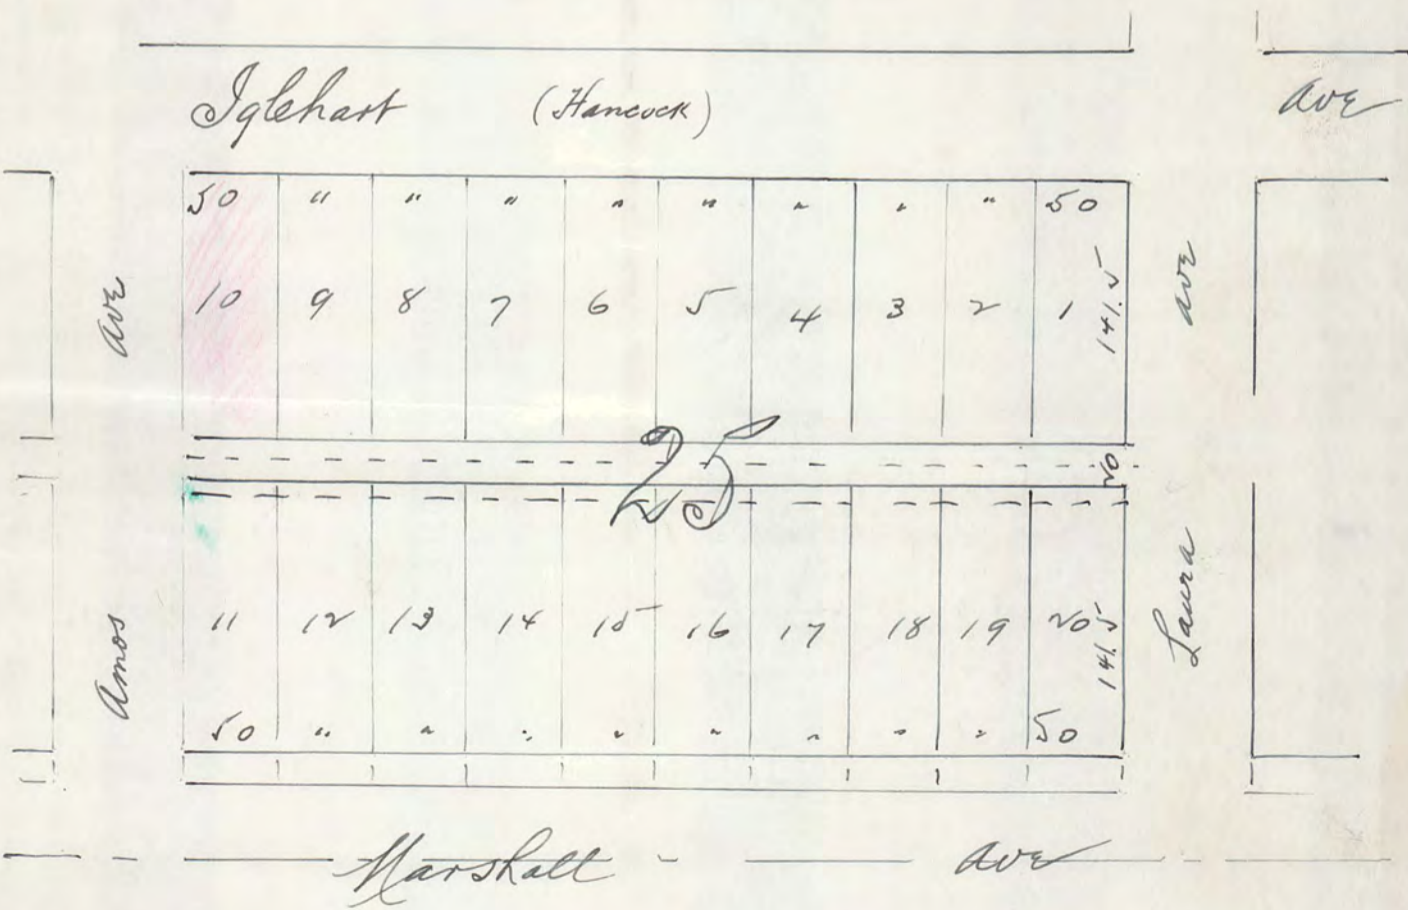

No. 1

#4082

CERTIFICATE OF SURVEY

LOT 10, - BLOCK 25, MERRIAM'S RE.-AR.
OF BLOCKS 24-29 MERRIAM PARK
SCALE 1/IN. = 20 FT.

Subscribed and sworn to
before me this 10 day
of Nov. 1938 A.D.

H. B. Lang

Notary Public, Ramsey Co. Minn.
My Commission Expires Aug 15-1939


St. Paul, Minn Nov. 1938
I certify to having surveyed
the above described property
and that all distances and
measurements and locations
as hereon shown are
correct

Gene Peterson
Surveyor
210 GLOBE BLDG.

IGLEHART AVE.

66.

HOWELL AVE.

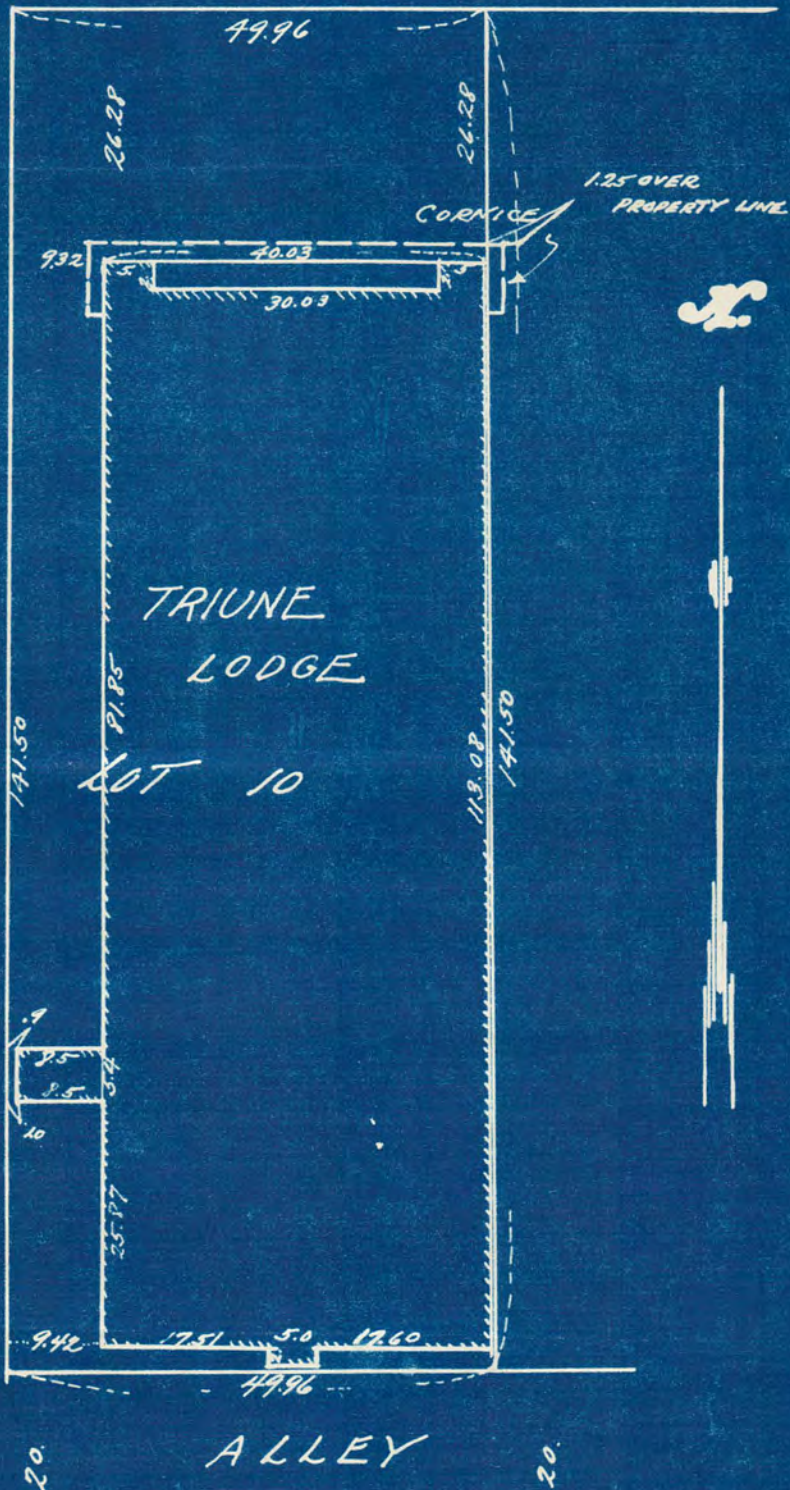

4082