3108

BUILDING PLANS
AND SPECIFICATIONS

CITY LOT SURVEYING
PLATTING
FARM SURVEYING

M. J. BERSCHEID
ARCHITECT AND ENGINEER
PHONE DREXEL 4593
3644-22ND AVENUE SOUTH
MINNEAPOLIS, MINNESOTA

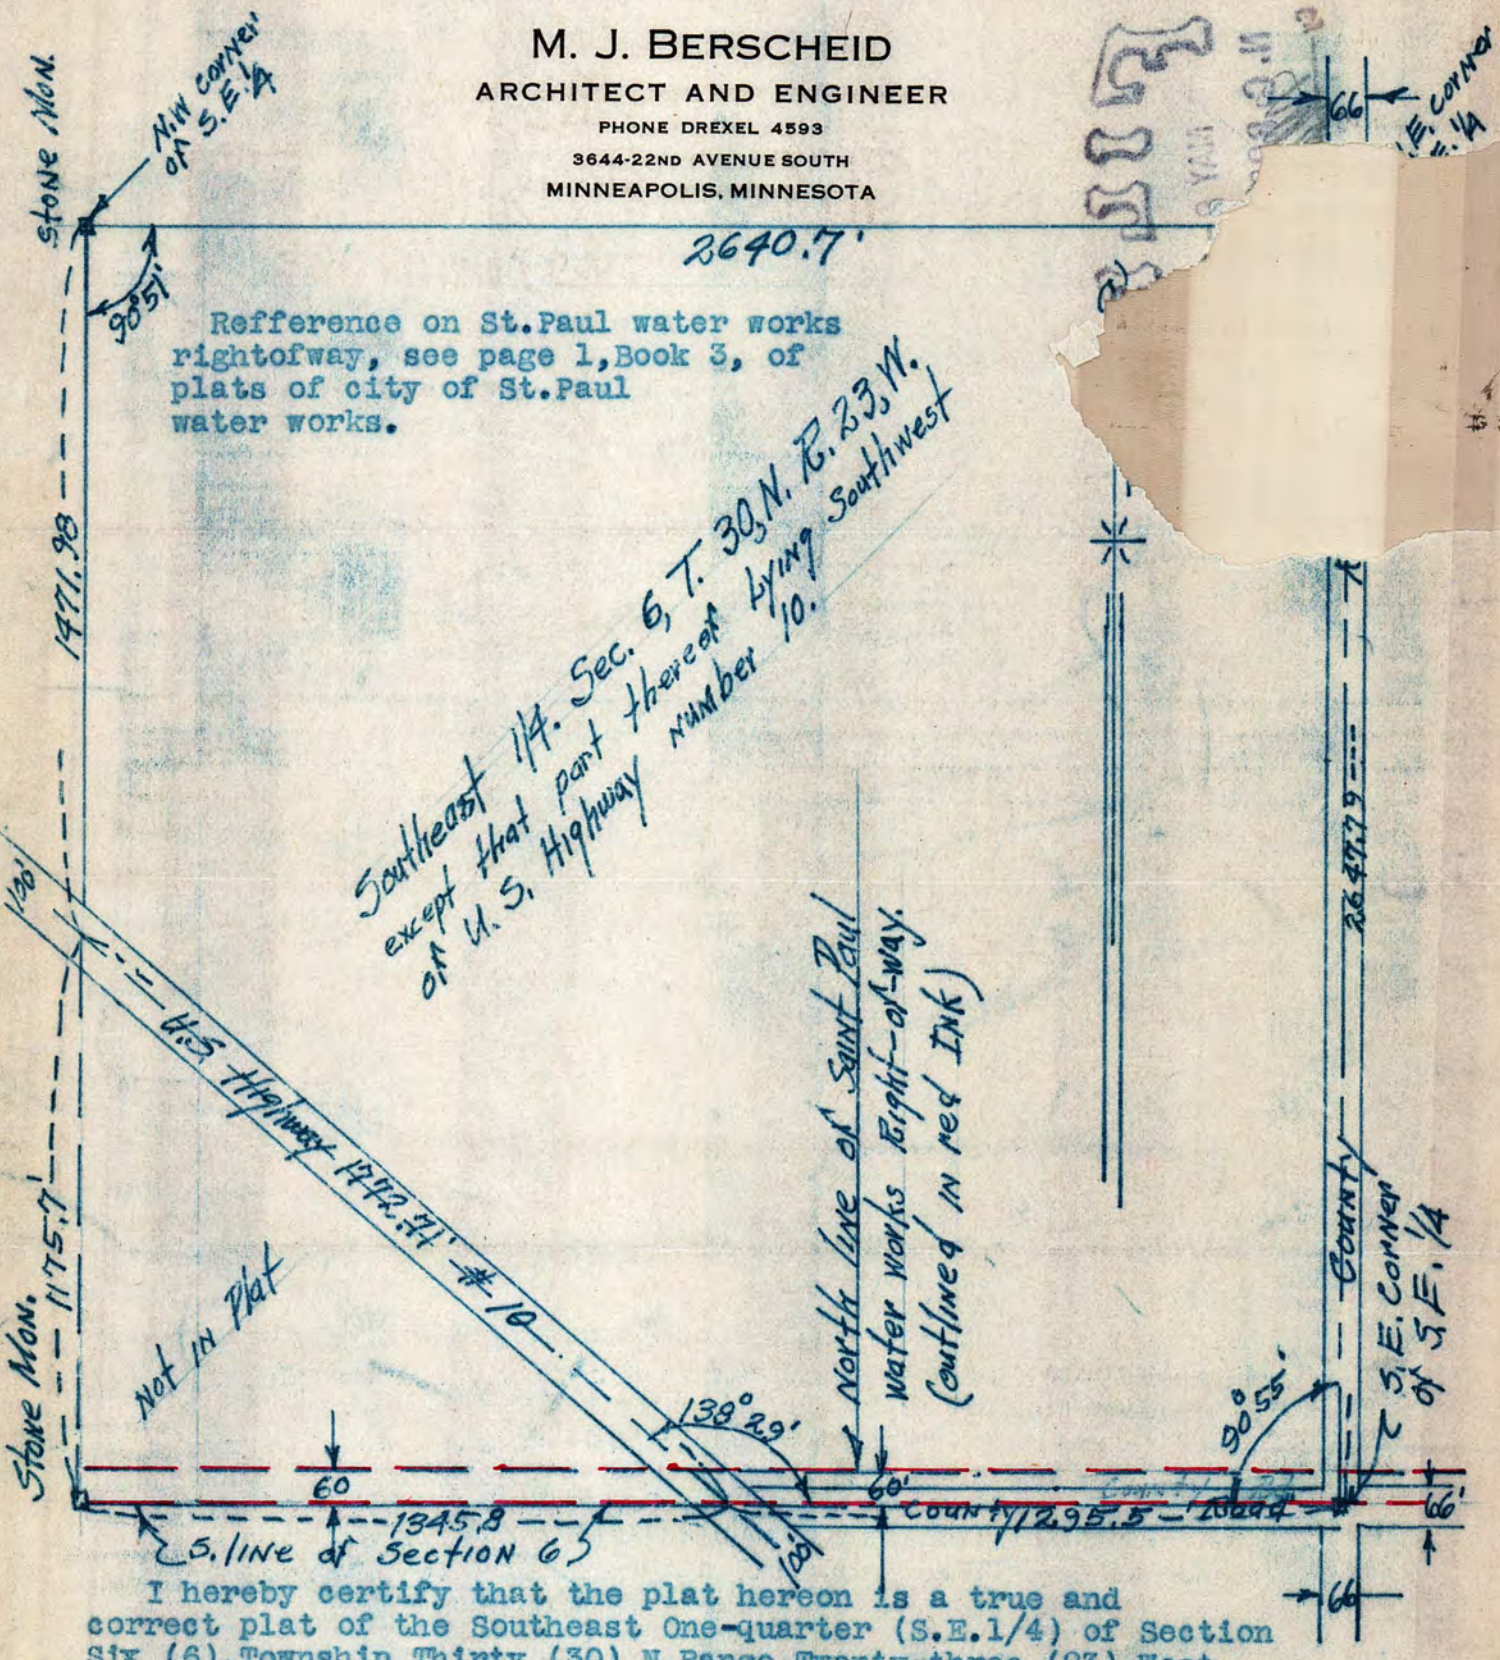

I hereby certify that the plat hereon is a true and correct plat of the Southeast One-quarter (S.E.1/4) of Section Six (6), Township Thirty (30) N. Range Twenty-three (23) West. except that part thereof lying Southwesterly of U.S. Highway number Ten (10), as surveyed by me.

M. J. Berscheid.
Registered land surveyor.
(Minn.) #1359.

4187