


CERTIFICATE of SURVEY

F. J. ARMSTRONG
Civil Engineer and Surveyor
ST. PAUL, MINN.

4029
4209

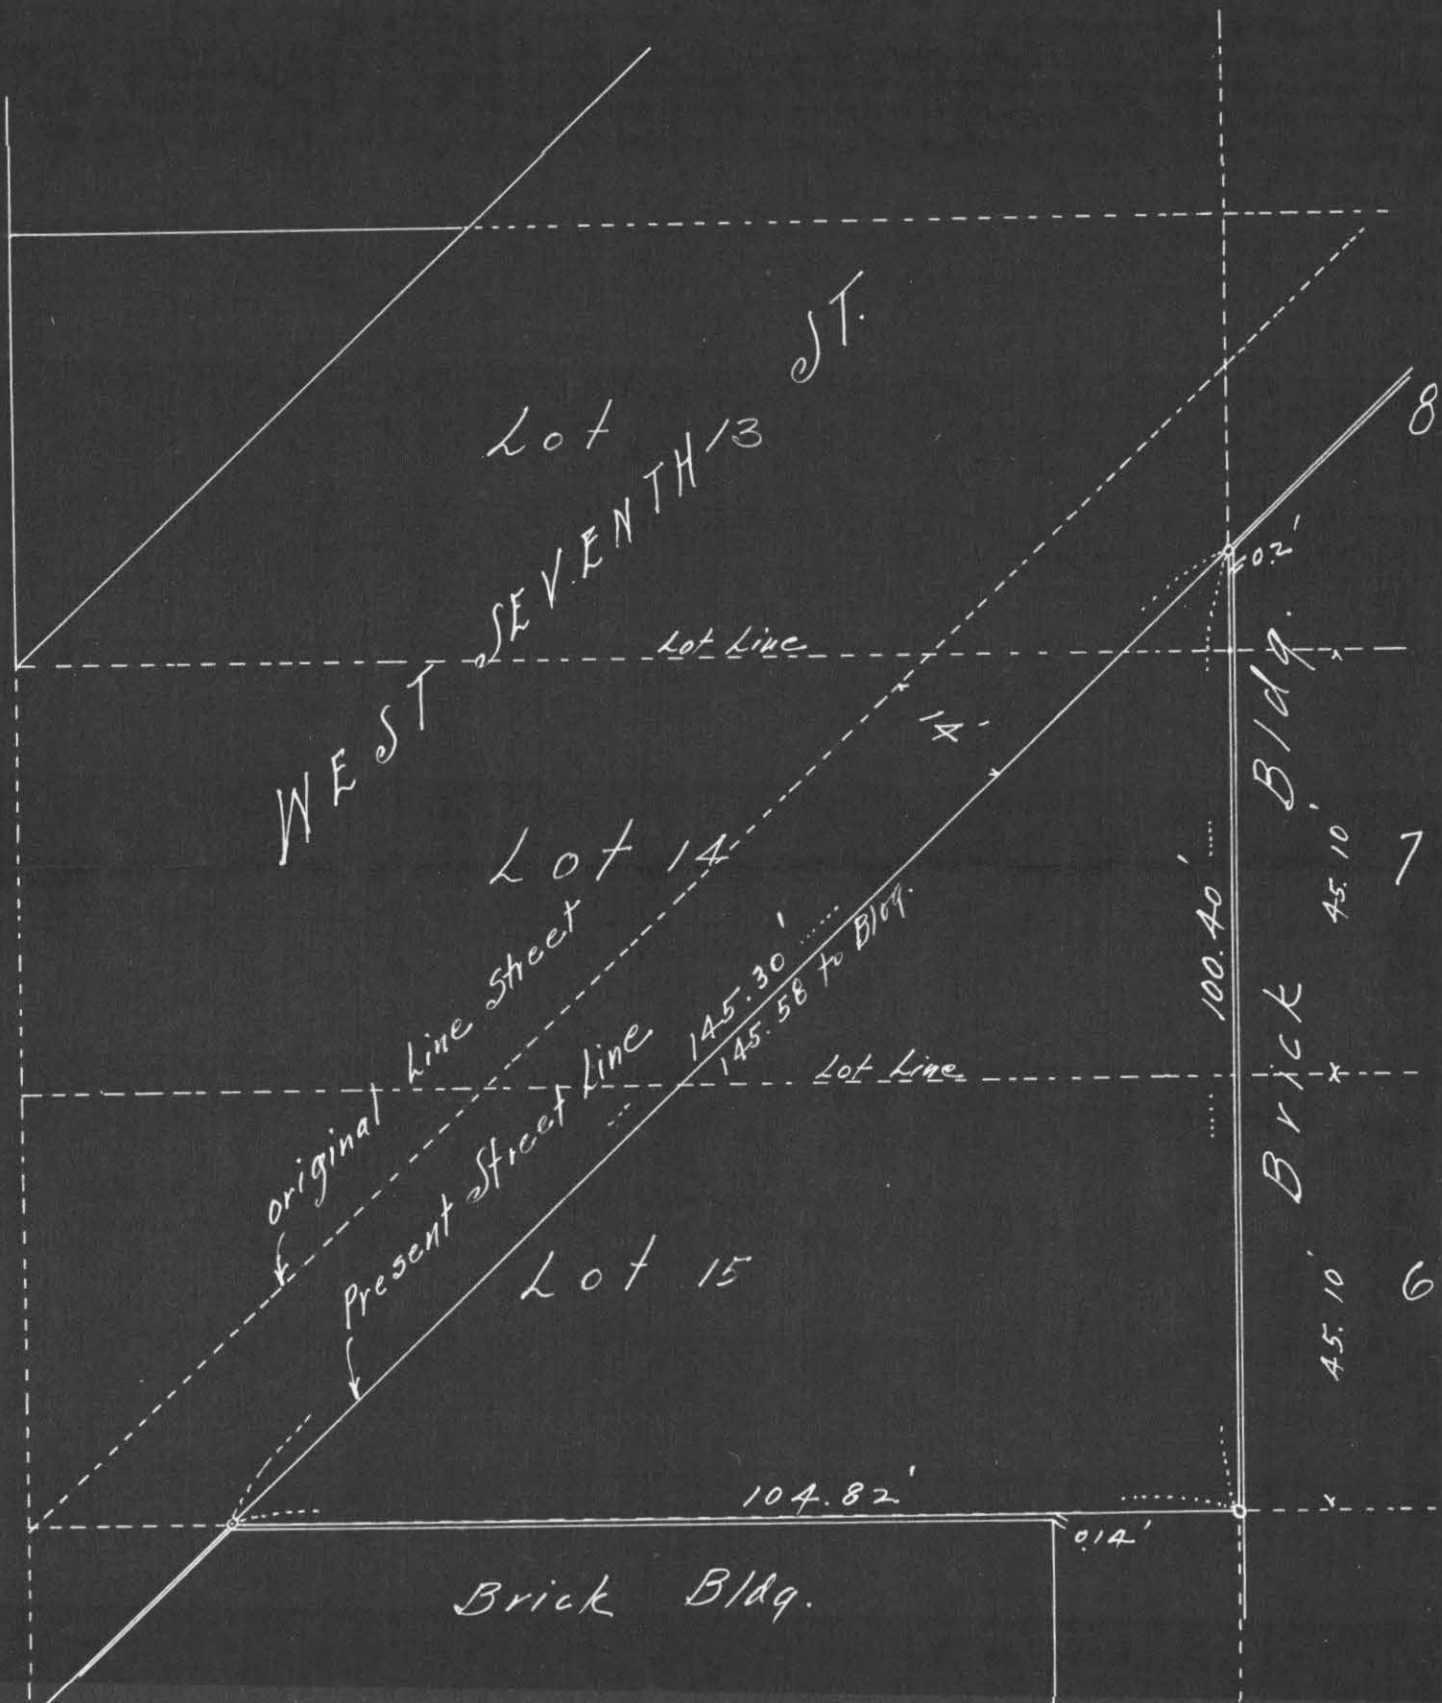

TORONTO

Scale 20 ft. per inch

I HEREBY CERTIFY that on the 23rd day of May A. D. 1940,

I made a survey of the following described property, to-wit: That part of Lots 13-14-15
Ramsey's Subn. of the West 1/2 of Block 26 Stinson
Brown & Ramsey's Addn. St. Paul, Minn.
lying southeasterly of West Seventh Street
and the map hereon shown is a true and correct map of said survey and that the improvements thereon

indicated are correctly shown. F. J. Armstrong Civil Engineer.

Subscribed and sworn to before me this
..... day of, 19.....
.....
Notary Public.
My Commission Expires.....

4209