

20

20

Alley

Oct. 7-1940

(Description)



Lot 24 and the W. 10 ft.  
of Lot 25 Blk I Manson &  
Simontons Add.

I certify to having  
surveyed the above  
described property  
and the same is  
correct

*D.O. Weber*

D.O. Weber  
Reg. Land Surveyor #665

SCALE 1"=20 FT.

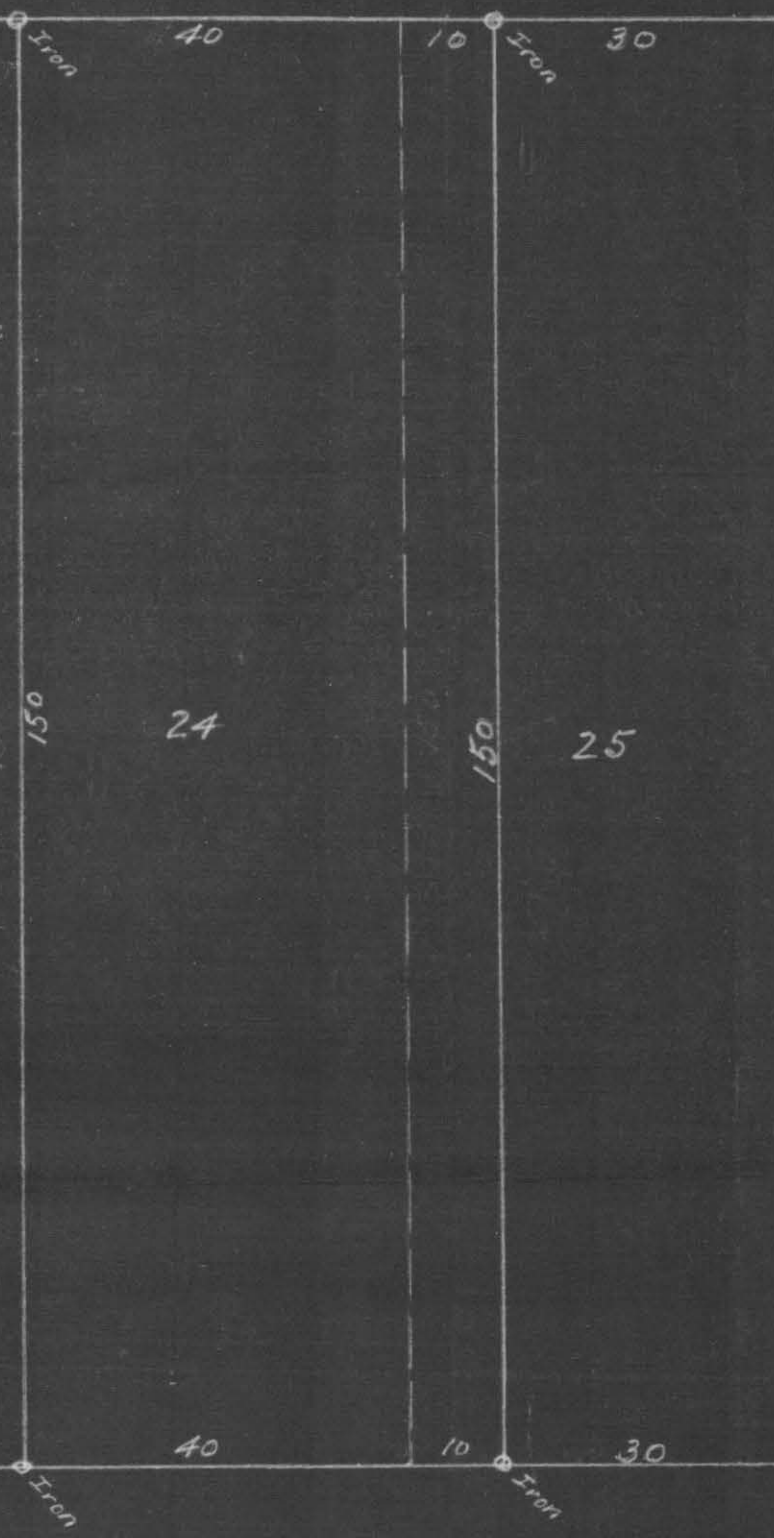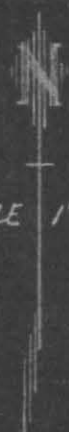

80

GRAND

AVE.

80

#4280