

D&S
1900

ABSTRACT OF TITLE,

Prepared by THE ST. PAUL ABSTRACT COMPANY.

No. 1.

55442


To The S by 1/3 of Lots 1 and 2 Block 12, of St Paul Proper, except the E by 8 feet thereof needed for widening Jackson St and except the W by 10 feet taken for alleyway.

STATE OF MINNESOTA,
County of Ramsey.

The St. Paul Abstract Company does hereby certify that the following exhibit, consisting of 21 sheets, from 1 to 21 inclusive (each of which bears its Corporate Seal), and 146 entries, from 1 to 715 inclusive, is a true and complete Abstract of Title to the real estate described in No. 1 hereof, as shown by the records in the office of the Register of Deeds in and for said County and State, up to this 16th day of November 1904, at 8 o'clock P.M.

THE ST. PAUL ABSTRACT COMPANY,
ABSTRACTERS

J. A. Southerby
VICE PRESIDENT.

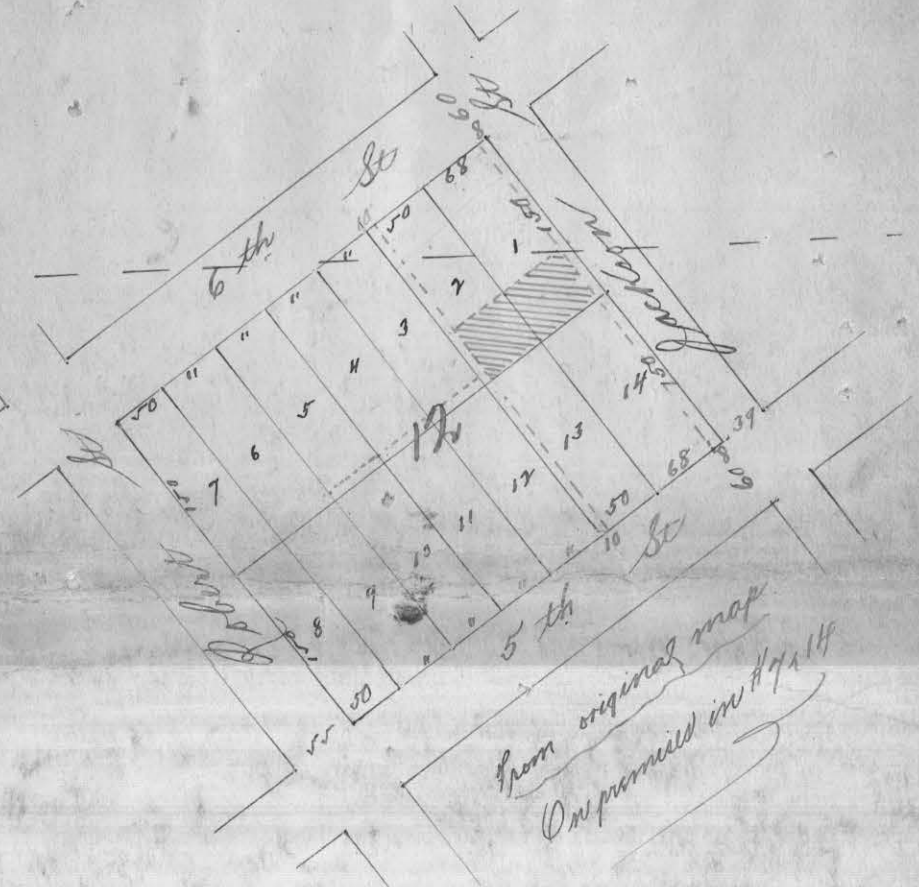

4284

ST. PAUL PROPER


SURVEY OF

S'LY. $\frac{1}{3}$ OF LOT 1 EXCEPT PART TAKEN FOR JACKSON ST., AND S'LY. $\frac{1}{3}$ OF LOT 2 EXCEPT WLY. 10 FT. TAKEN FOR ALLEY, ALL IN BLOCK 12.

MAY, 31, 1923.

SCALE - 1" = 10'


JENS PEDERSEN
SURVEYOR

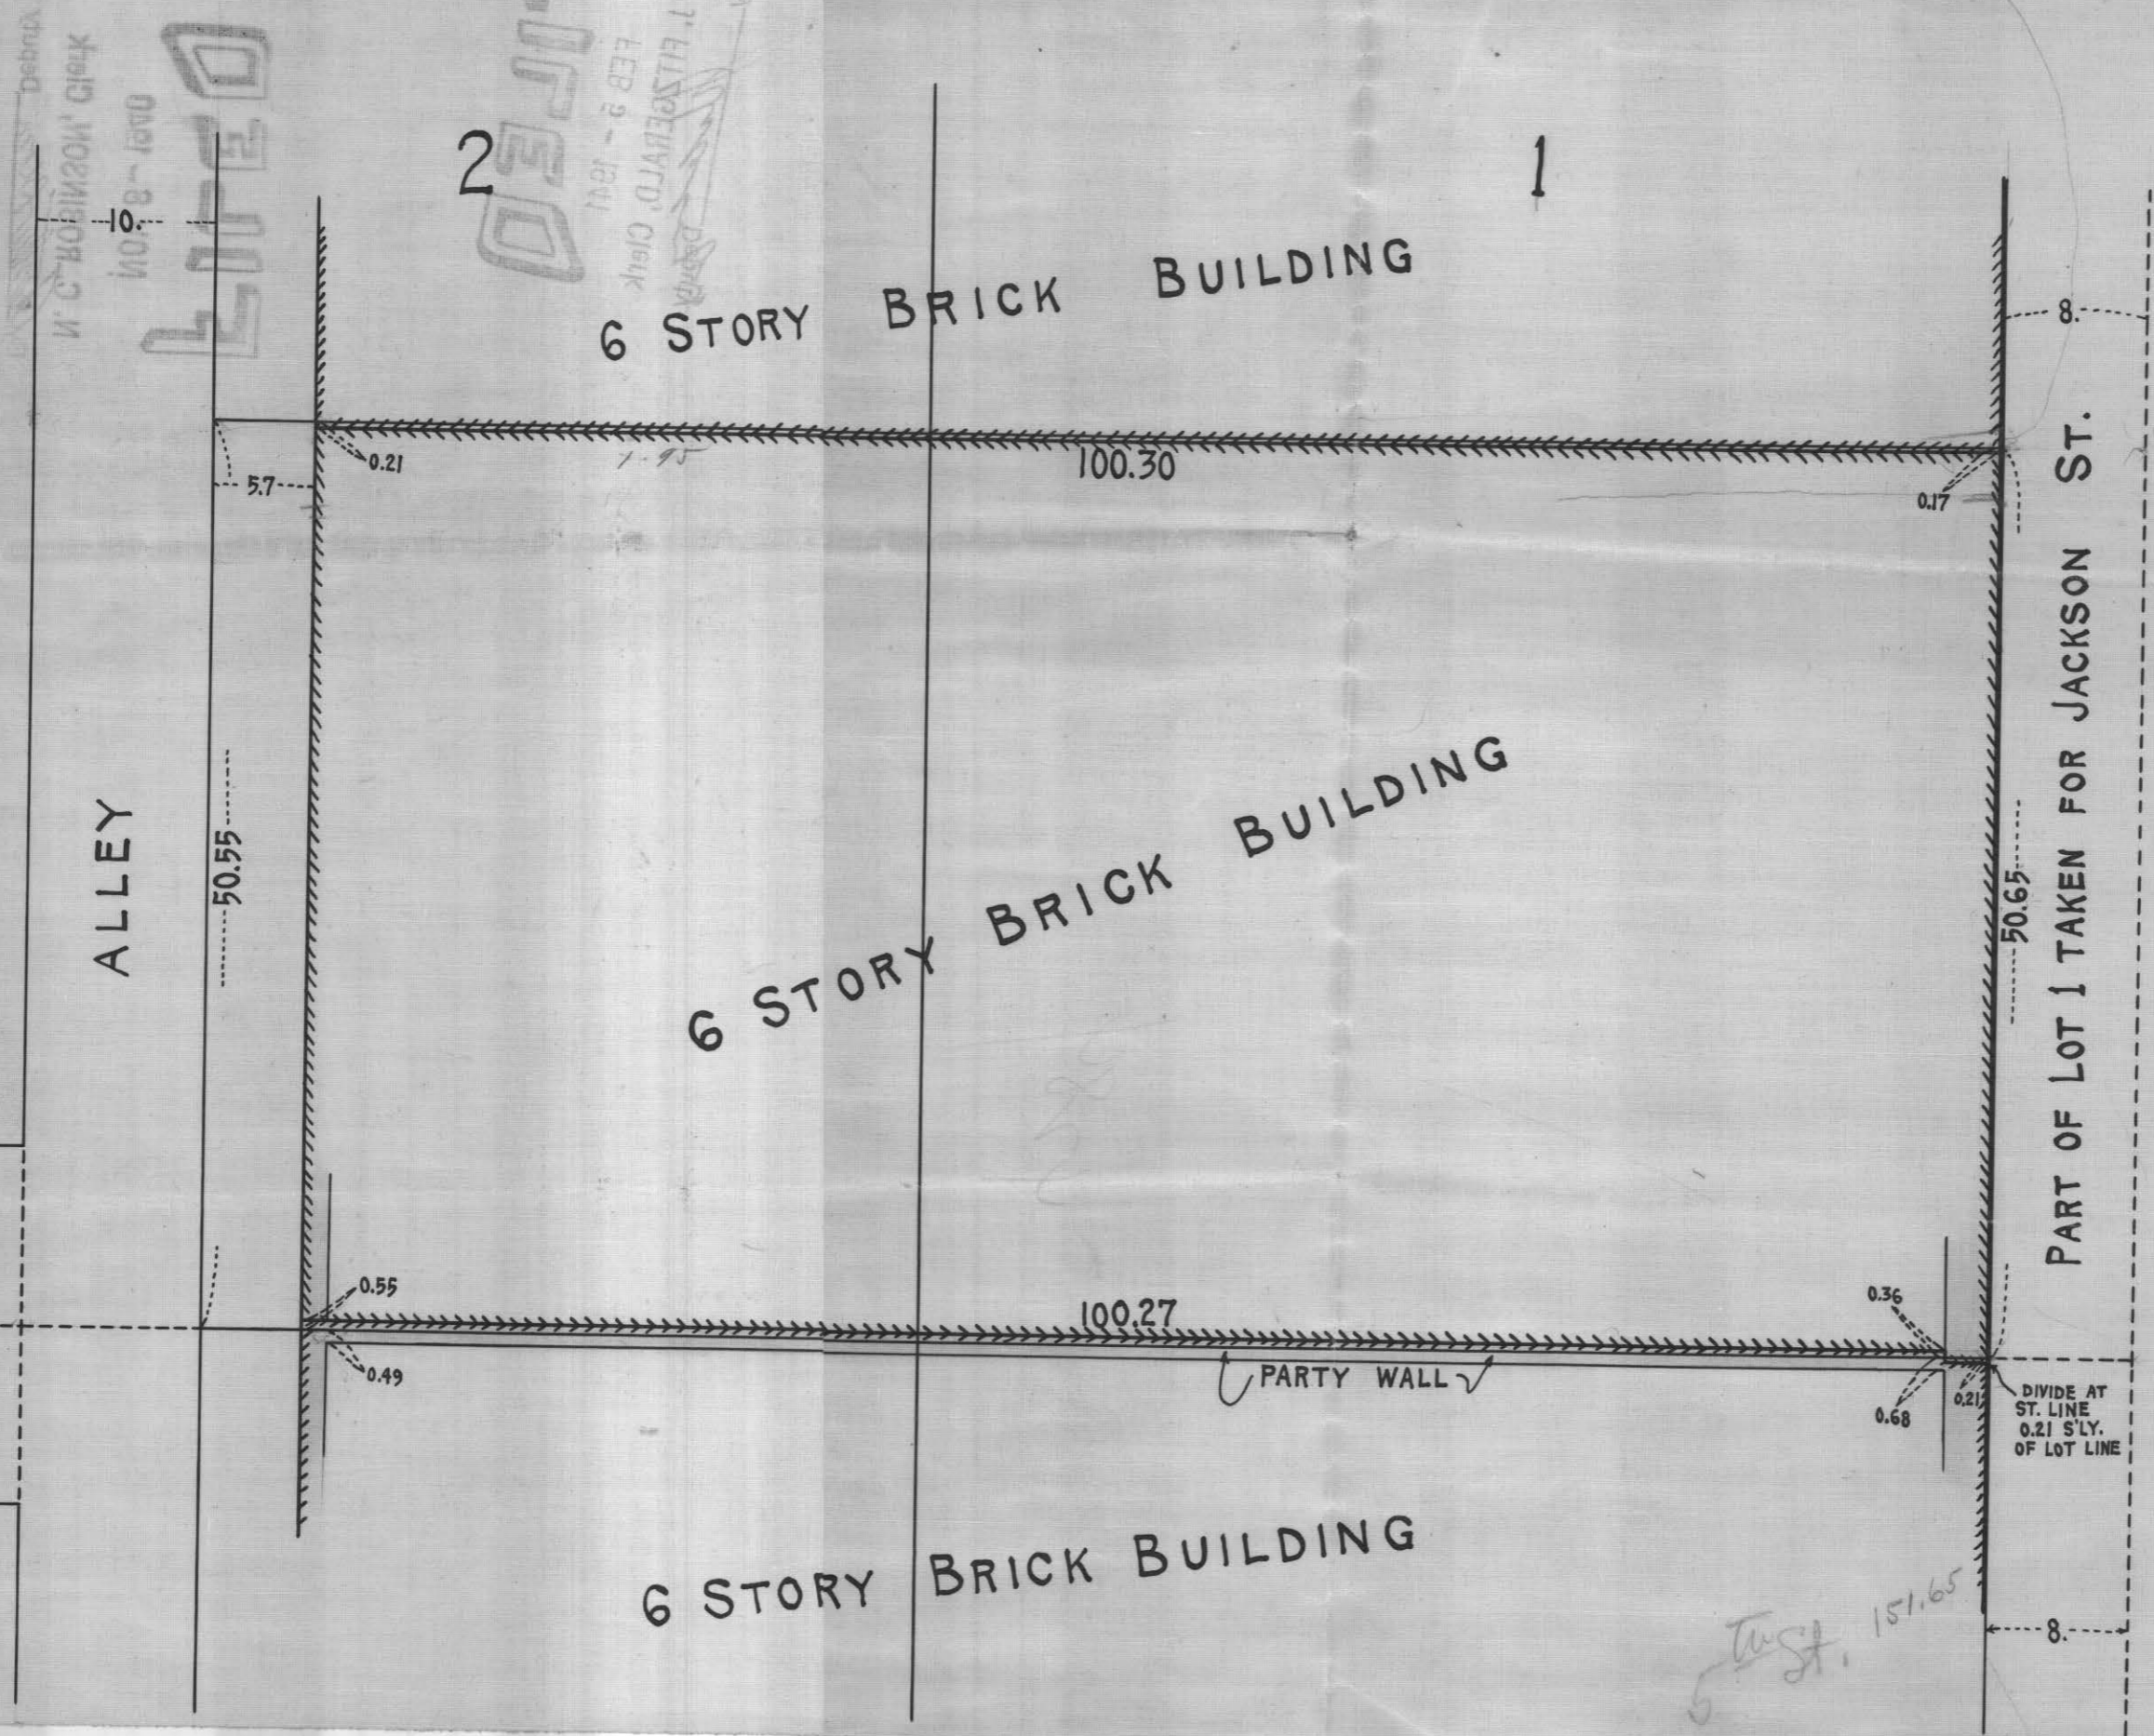

FILED
1.1. HILDBRAND, Clerk
FEB 2 - 1941

50.65 - 10.00
- 1.7

50.48 x 50.34

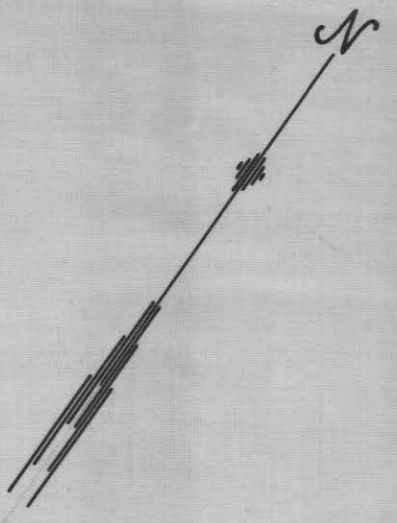

JACKSON

4284