Henry C. Martens.

Lot 2, Block 9, West End Edgcumbe.

No. 1515 Edgcumbe Road St. Paul, Minn.

Scale 1 inch 30 feet.

T. J. Welch.
Reg. Surveyor
Oct 14, 1940.

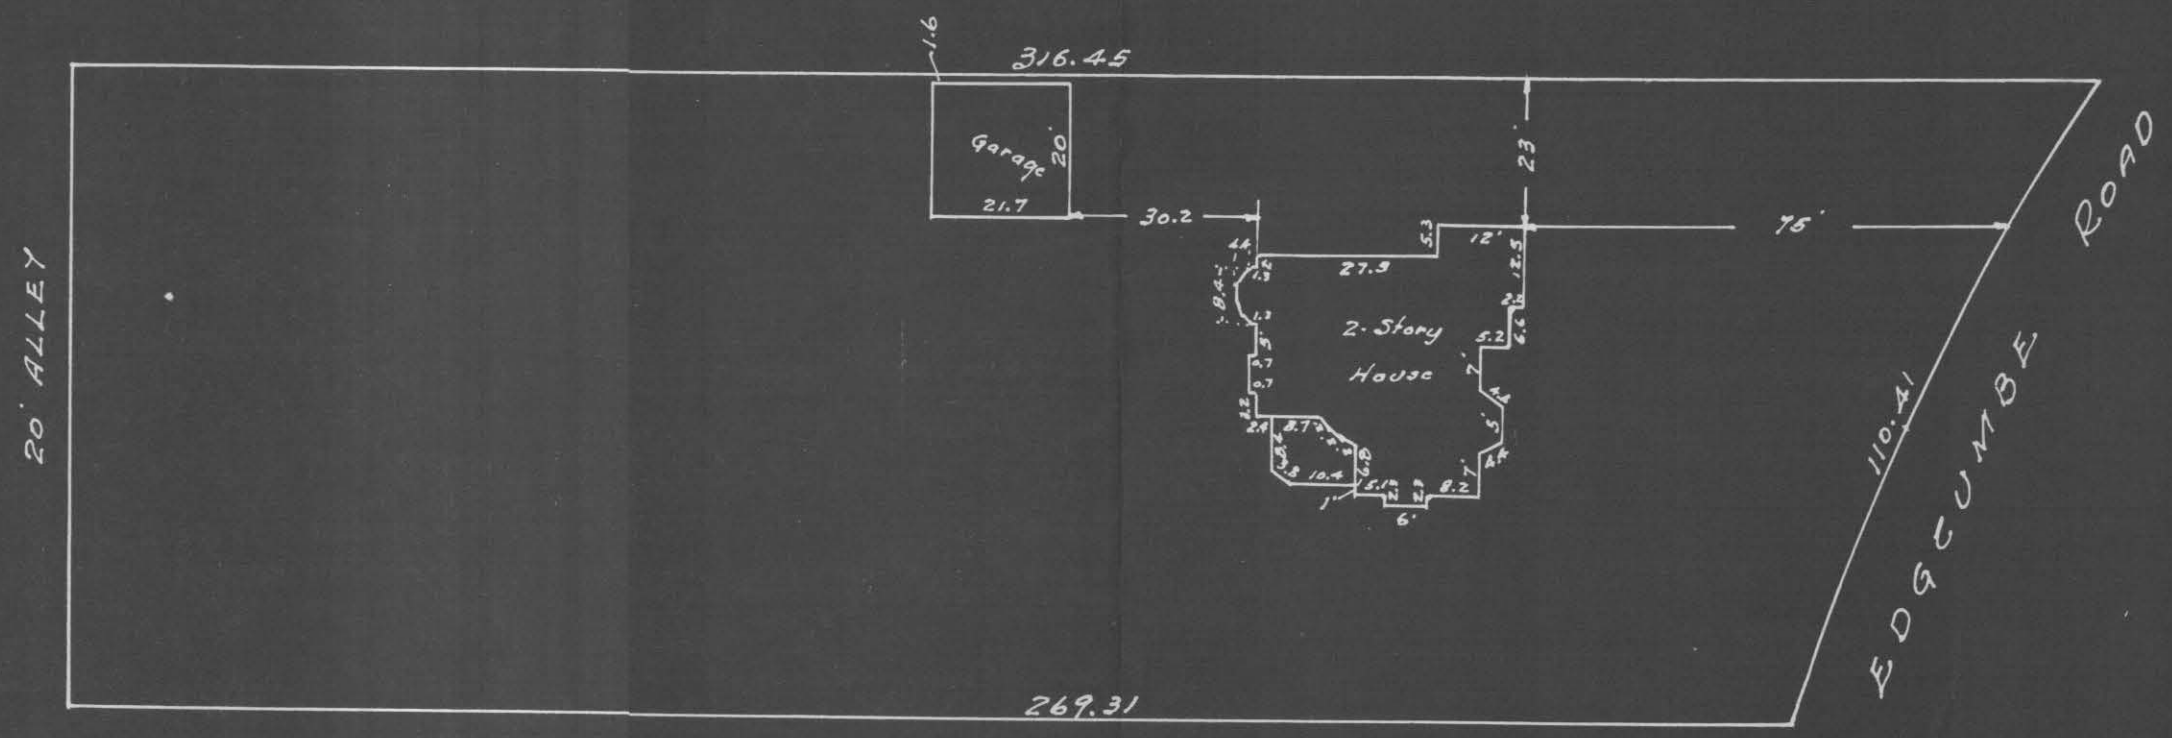

I HEREBY CERTIFY that on the fourteenth day of October, 1940, I surveyed the property above described and that the above plat is a correct representation of said survey and the same is located within the limits of the North 330 feet of Block nine (9), West End, according to the recorded plat on file and of record in the office of the Register of Deeds in and for Ramsey County, Minnesota.

T. J. Welch
Registered Surveyor

4286