


PLAT OF SURVEY

Lot "B" of BROWN AND JACKSON'S
ADD'N in ST. PAUL, excepting the
the westerly 5' of the northerly
120' thereof

Scale-1"=20'



T.J. WELCH - REGISTERED SURVEYOR
738 SURREY AVE.
ST. PAUL, MINN. To-0640

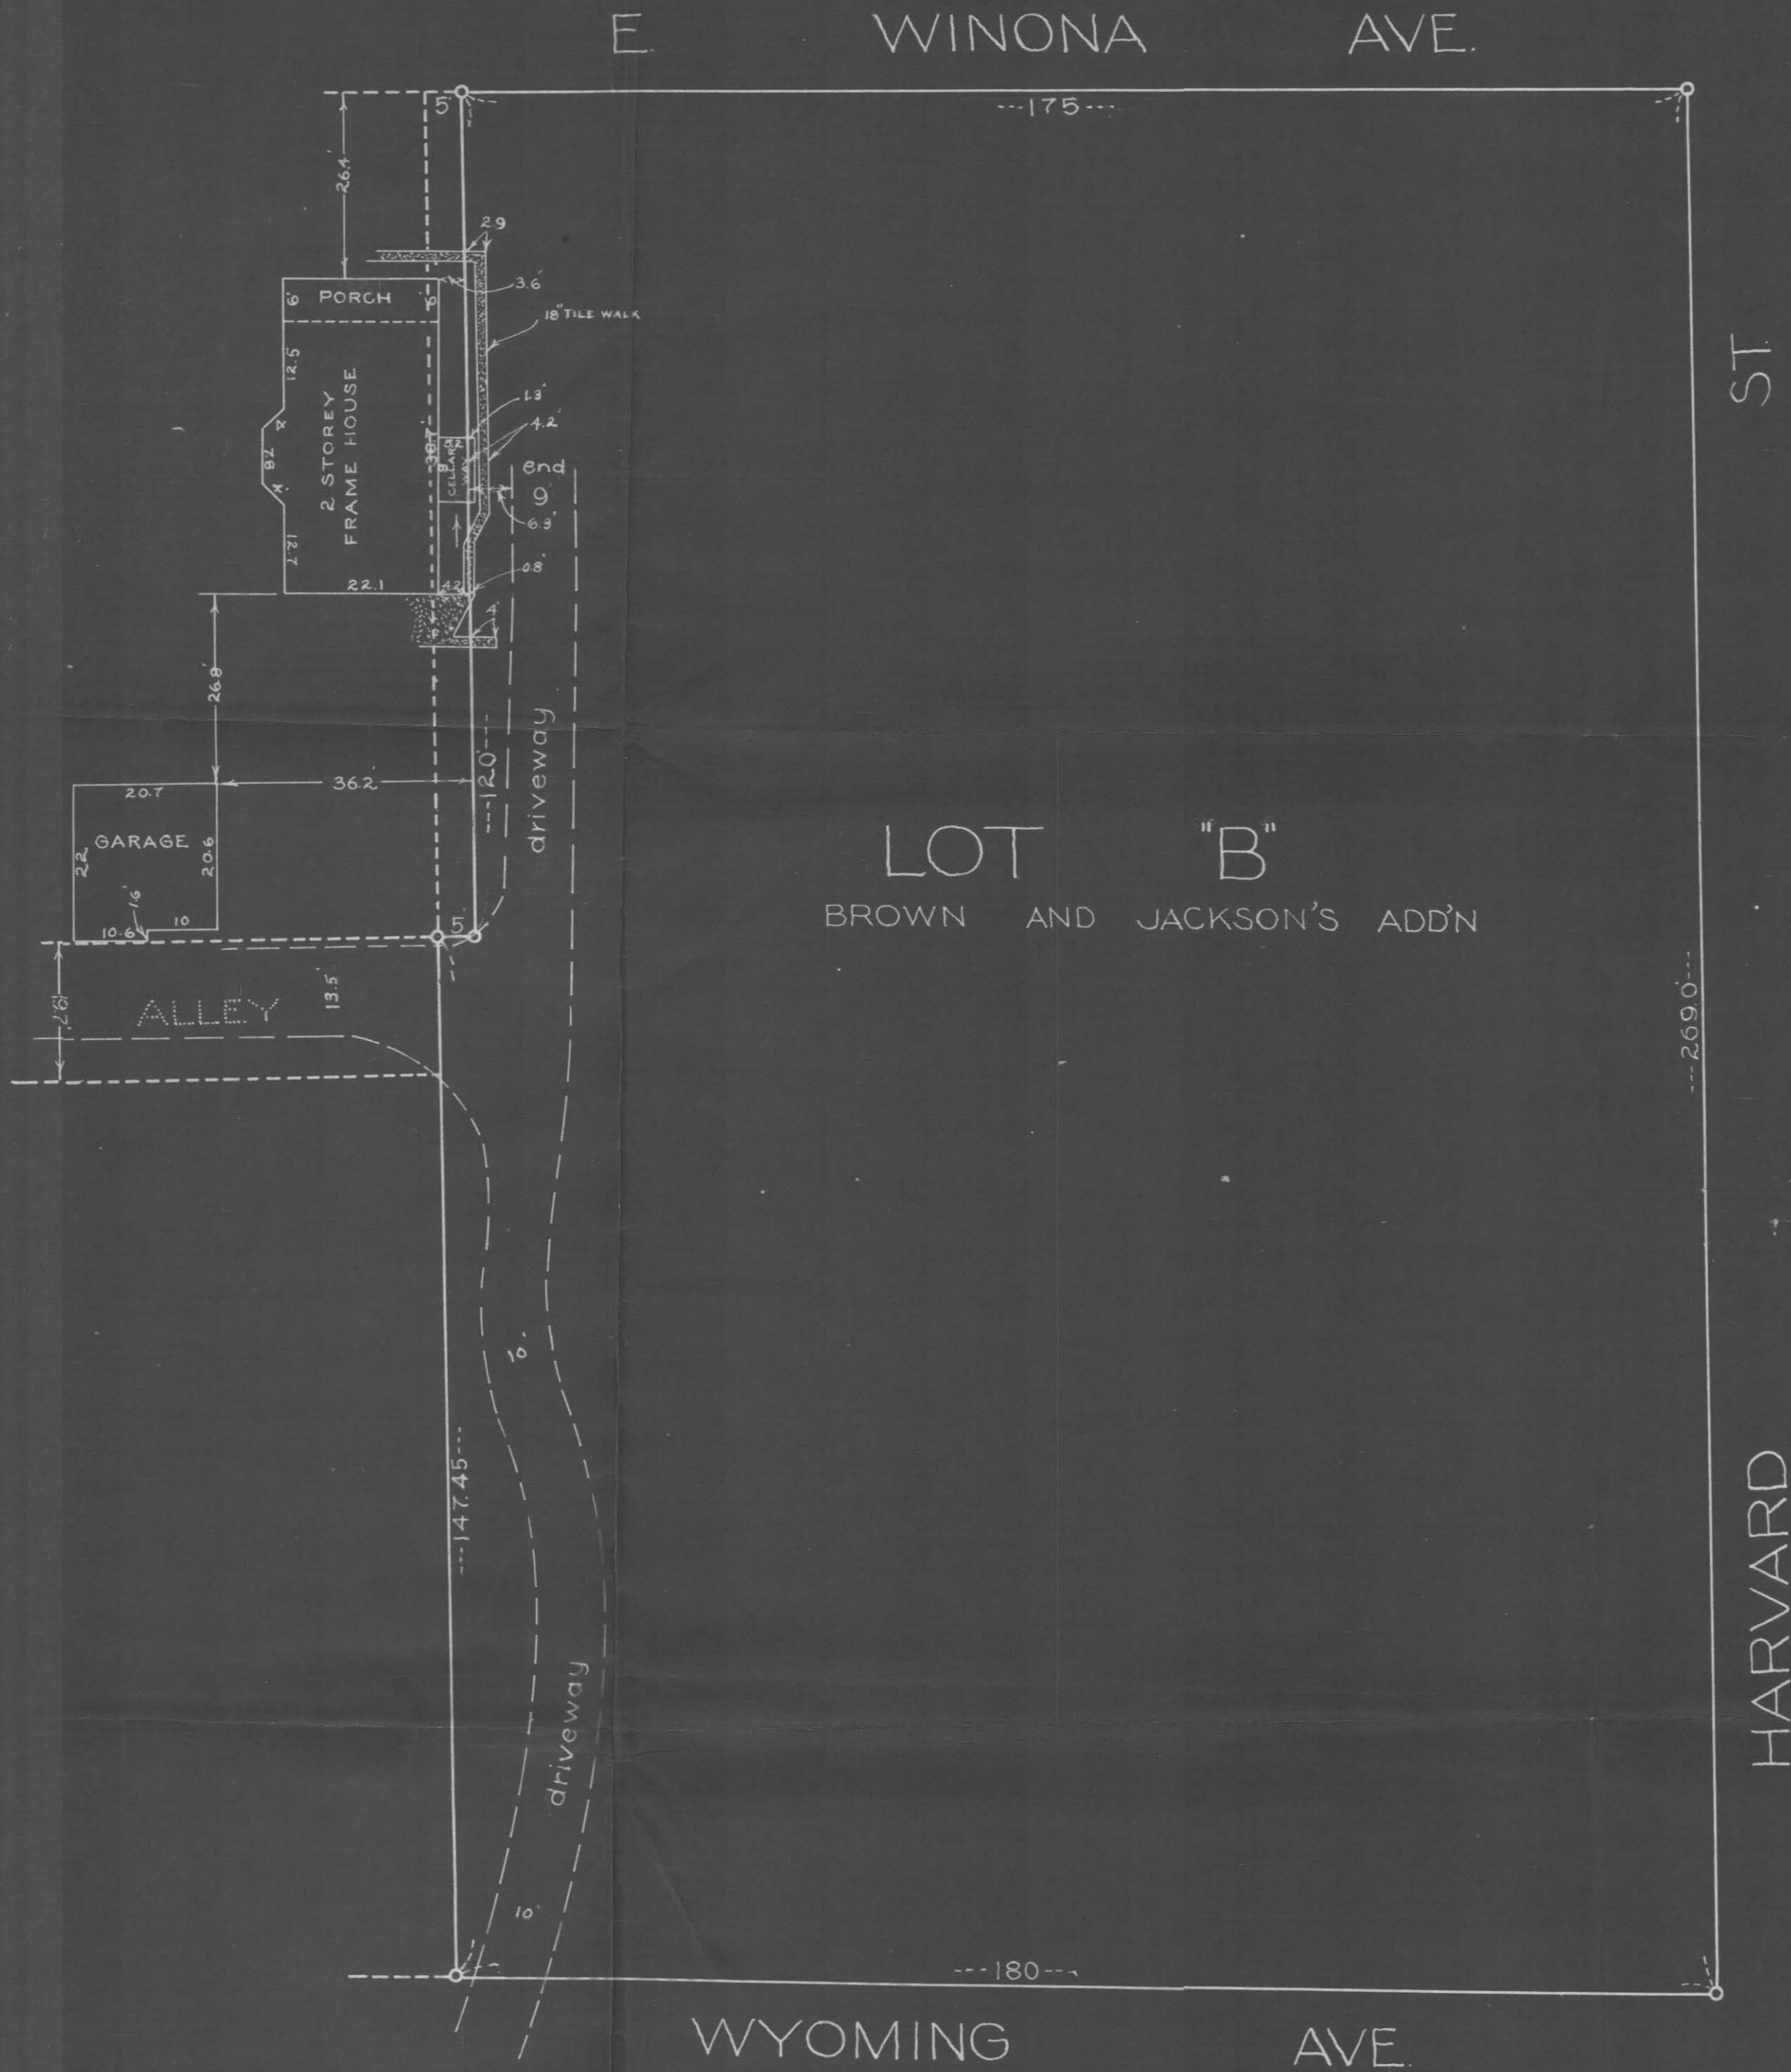

4345