Book 12 p. 75

# CERTIFICATE of SURVEY

Franklyn J. Armstrong
CIVIL ENGINEER AND SURVEYOR
GUARDIAN LIFE BLDG. ST. PAUL, MINN.

N

79' Lt. & cor.

Lot 5 | Lot 4

2

0.53 | 0.74

78'

Cement | 16' | private alley for use of theatre

50.05 bldg

0.07 | 16.1 | 16.07

Garage

18.1

20.1

39.98

3

39'

0.02

Shed

22.5

41.6

11.0 | 10.8

56.8 bldg | 9.80

10.98

Lot 19 | Lot 20 | Private Alley | Park Theatre | Park Lot 21

137.09 bldg.

148.97

22

Lots 19-20-21 and pt Lots 4 & 5 Block 1 Kuhls Addition

Scale 20 ft. to 1 in.

June 1926

23

Brick on Line

75 bldg.

Grocery | Cafe | Bakery

MINNESOTA BOND

MINNESOTA

55'

4.72

24

0.27

℄ Present Line

9.96

56.76 bldg | 117. | 50.01 bldg

10

39 | 39 | 39

℄ original Line of Selby

SELBY AVE.

I hereby certify that on the 8th day of June 1926 I made a survey of the following described premises to wit: Lots 19 20-21 & part Lots 4 & 5 Block 1 Kuhl's Addn and that the plat hereto attached is a true and correct plat of said premises: [redacted]

J. Armstrong
Civil Engineer

Subscribed and sworn to before me this _____ day of _____ 19__

_____ Notary Public

My commission expires _____

#4352

# CERTIFICATE of SURVEY

F. J. ARMSTRONG
*Civil Engineer and Surveyor*
ST. PAUL, MINN.

4352

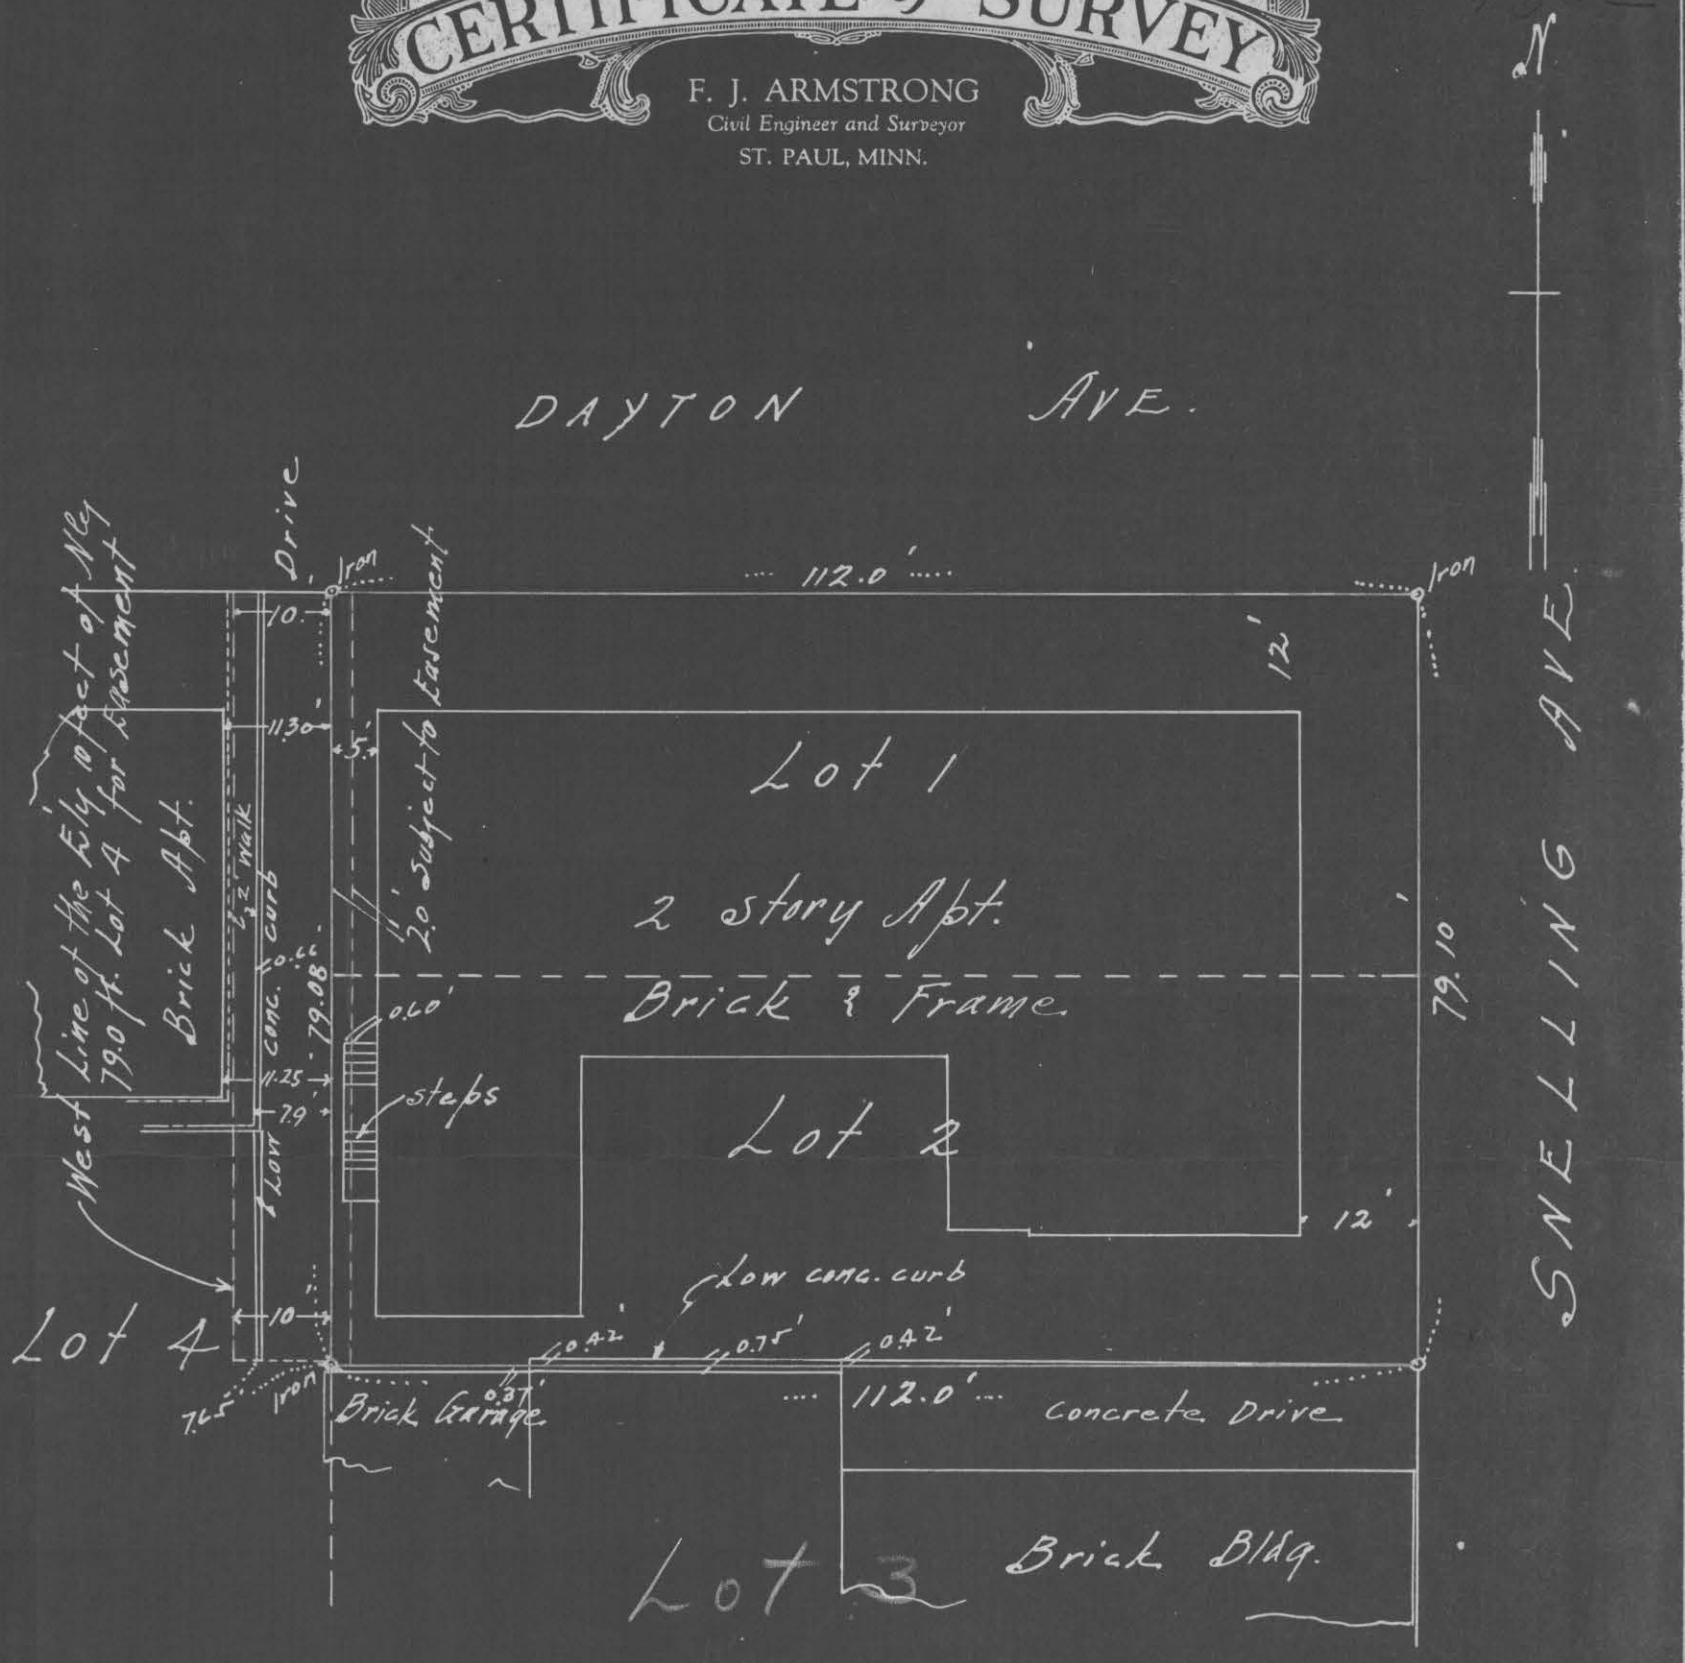


Scale 20 feet per inch

I HEREBY CERTIFY that on the 31st day of May, A. D. 1941, I made a survey of the following described property, to-wit: Lots 1 & 2 in Block 1 Kuhl's Addition to the City of St Paul; together with & subject to the easements hereon indicated and the map hereon shown is a true and correct map of said survey and that the improvements thereon indicated are correctly shown.

F. J. Armstrong
Civil Engineer.

Subscribed and sworn to before me this
.....day of....., 19.....

.....
Notary Public.

My Commission Expires.....

#4352