


SURVEY OF
 E. 30 FT. OF LOT 19 & W. 1/2 OF LOT 20, BLK. A,
 MARSHALL BOULEVARD ADD.

AUG., 20, 1941.

R. L. Wolfgang
 REGISTERED LAND SURVEYOR.

SCALE - 1 IN. = 10 FT.

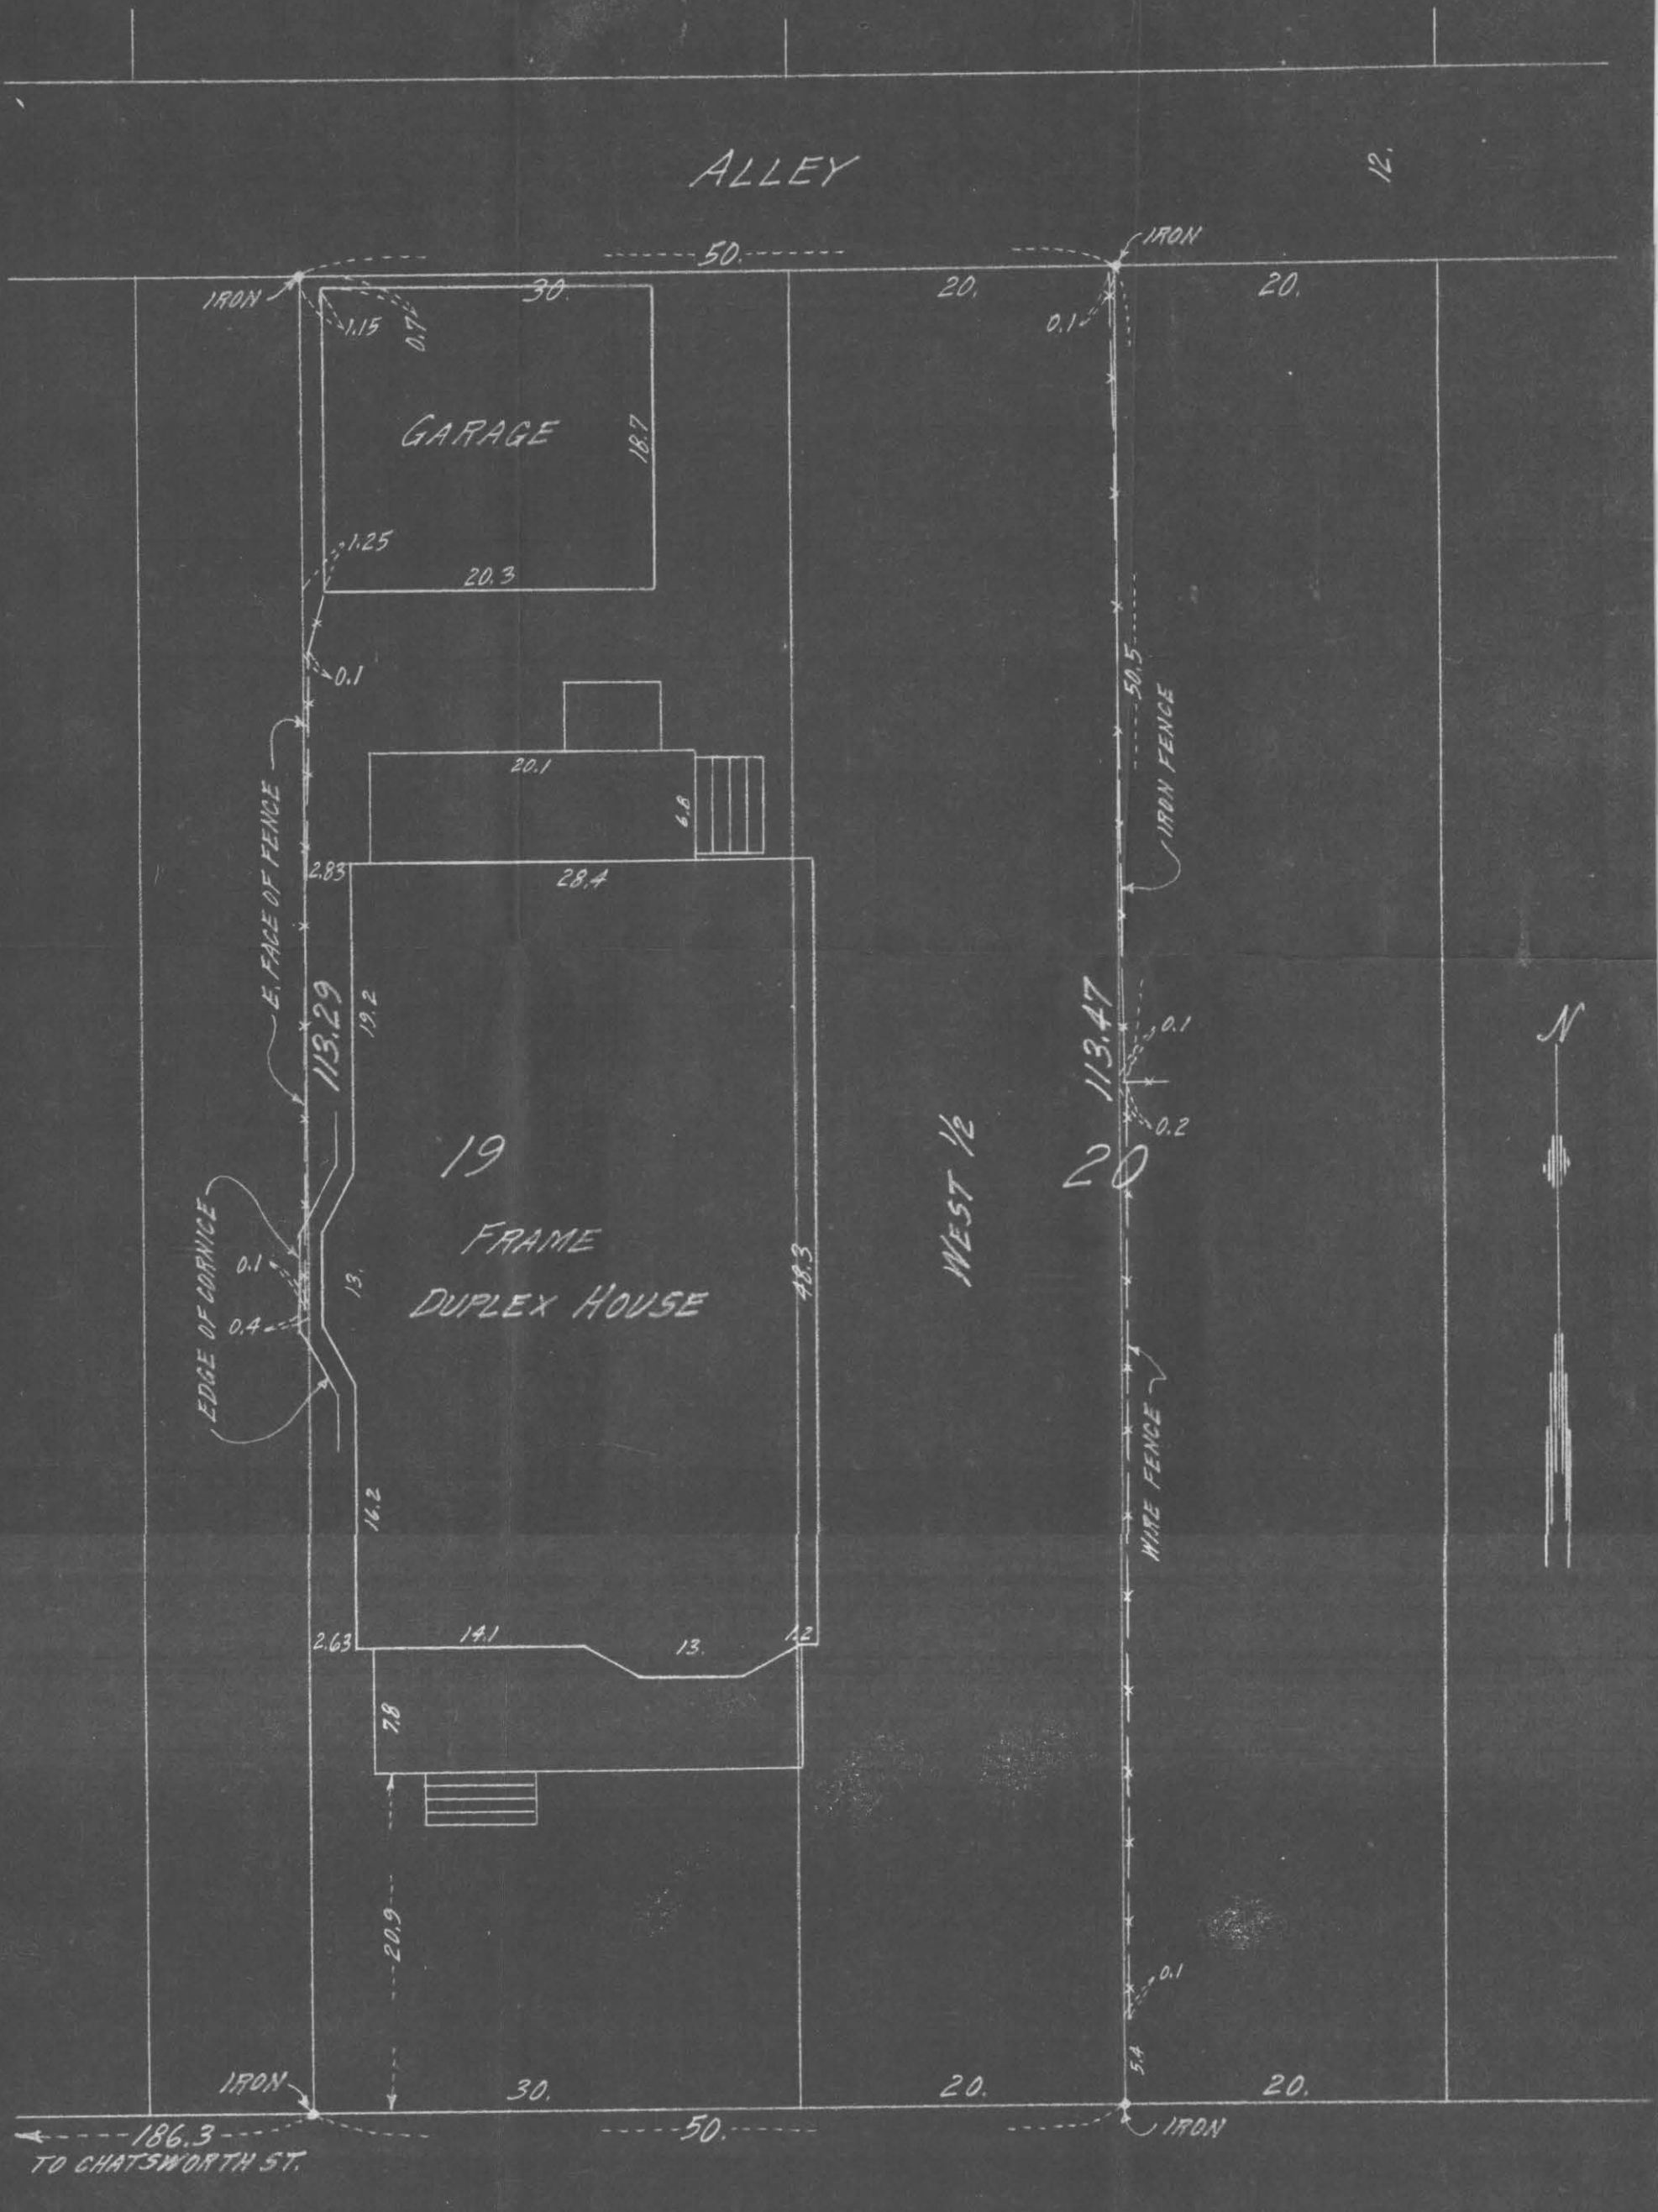

MARSHALL

4380

AVE. 100.