


PLAT OF SURVEY

4405

OF PROPERTY OF _____
DESCRIBED AS FOLLOWS _____

SCALE: 1 INCH 100 FEET.

T. J. WELCH, REGISTERED SURVEYOR
738 SURREY AVENUE, ST. PAUL, MINN.

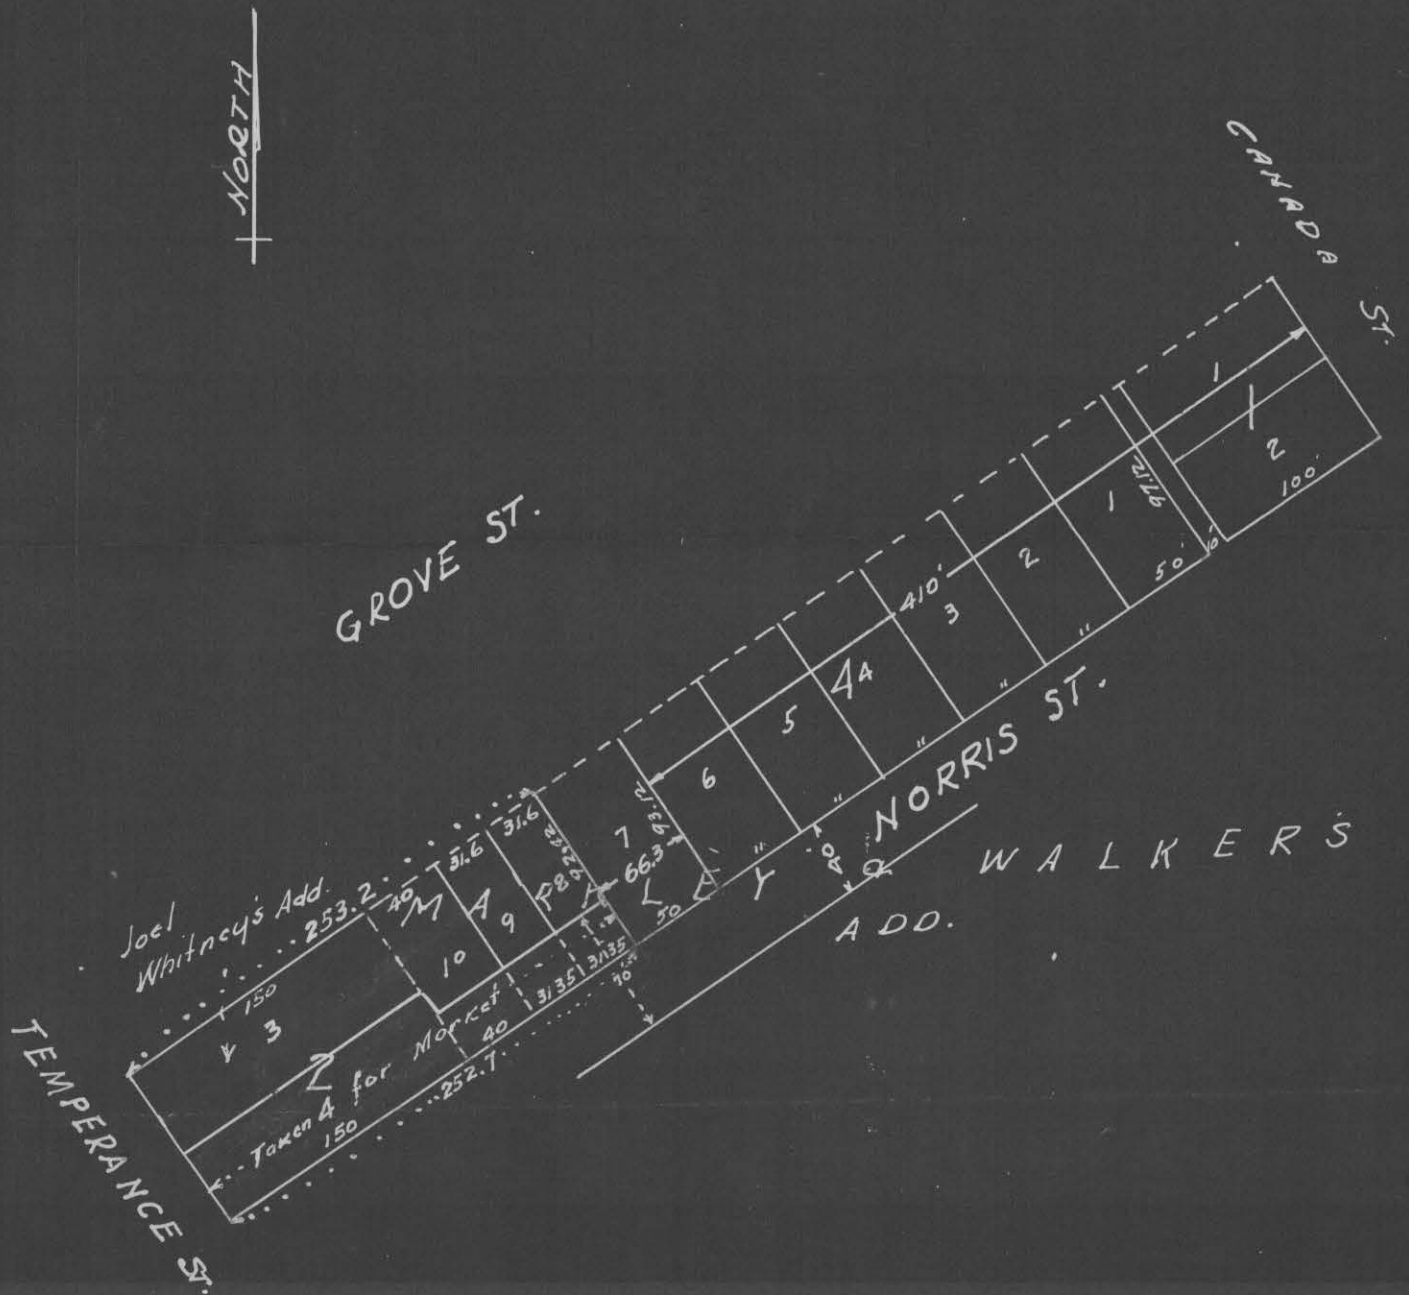

CERTIFICATE OF LOCATION OF BUILDING

I hereby certify that on _____ 19____
I made a survey of the location of the building on the above
described property and that the location of said building is
correctly shown on the above plat.

CERTIFICATE OF SURVEY

I hereby certify that on July 6. 1940.
I surveyed the property described above and that the above
plat is a correct representation of said survey.

T. J. Welch

4405