SURVEY OF

LOTS 1 & 2, CHAS. WEIDE'S SUBDIV. OF BLK. 46 OF ARLINGTON HILLS ADD. TO ST. PAUL AND ALSO THAT PART OF ROSS ST. VACATED AND ACCRUING TO SAID LOT 1.

DECEMBER 13, 1941.

R. A. Wolfgram
REGISTERED LAND SURVEYOR.

SCALE - 1 IN. = 10 FT.

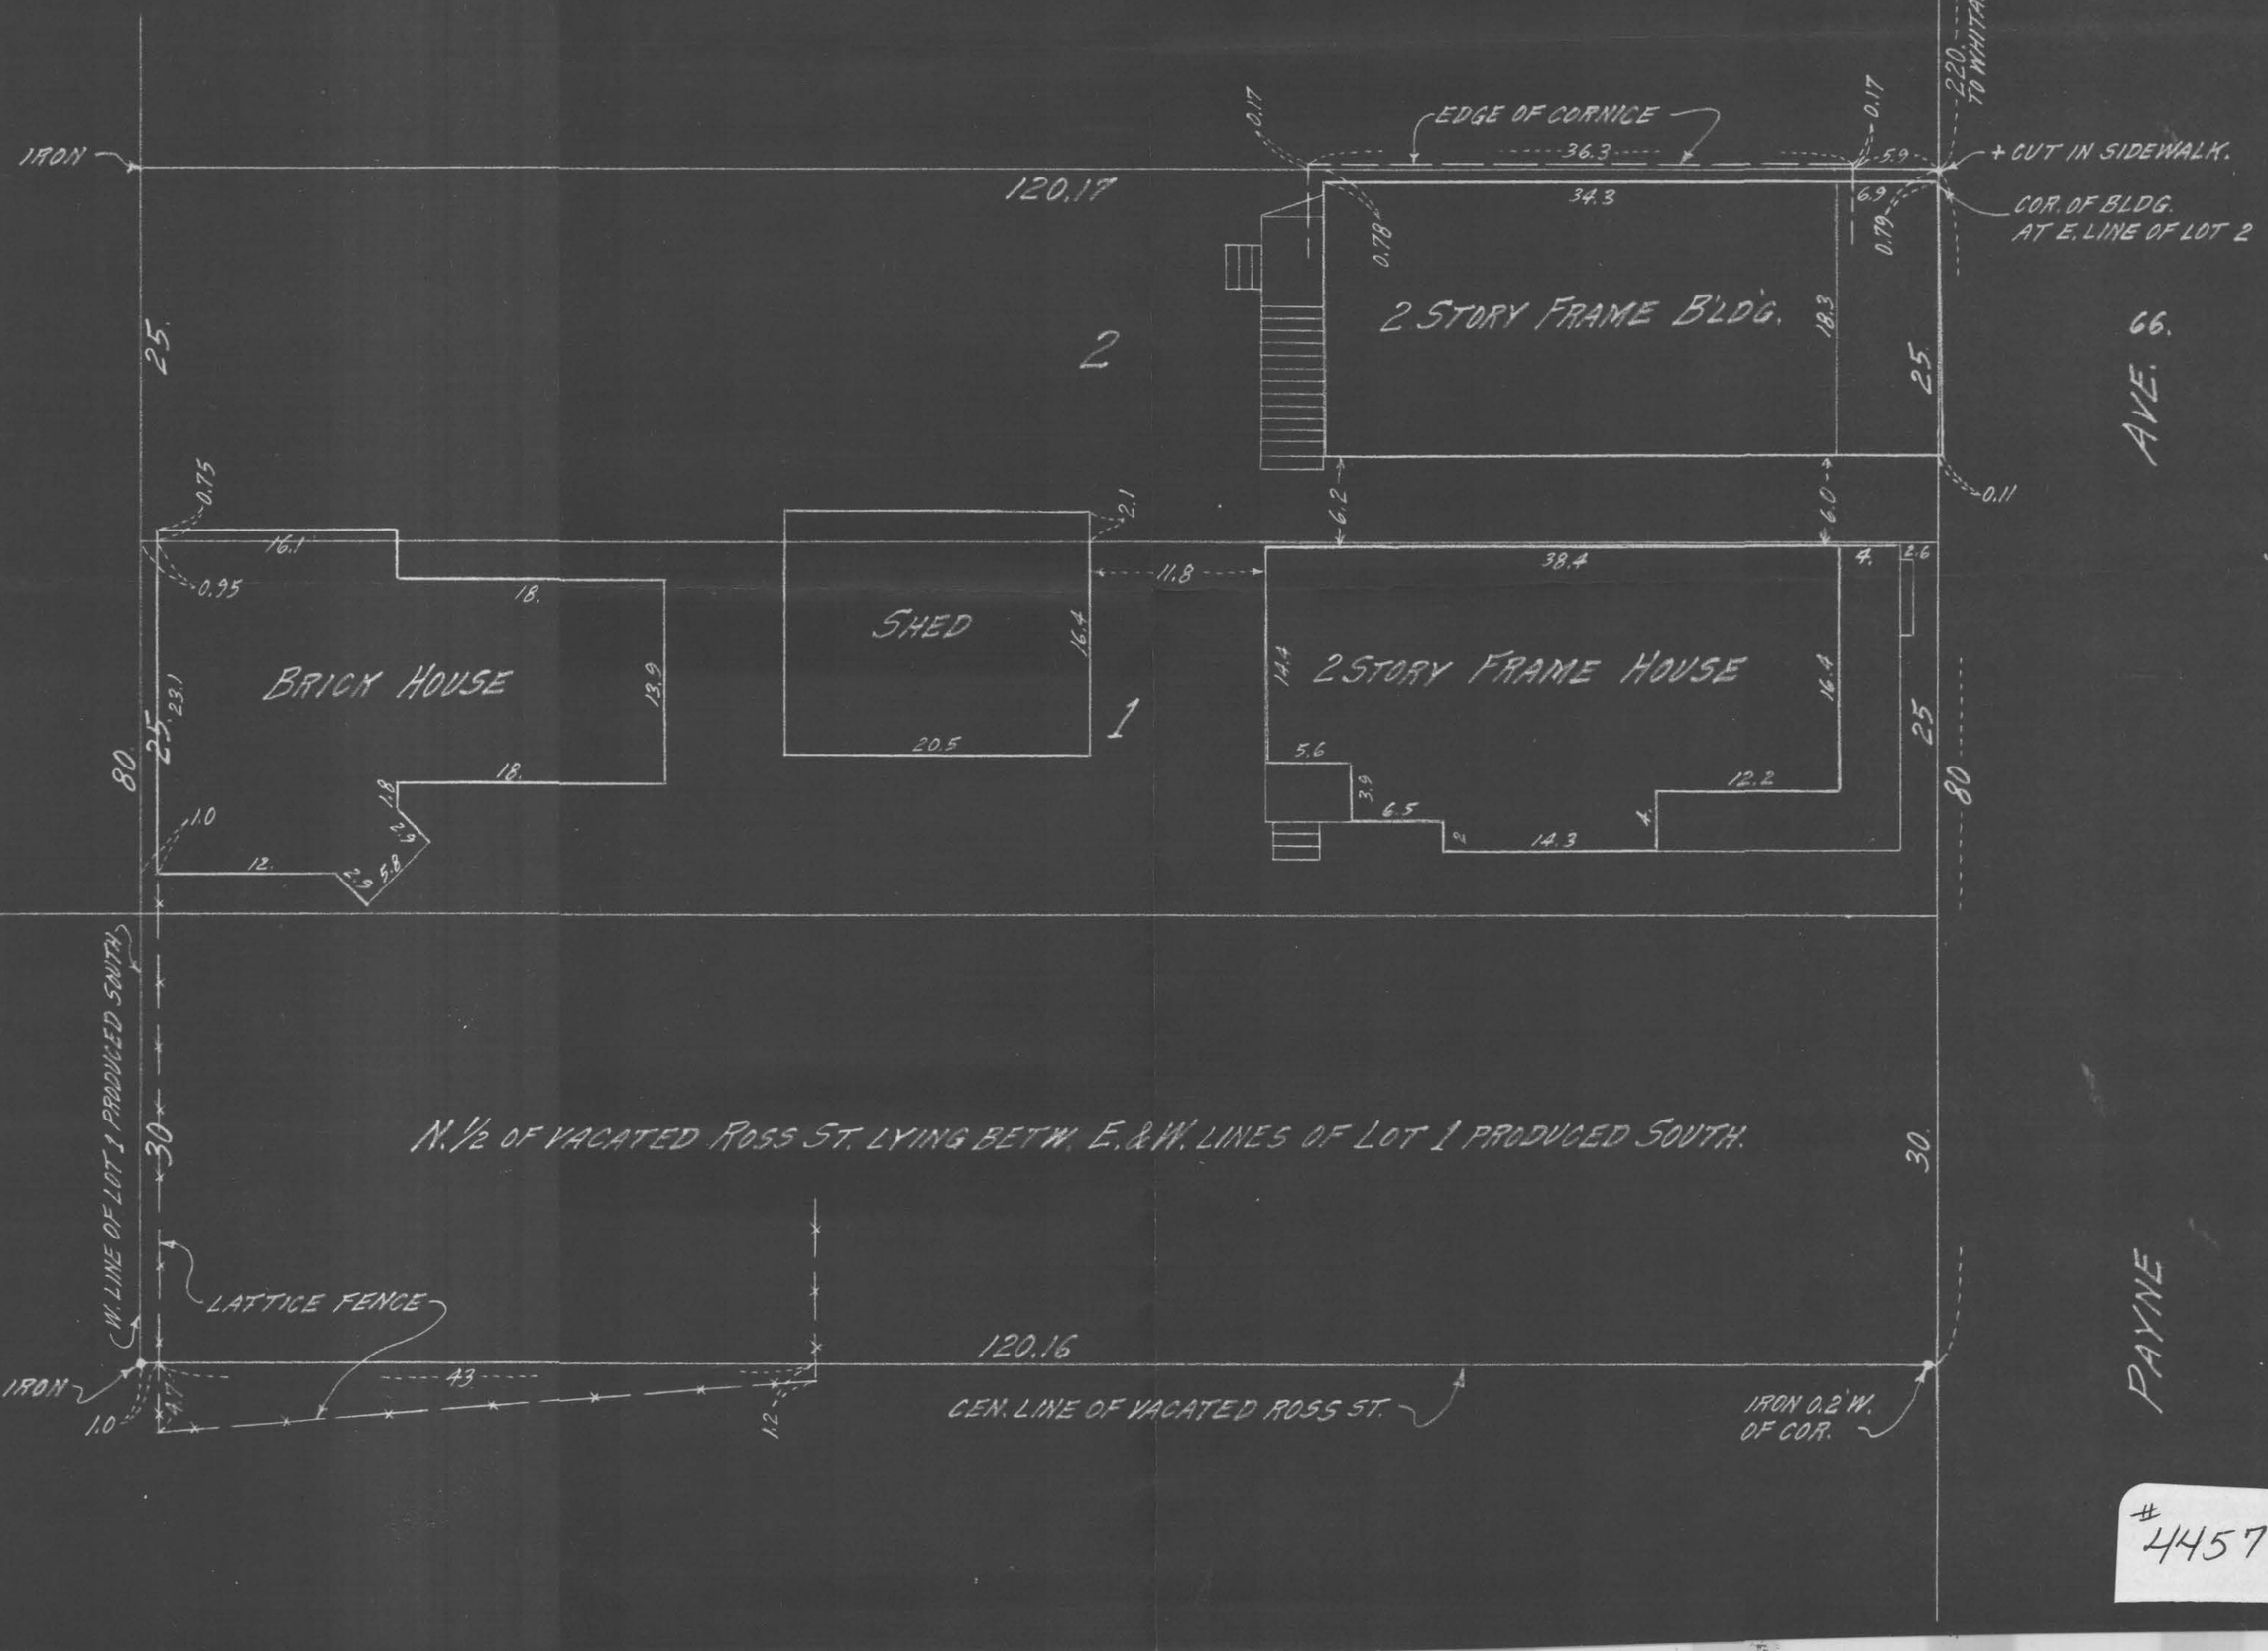

#4457