


4470

CERTIFICATE of SURVEY

F. J. ARMSTRONG
Civil Engineer and Surveyor
ST. PAUL, MINN.

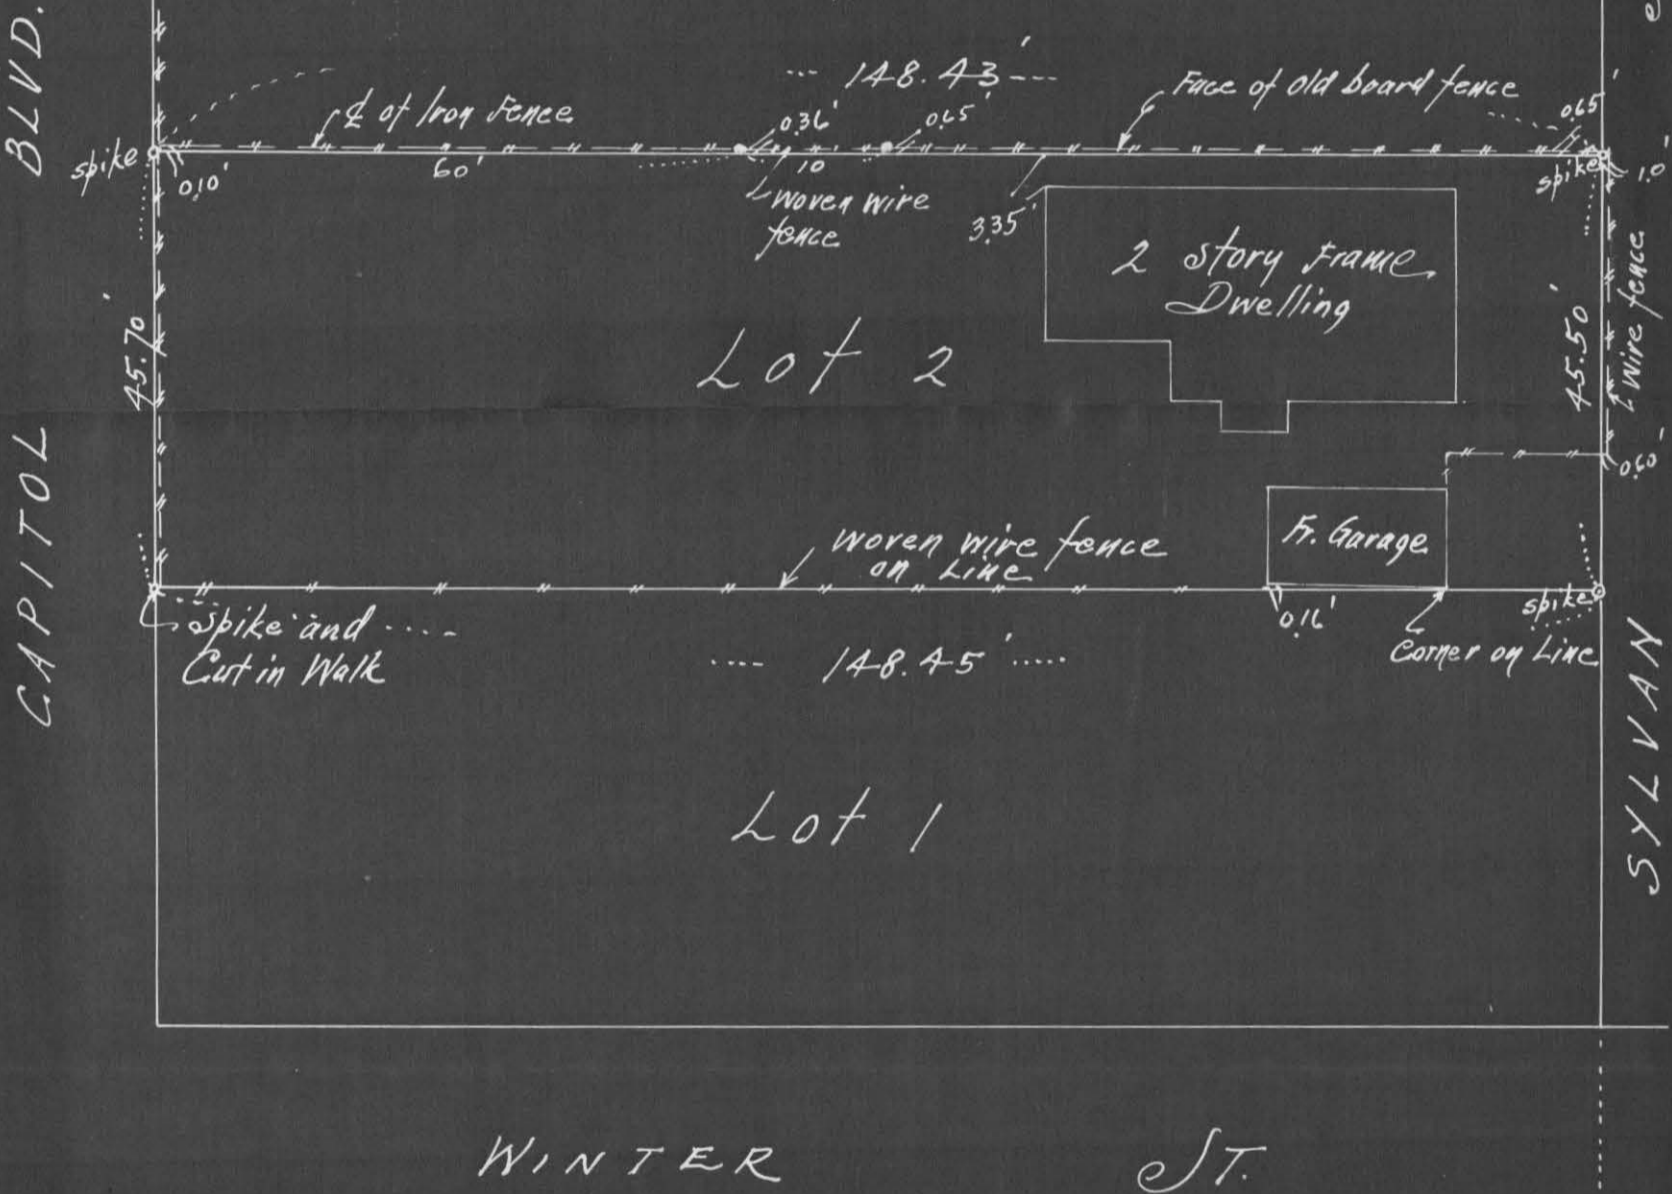

Scale 20 ft. per inch

I HEREBY CERTIFY that on the 24th day of January, A. D. 1942,
I made a survey of the following described property, to-wit: Lot 2-Block 7
Fletcher's Subn of Brewster's Add'n.
St. Paul, Minn.

Subscribed and sworn to before me this
..... day of....., 19.....
.....
Notary Public.
My Commission Expires.....

and the map hereon shown is a true and correct map of said survey and that the improvements thereon indicated are correctly shown.....
F. J. Armstrong Civil Engineer.

#4470