


# CERTIFICATE of SURVEY

F. J. ARMSTRONG  
Civil Engineer and Surveyor  
ST. PAUL, MINN.

4526

VON MINDEN ST.

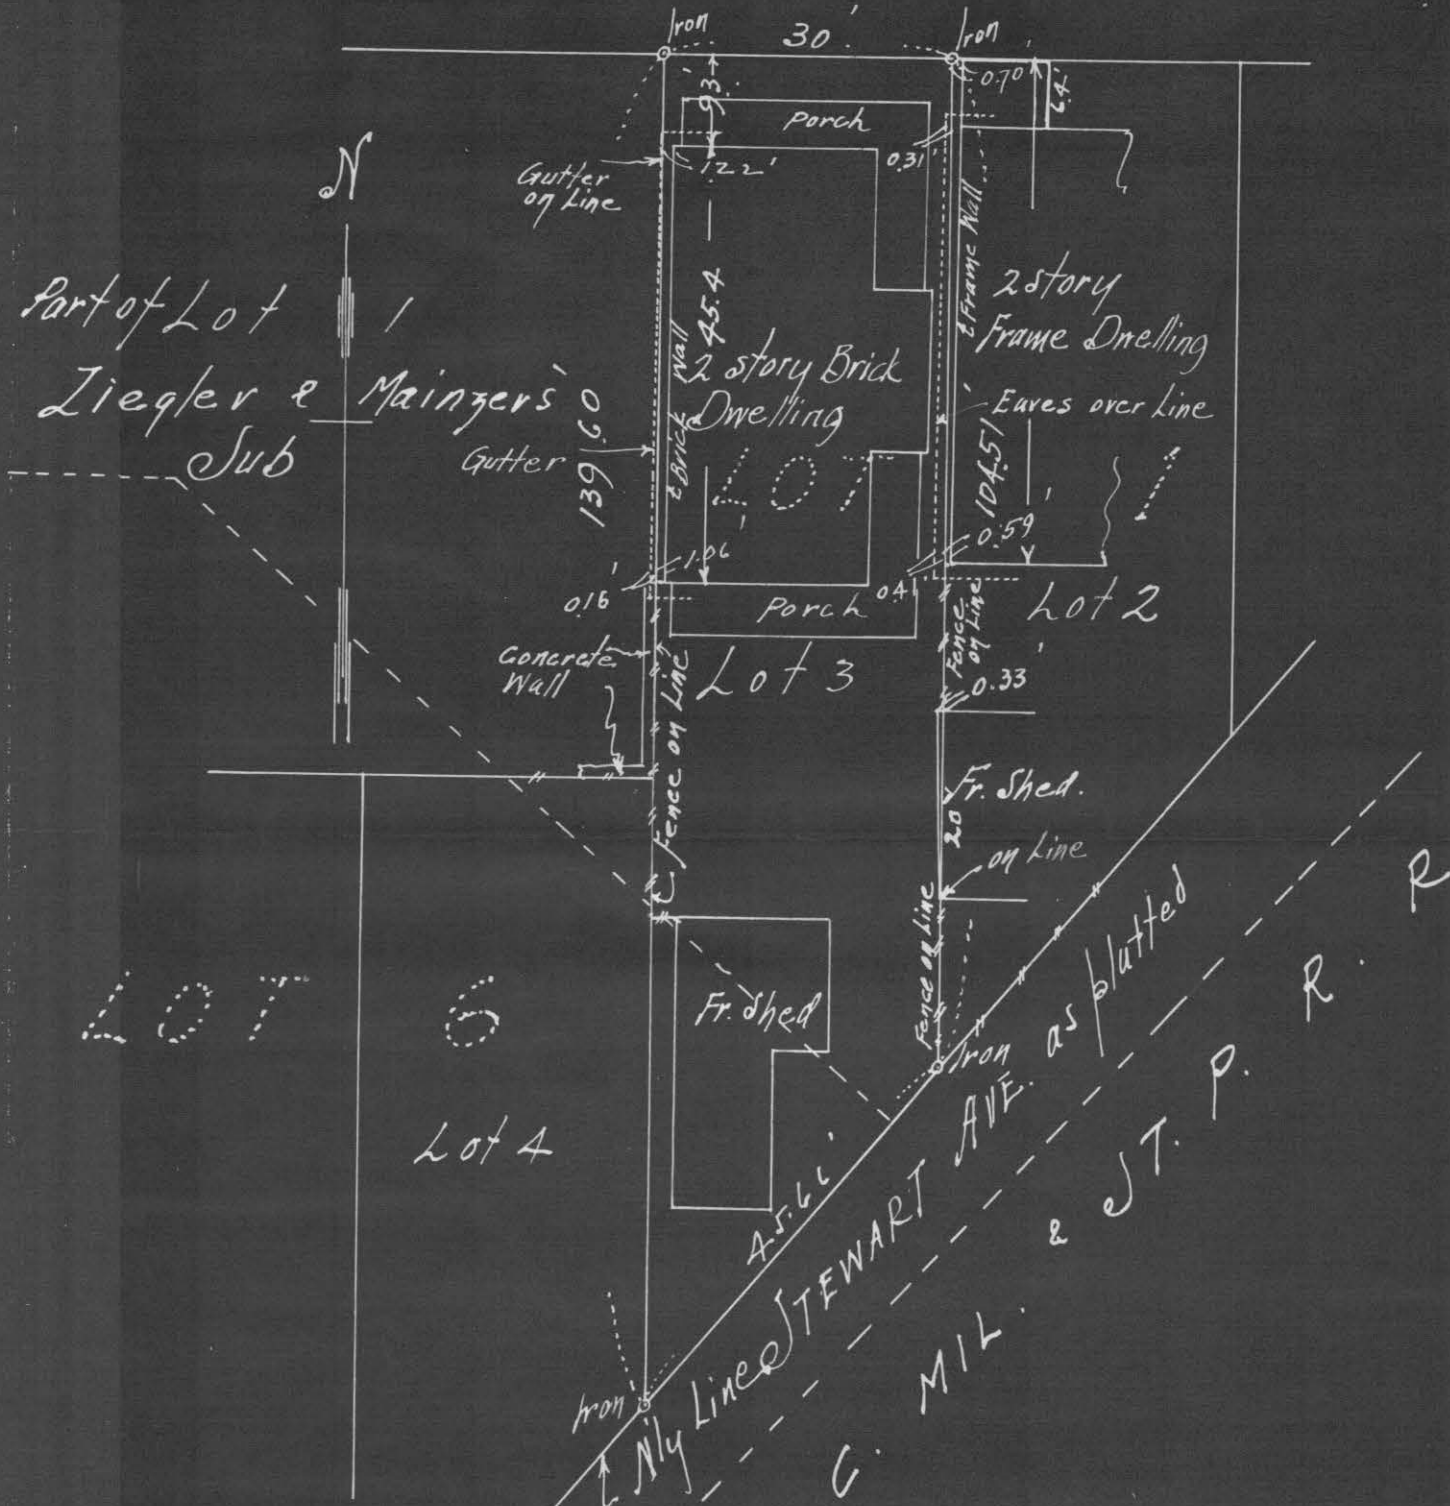

Scale 20 feet per inch

I HEREBY CERTIFY that on the 11<sup>th</sup> day of July, A. D. 1942

I made a survey of the following described property, to-wit: Lot 3 of Fischer 940 Lineaus Sub. of part of Lots 1 + 6 Ziegler & Mainzers Sub. of Block 13 Winslow's Addn. St. Paul, Minn.

and the map hereon shown is a true and correct map of said survey and that the improvements thereon indicated are correctly shown.

Subscribed and sworn to before me this \_\_\_\_\_ day of \_\_\_\_\_, 19\_\_\_\_

Notary Public.

My Commission Expires \_\_\_\_\_

*F. J. Armstrong*  
Civil Engineer.

4526