

SURVEY OF
W. 1/2 OF E. 2/3 OF LOTS 1 & 2, BLK. 96,
WEST ST. PAUL PROPER.

SEPT., 14, 1942.


R. H. Holgram
REGISTERED LAND SURVEYOR.

SCALE - 1 IN. = 30 FT.

GEORGE

ST. 60.

80.
AVE.
GORMAN

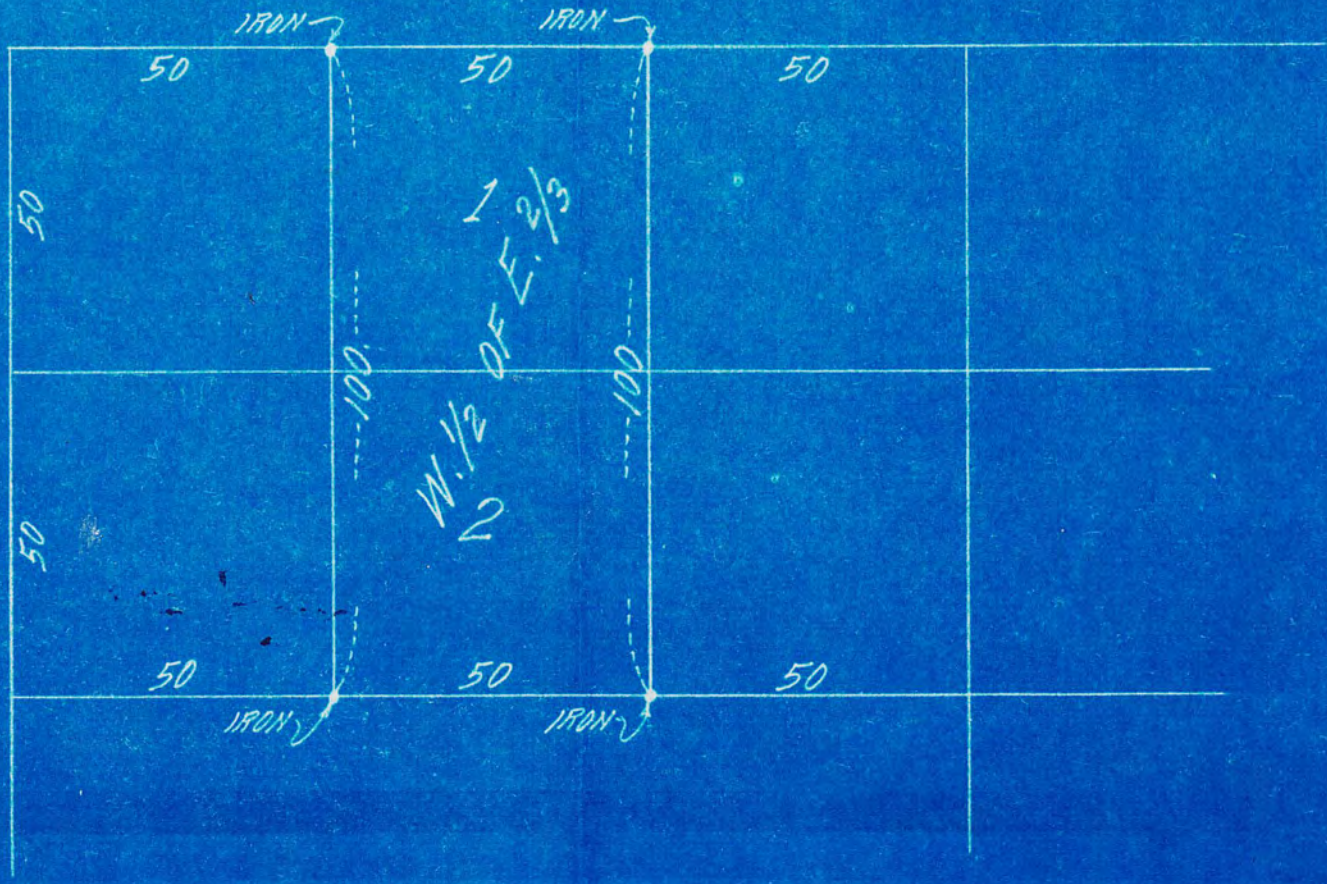

4539

4539