


# CERTIFICATE of SURVEY

F. J. ARMSTRONG  
Civil Engineer and Surveyor  
ST. PAUL, MINN.

FAIRFIELD AVE.

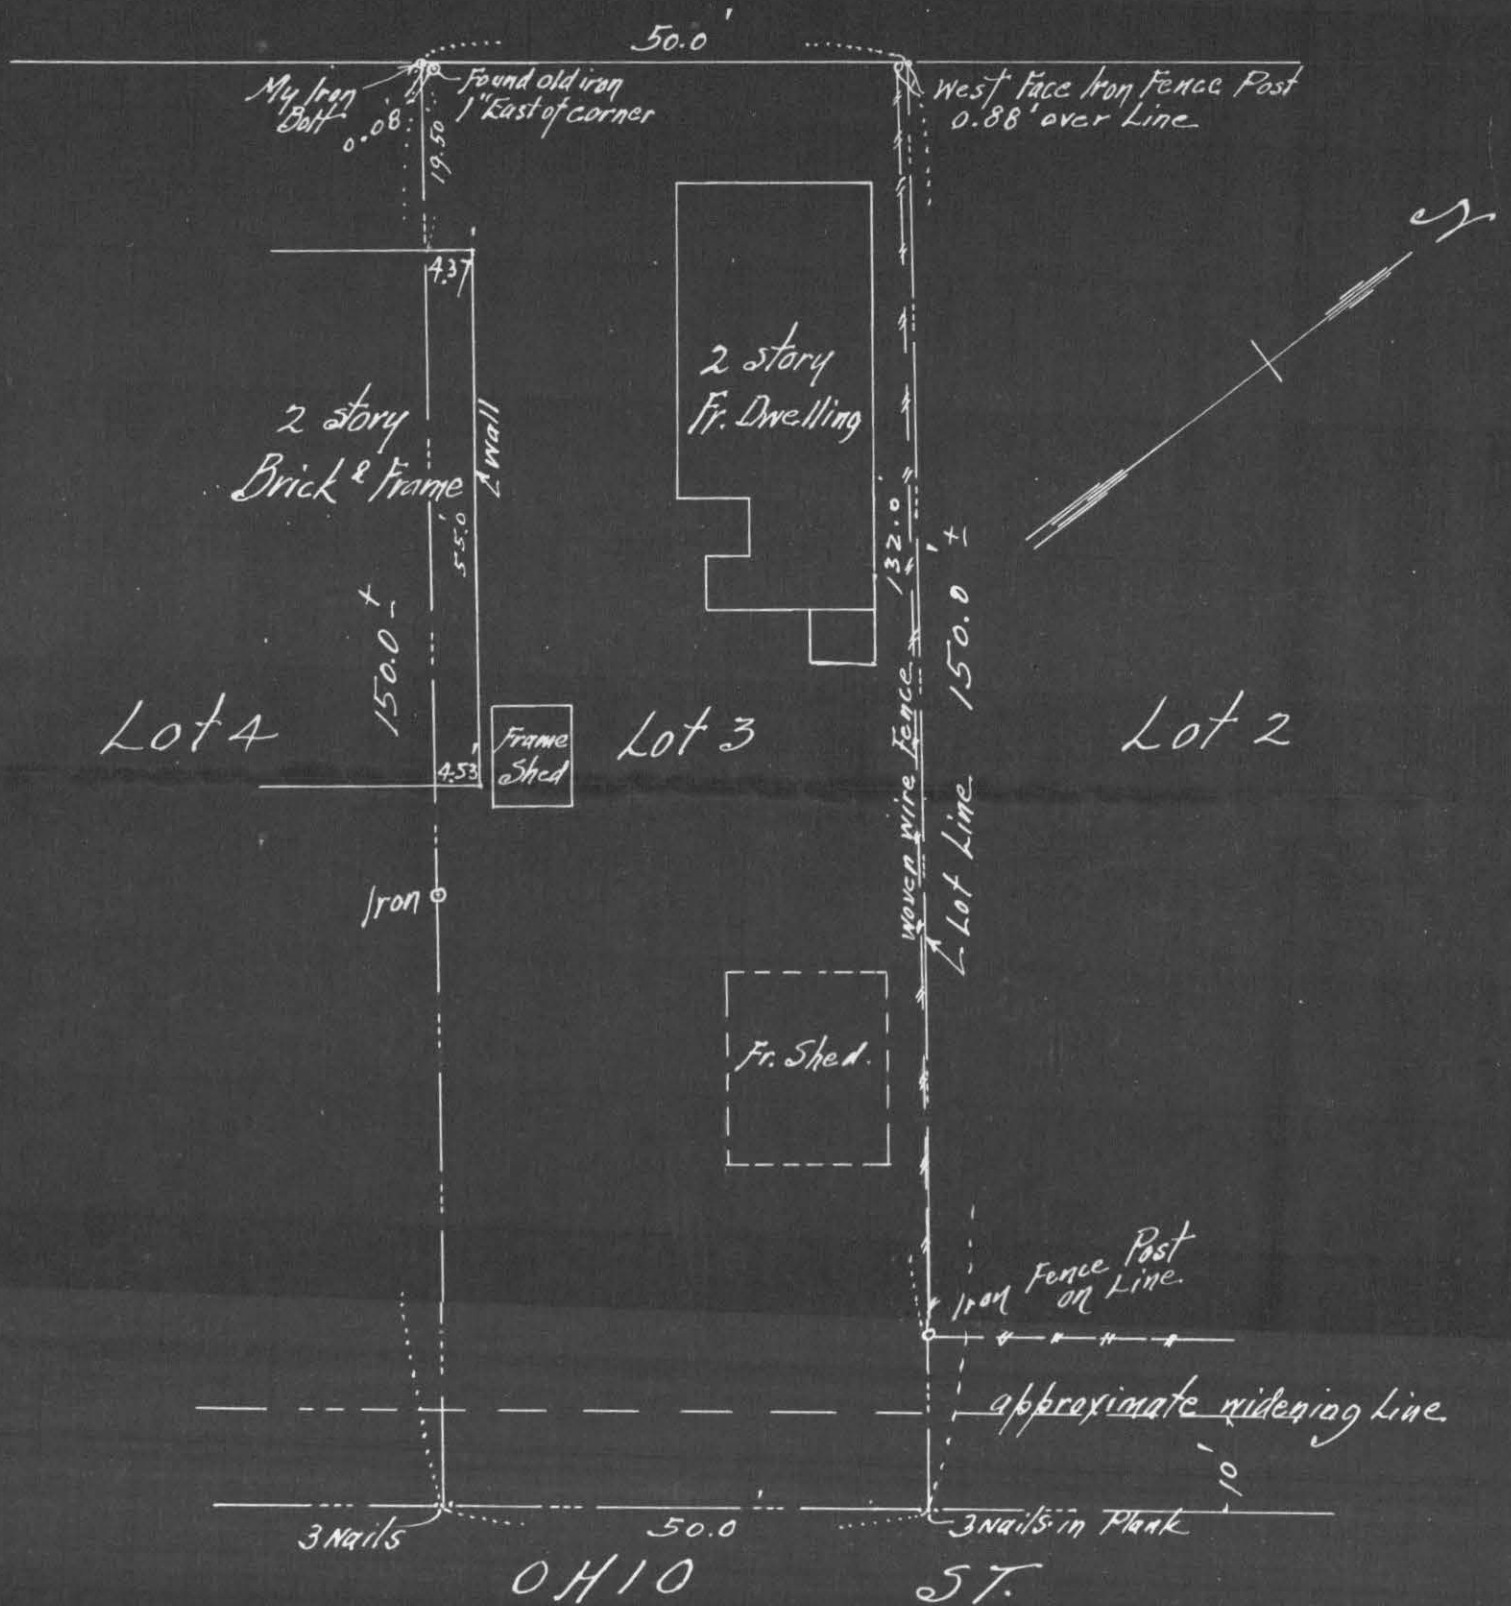

Scale 20ft. per inch

I HEREBY CERTIFY that on the 24<sup>th</sup> day of April A. D. 1943,  
I made a survey of the following described property, to-wit: Lot 3 Block 198  
Irvines Addn to W. St. Paul.  
St. Paul, Minn.

Subscribed and sworn to before me this  
..... day of ....., 19.....

Notary Public.

and the map hereon shown is a true and correct map of said survey and that the improvements thereon  
indicated are correctly shown.

My Commission Expires.....

*F. J. Armstrong*  
Civil Engineer.

# 4577