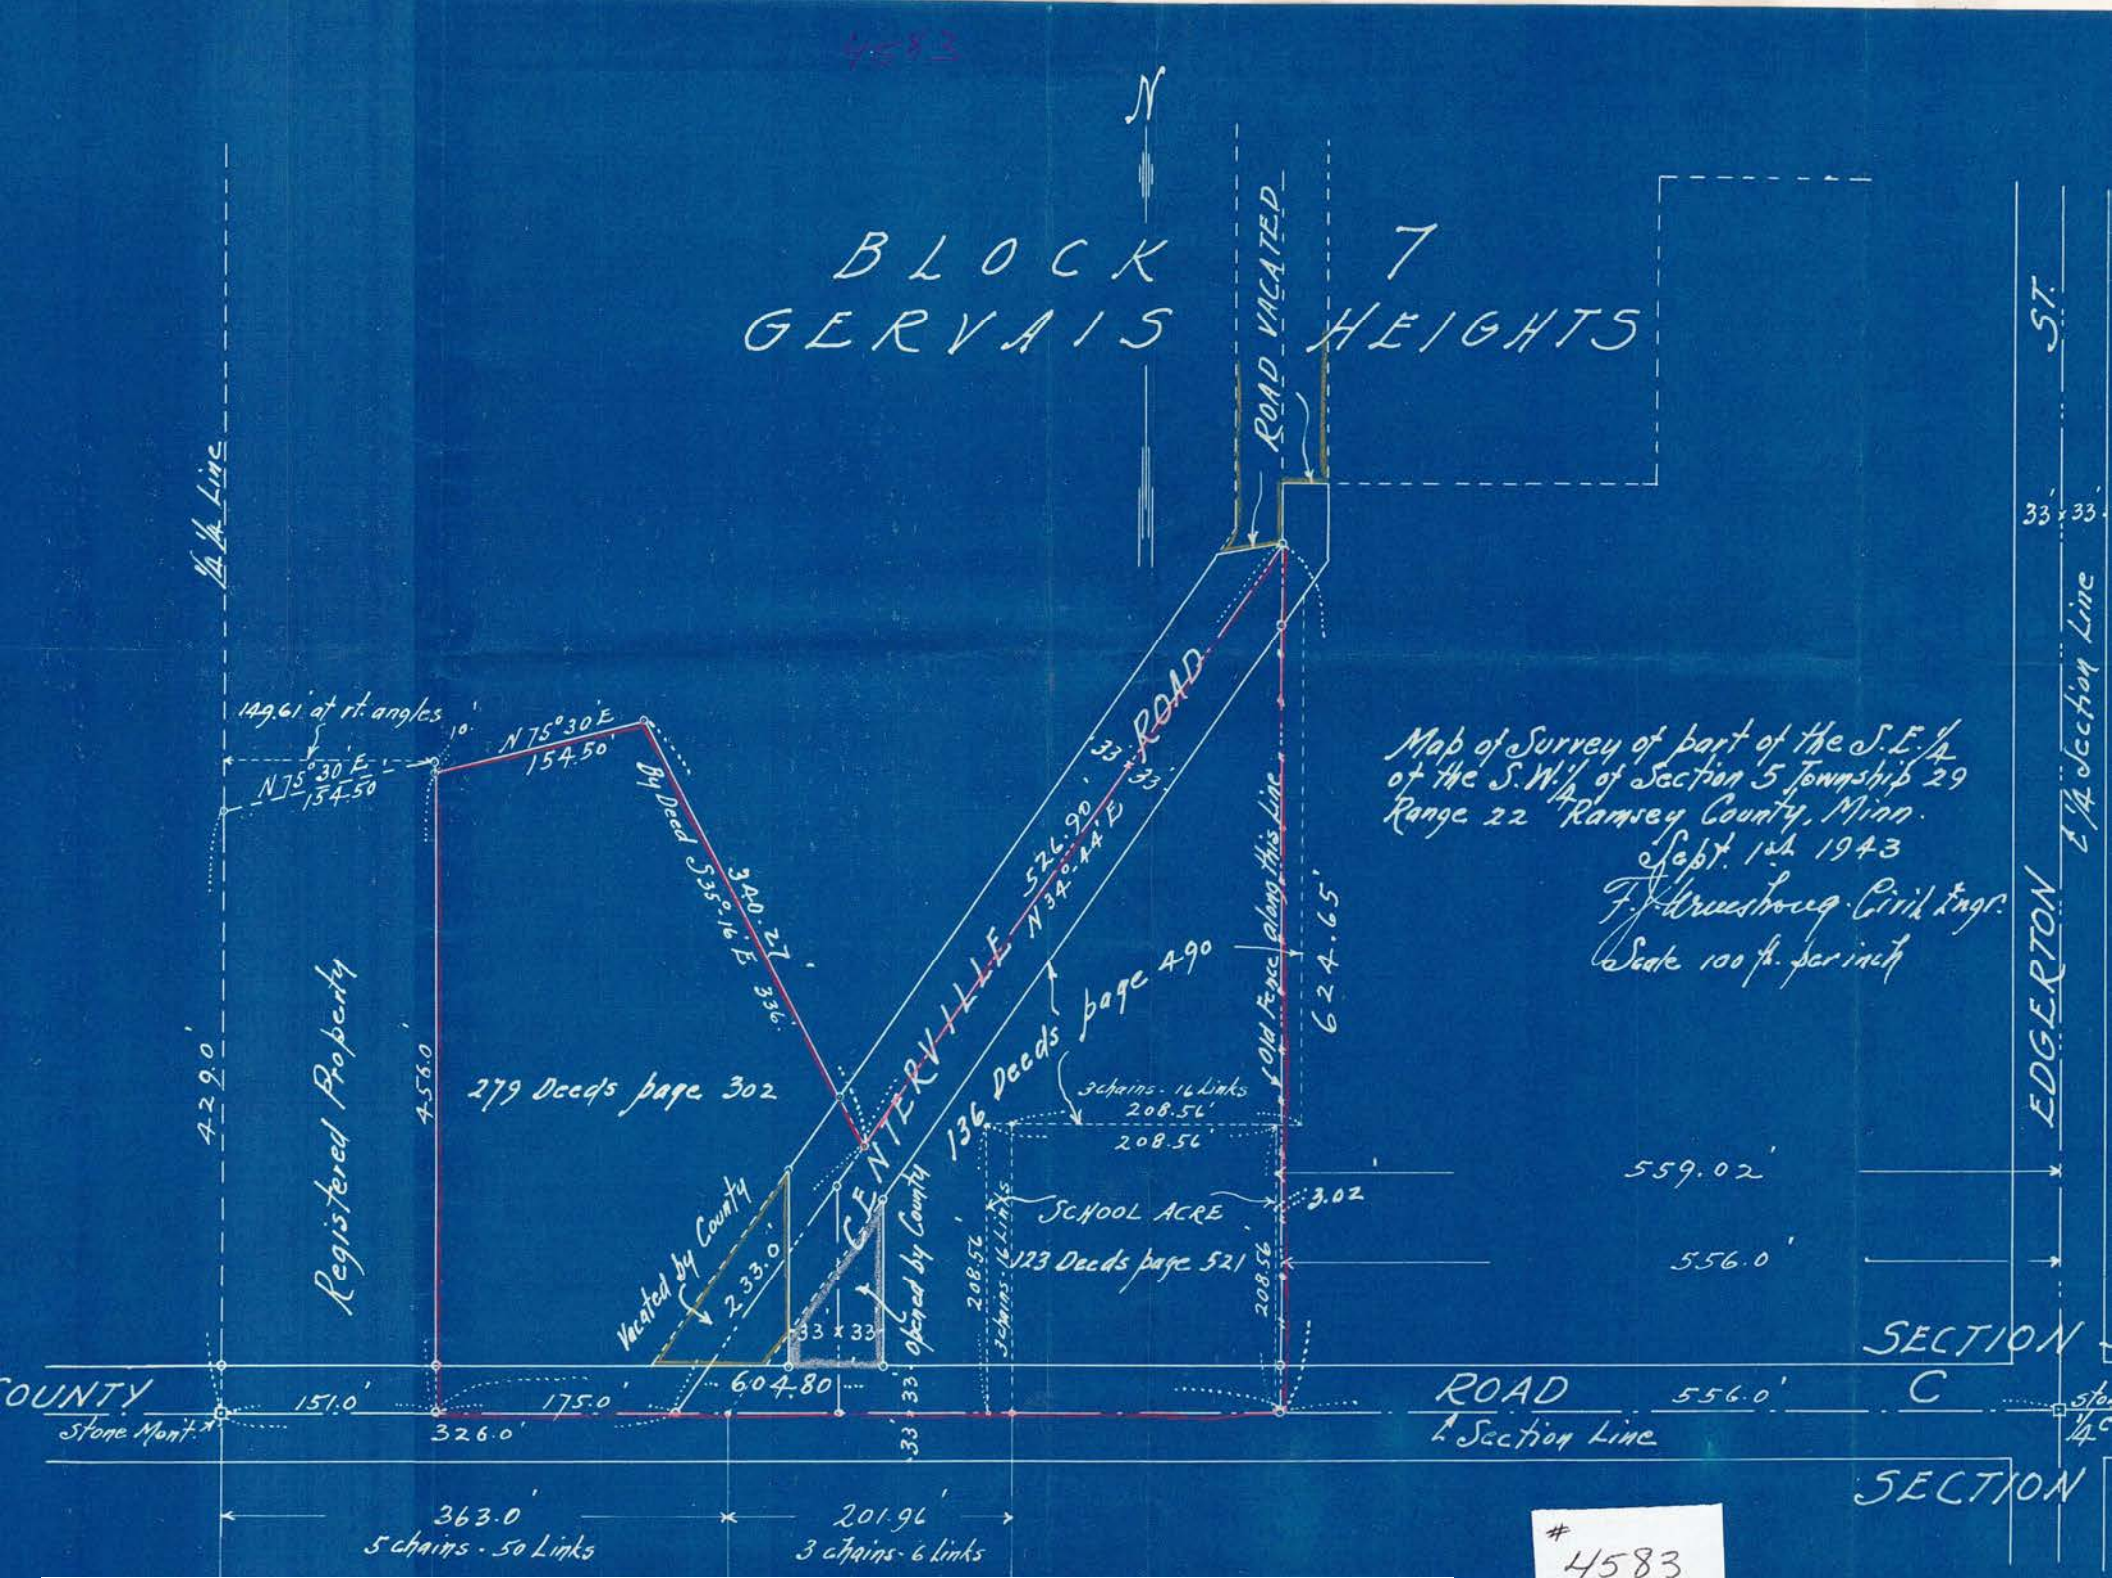

4583
N
BLOCK 7
GERVAIS HEIGHTS
ROAD VACATED
ST.
33' x 33'
1/4 1/4 Line
149.61' at rt. angles
10'
N 75° 30' E
154.50'
N 75° 30' E
154.50'
By Deed S 35° 16' E 336'
340.27'
CENTERVILLE ROAD
526.90'
N 34° 44' E
33
33
Old Fence along this Line
624.65'
Map of Survey of part of the S.E. 1/4 of the S.W. 1/4 of Section 5 Township 29 Range 22 Ramsey County, Minn.
Sept. 1st 1943
F. J. Hrueshoug Civil Engr.
Scale 100 ft. per inch
EDGERTON
1/4 Section Line
429.0'
Registered Property
456.0'
279 Deeds page 302
136 Deeds page 490
3 chains - 16 Links
208.56'
208.56'
559.02'
3.02
SCHOOL ACRE
123 Deeds page 521
556.0'
Vacated by County
233.0'
33 x 33
Opened by County
208.56
3 chains - 16 Links
208.56
SECTION
COUNTY
151.0'
175.0'
604.80
33 x 33
ROAD
556.0'
C
Stone Mont.
326.0'
1/4 Section Line
SECTION
363.0'
5 chains - 50 Links
201.96'
3 chains - 6 Links
#4583