DESCRIPTION, West 66 feet of East 132 feet of South 383.3 feet of SW. 1/4 of SE 1/4 of SE 1/4 of Sec. 4-29-22. ---- West 75 feet of East 207 feet of South 308.3 feet of SW. 1/4 of SE 1/4 of SE 1/4 of Sec. 4-29-22.

Scale 1 inch = 50 feet

T. J. Welch. Reg. Surveyor.
738 Surrey Ave. St. Paul, Minn.
Tel. To. 0640.

Dec. 1943.

SW 1/4 of SE 1/4 of SE 1/4 of Sec. 4-29-22

SW 1/4 of SE 1/4 of SE 1/4 of Sec. 4-29-22

Scale 1 inch = 50 feet.

NORTH

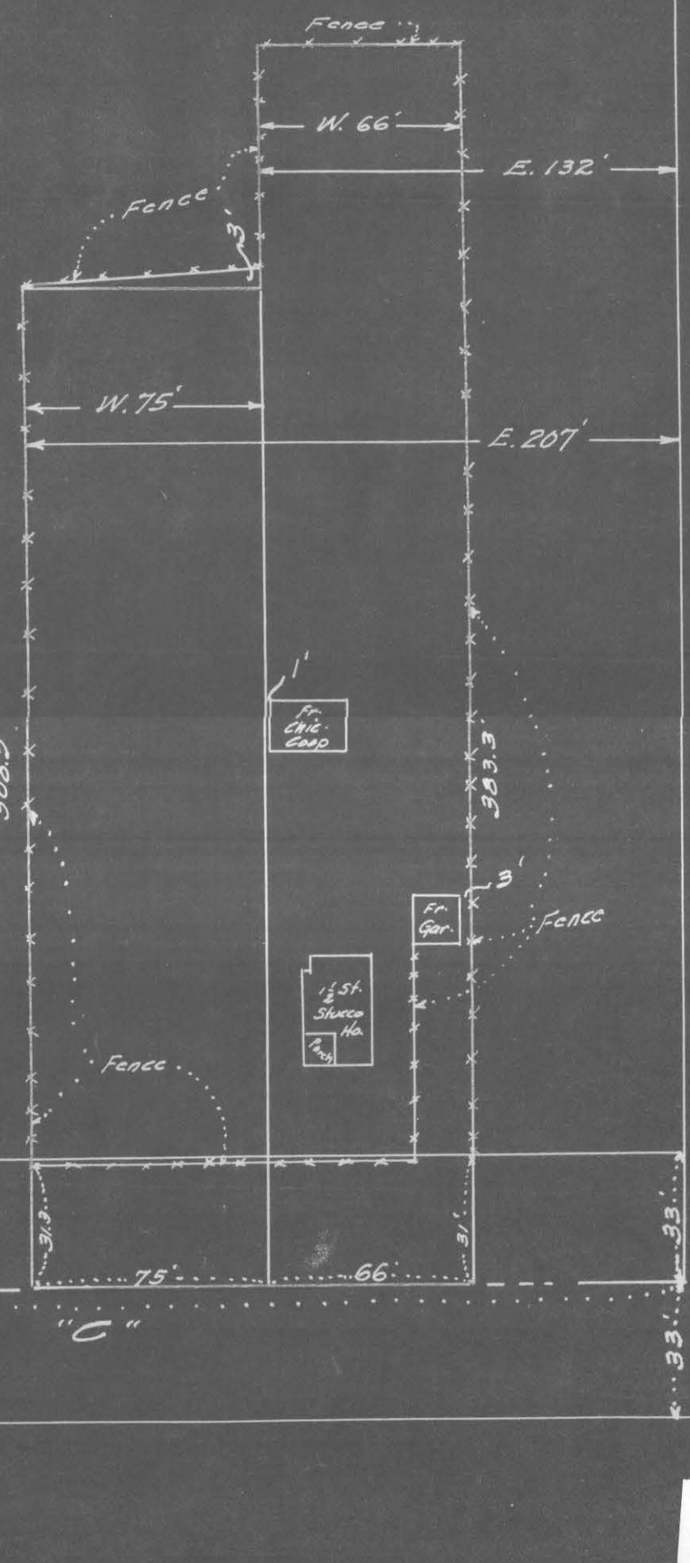

#4616