


# CERTIFICATE of SURVEY

F. J. ARMSTRONG  
Civil Engineer and Surveyor  
ST. PAUL, MINN.

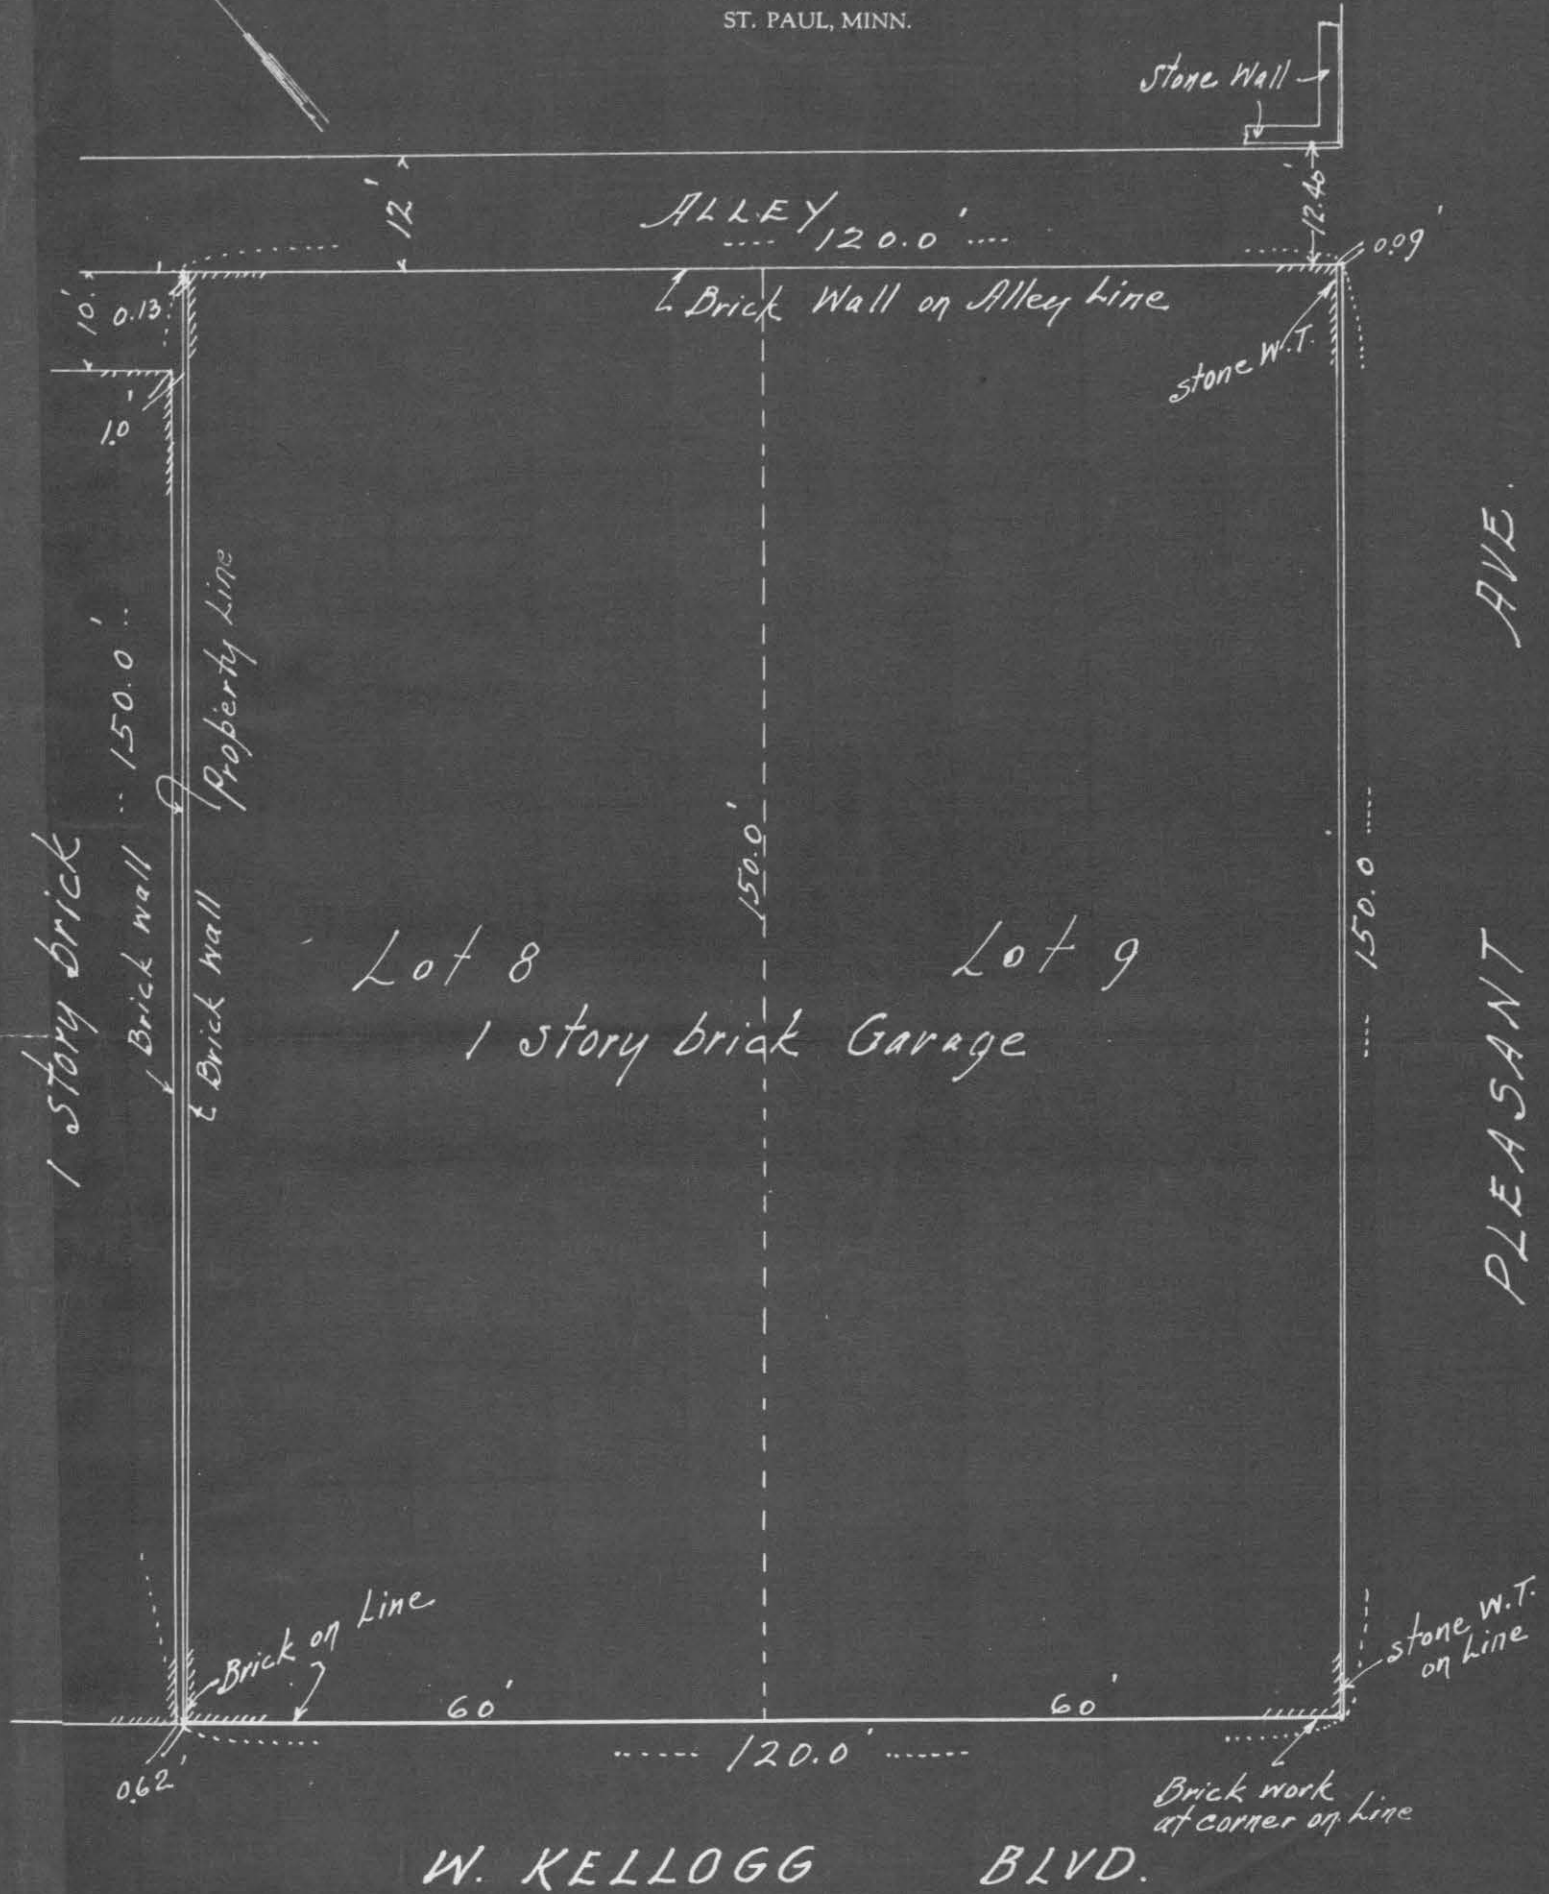

Lot 8                      Lot 9  
1 story brick Garage

W. KELLOGG                      BLVD.

Scale 20 ft. per inch

I HEREBY CERTIFY that on the 29<sup>th</sup> day of April, A. D. 1944,

I made a survey of the following described property, to-wit: Lots 8 & 9 in Block 61 of Irvines Enlargement of Rice and Irvine's Addition to the Town of St. Paul

and the map hereon shown is a true and correct map of said survey and that the improvements thereon indicated are correctly shown.

Subscribed and sworn to before me this \_\_\_\_\_ day of \_\_\_\_\_, 19\_\_\_\_\_

Notary Public.

My Commission Expires \_\_\_\_\_

*F. J. Armstrong*  
Civil Engineer.

4653