


# CERTIFICATE of SURVEY

F. J. ARMSTRONG  
Civil Engineer and Surveyor  
ST. PAUL, MINN.

EAST FIFTH ST.

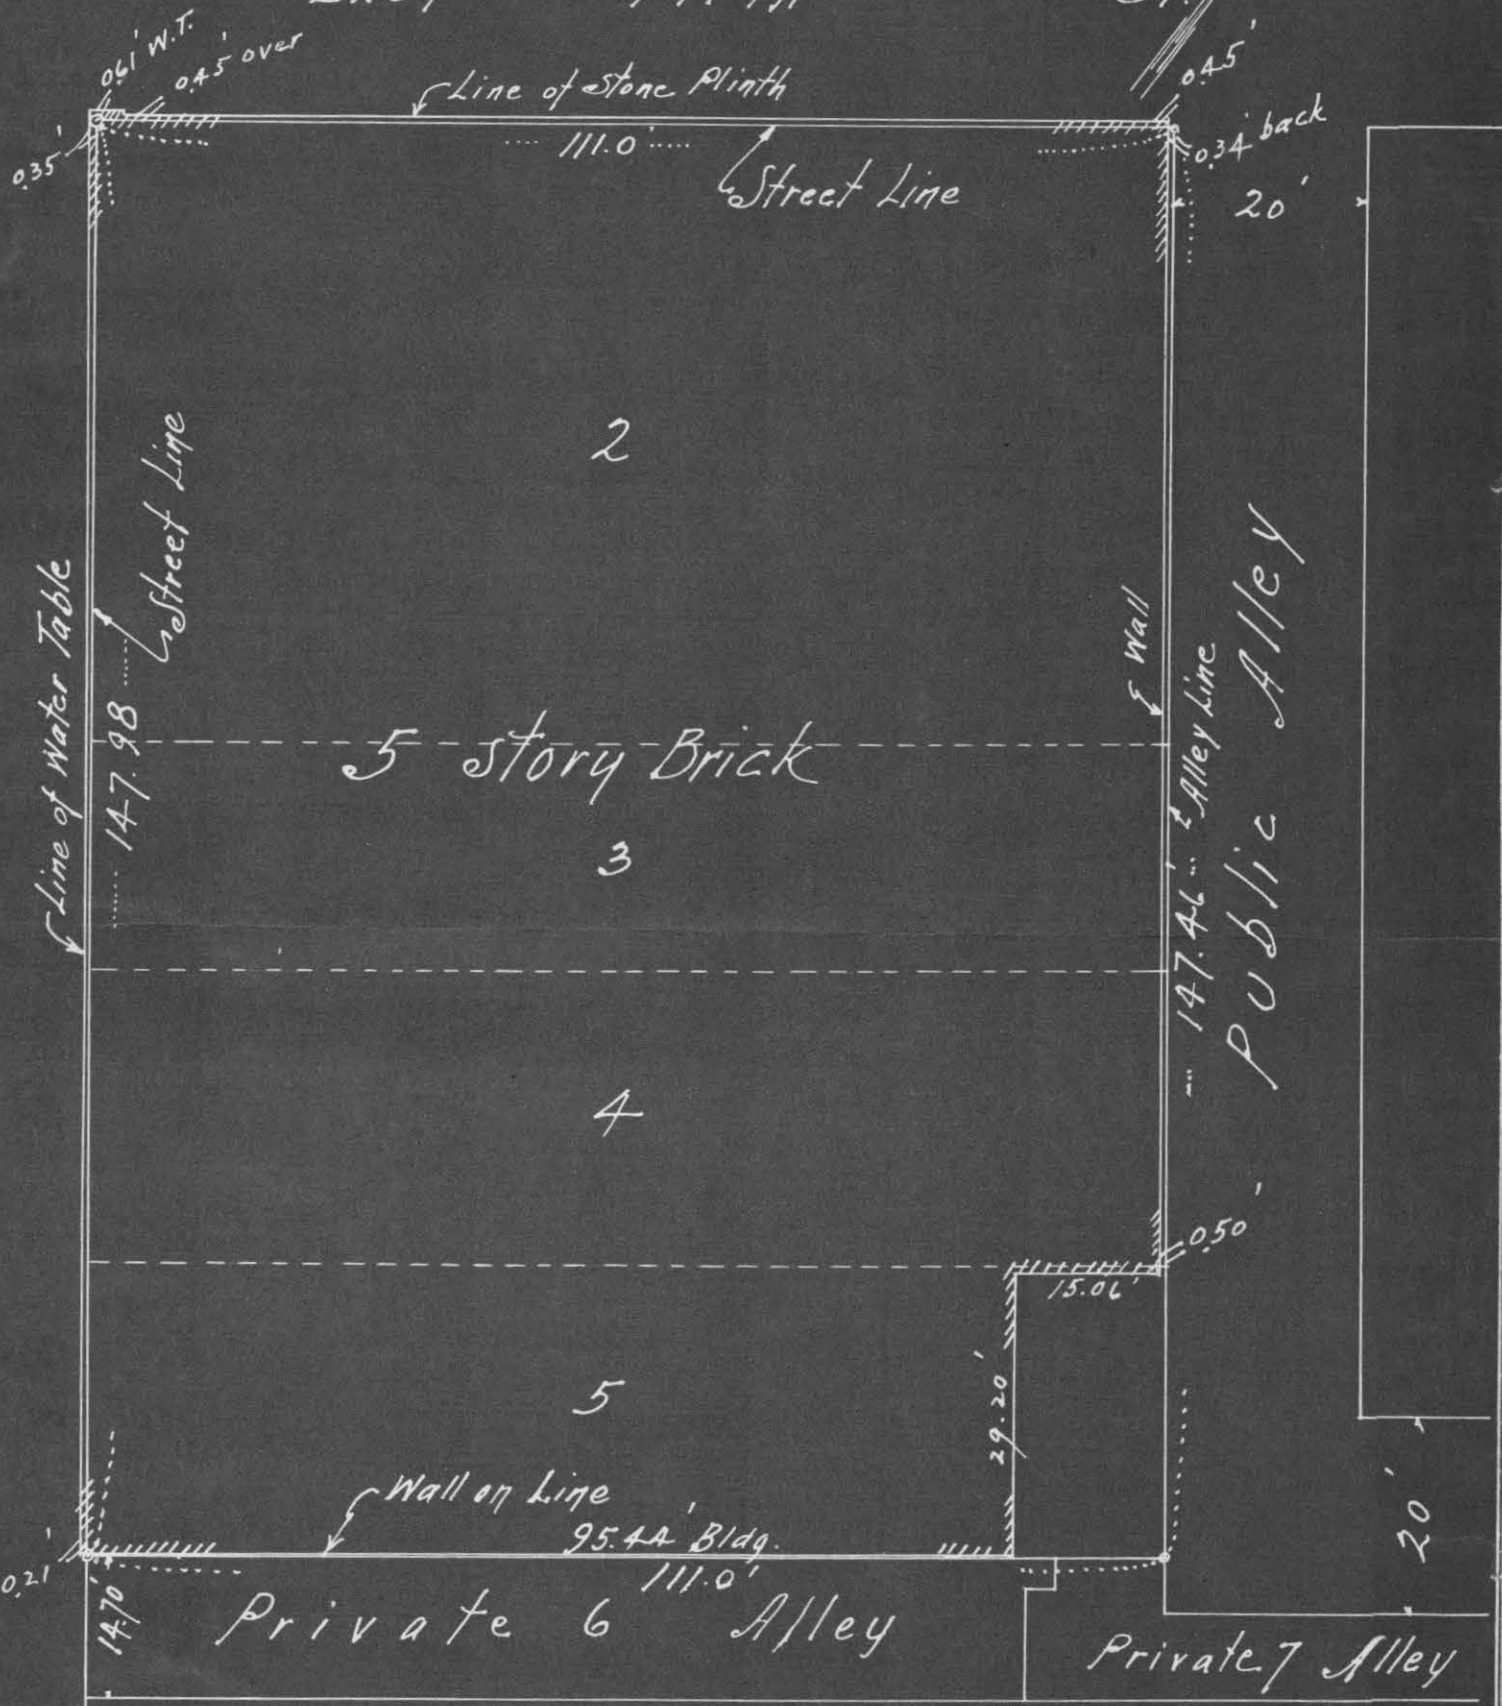

Scale 20 ft. per inch

I HEREBY CERTIFY that on the 15<sup>th</sup> day of January A. D. 1944  
I made a survey of the following described property, to-wit: Lots 2-3-4-5, Blk. 1  
Auditor's Sub. No 32 - St. Paul, Minn.

Subscribed and sworn to before me this  
..... day of ....., 19.....

Notary Public.

and the map hereon shown is a true and correct map of said survey and that the improvements thereon  
indicated are correctly shown.....

My Commission Expires.....

*F. J. Armstrong*  
Civil Engineer.

#4654