

ABSTRACT OF TITLE.

Prepared by The St. Paul Abstract Company.

No. 1

*File
T 1519
Warrant
R 6*

To

*Lots 2 & 3 (except W. 5 feet of Lot 3 & alley)
Block 15*

Whitney Smiths Addition to St Paul


State of Minnesota, }

County of Ramsey. }

The St. Paul Abstract Company does hereby certify that the following exhibit, consisting of 21 sheets, from 1 to 21 inclusive (each of which bears its Corporate Seal), and 131 entries from 1 to 127, 64, 106 inclusive, is a true and complete Abstract of Title to the real estate described in No. 1 hereof, as shown by the records in the office of the Register of Deeds in and for said County and State, up to this 13th day of September 1906 at 8 o'clock A. M.

THE ST. PAUL ABSTRACT COMPANY,
ABSTRACTERS.

J. A. Suchman
VICE-PRESIDENT

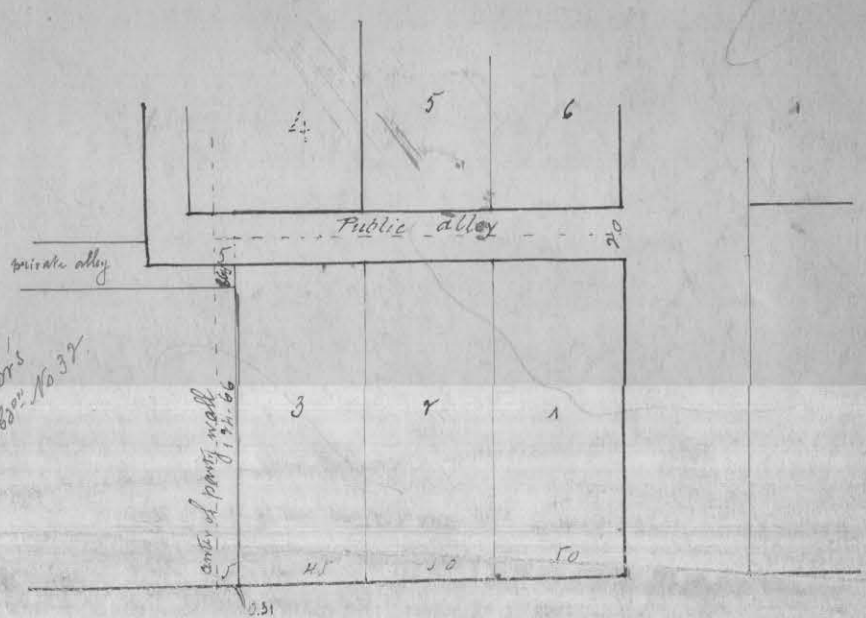

Form

4673

4673