


CERTIFICATE of SURVEY

F. J. ARMSTRONG
Civil Engineer and Surveyor
ST. PAUL, MINN.

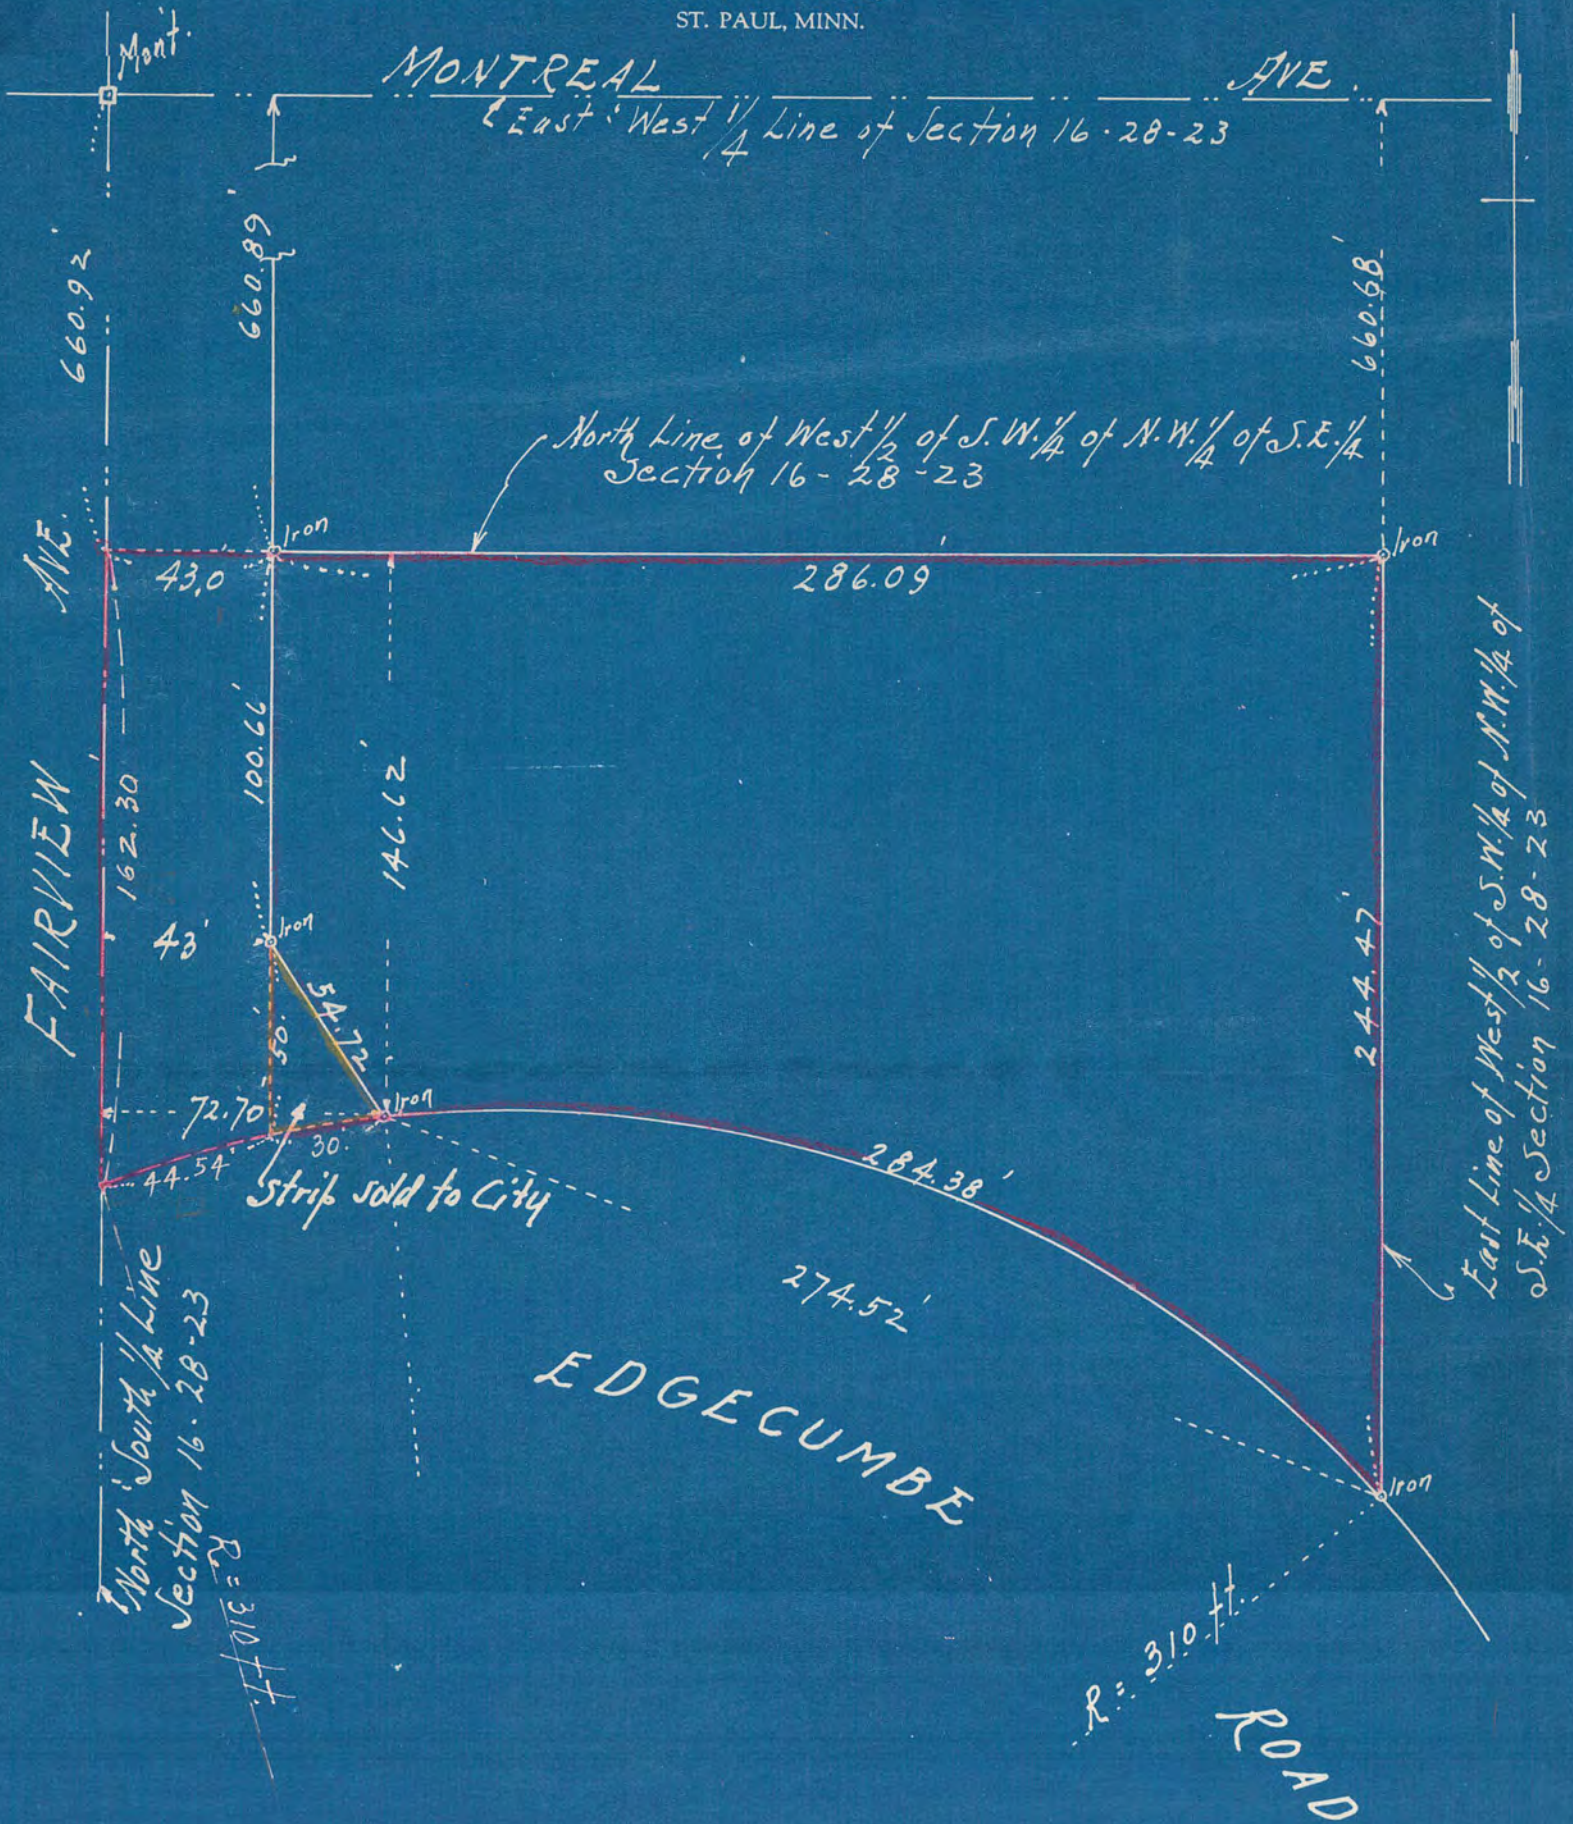

Scale 50 ft. per inch

I HEREBY CERTIFY that on the 27th day of April, A. D. 1944

I made a survey of the following described property, to-wit: Part of the West 1/2 of the S.W. 1/4 of the N.W. 1/4 of the S.E. 1/4 of Section 16 Township 28 Range 23 lying north of Edgumbe Road.

and the map hereon shown is a true and correct map of said survey and that the improvements thereon indicated are correctly shown.

F. J. Armstrong
Civil Engineer.

4675