


CERTIFICATE of SURVEY

F. J. ARMSTRONG
Civil Engineer and Surveyor
ST. PAUL, MINN.

4696

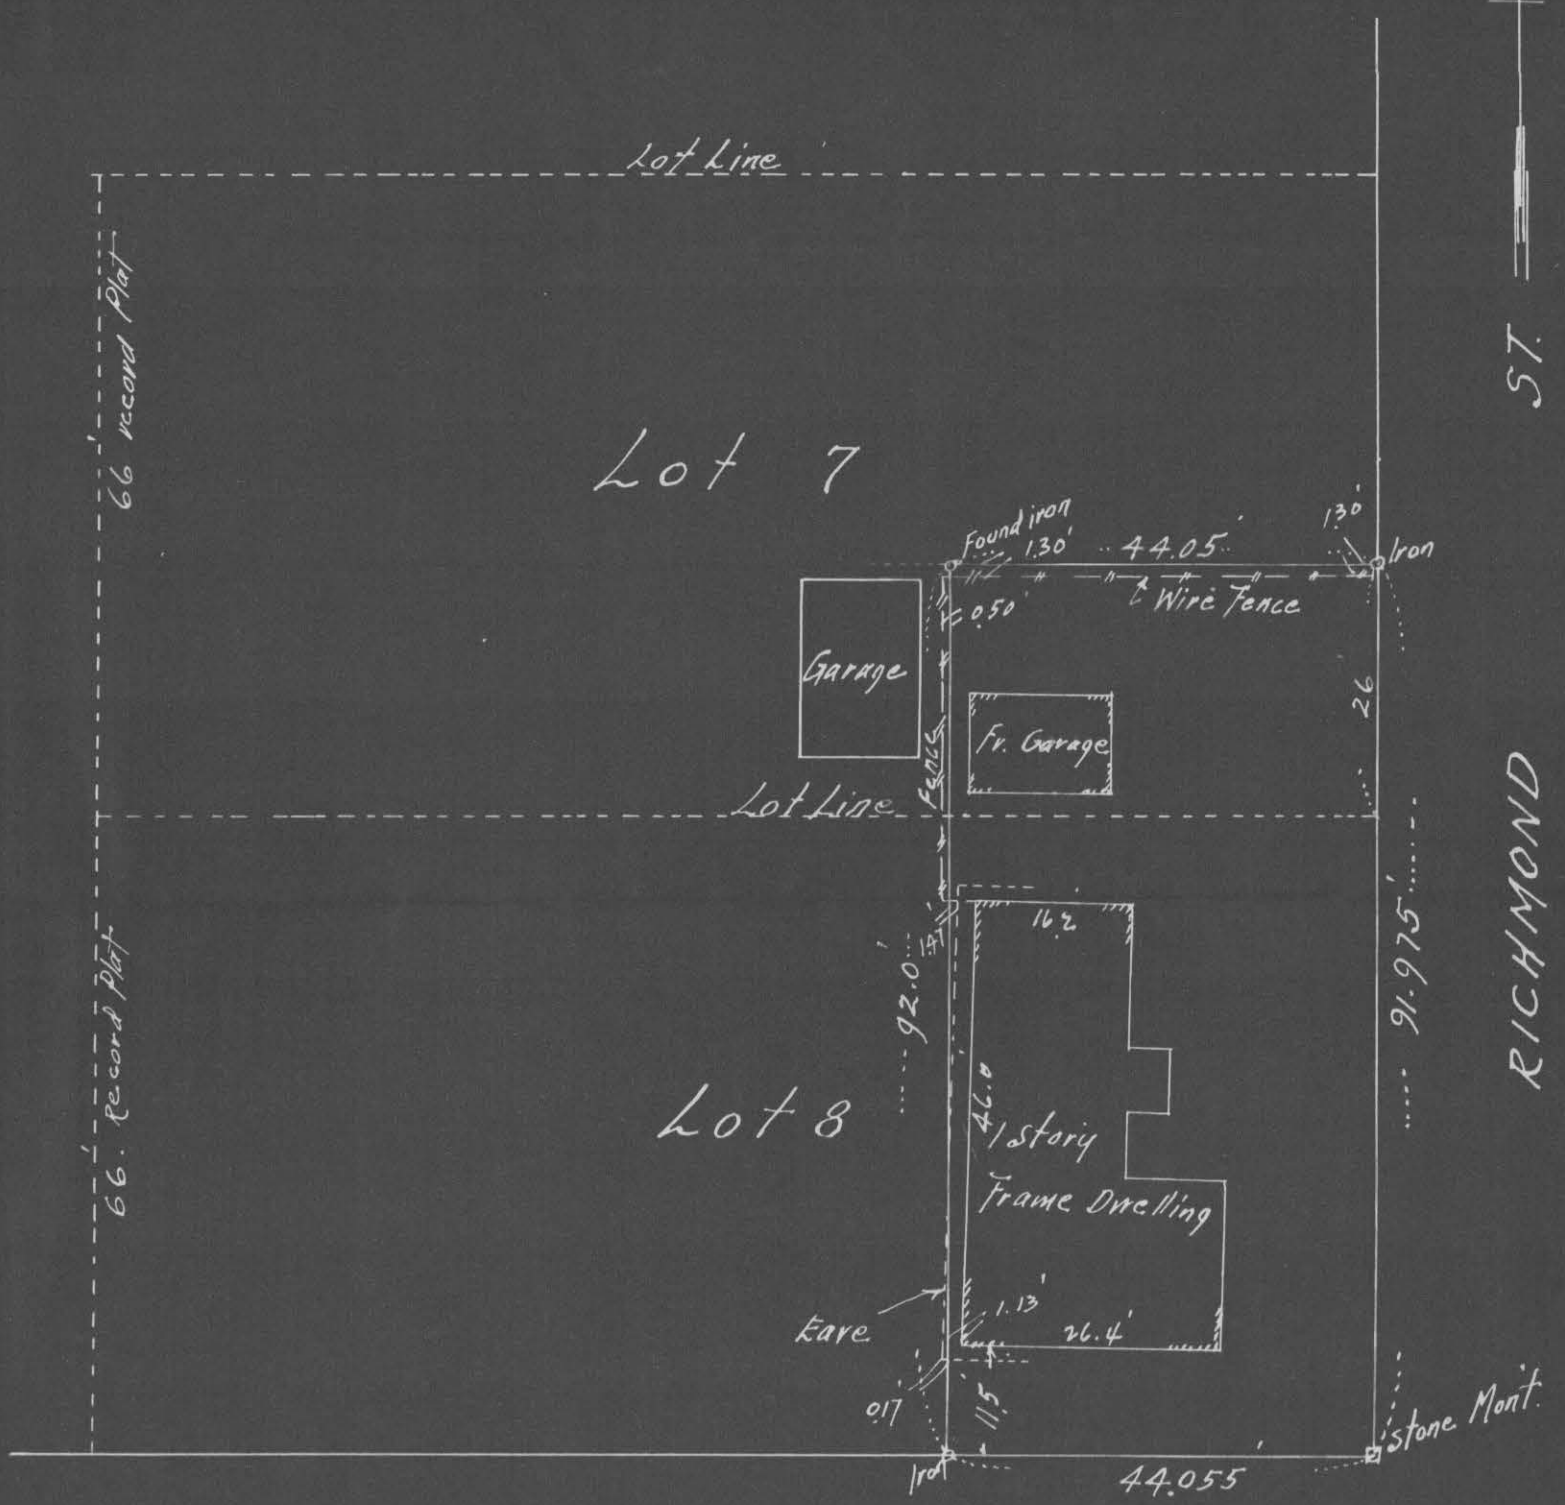

ST. CLAIR

ST.

Scale 20 feet per inch

I HEREBY CERTIFY that on the 3rd day of August, A. D. 19 44,

I made a survey of the following described property, to-wit: The Easterly 1/3 of Lot 8 and the Easterly 1/3 of the Southerly 26 feet of Lot 7, all in Block 4 Willes Addition to Saint Paul

and the map hereon shown is a true and correct map of said survey and that the improvements thereon indicated are correctly shown.

F. J. Armstrong
Civil Engineer.

Subscribed and sworn to before me this _____ day of _____, 19____

Notary Public.

My Commission Expires _____

4696