


# CERTIFICATE of SURVEY

F. J. ARMSTRONG  
Civil Engineer and Surveyor  
ST. PAUL, MINN.

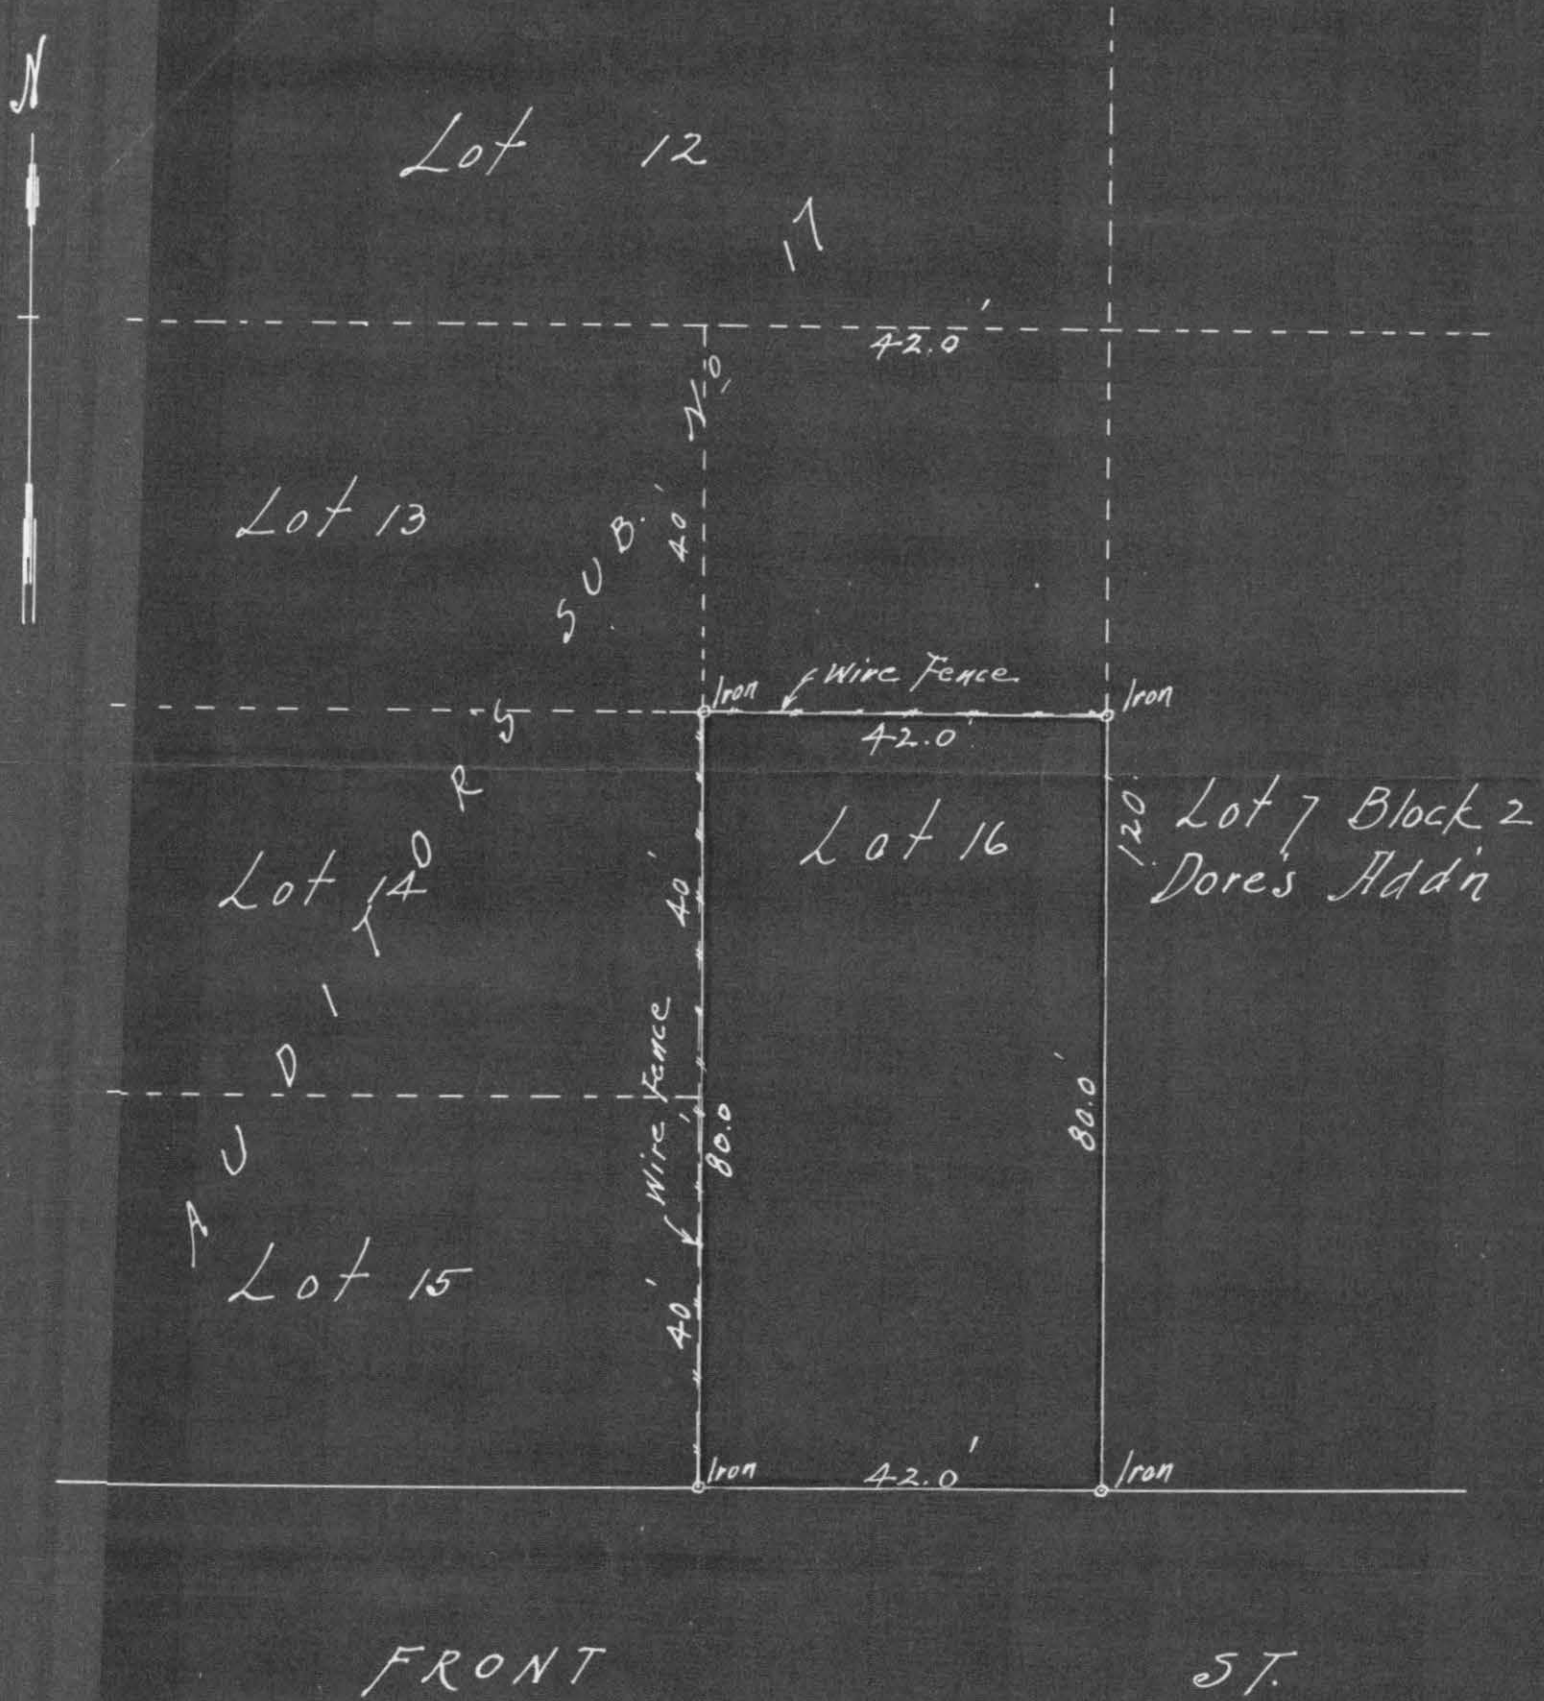

Scale 20 ft. per inch

I HEREBY CERTIFY that on the 7<sup>th</sup> day of September, A. D. 19 44,  
I made a survey of the following described property, to-wit: The south 80 feet of  
Lot 16 Auditor's Subdivision No 17  
St. Paul, Minn.

Subscribed and sworn to before me this  
..... day of ....., 19.....

Notary Public.

and the map hereon shown is a true and correct map of said survey and that the improvements thereon  
indicated are correctly shown.....

My Commission Expires.....

*F. J. Armstrong*  
Civil Engineer.

# 4707