

4713

STATE OF MINNESOTA  
COUNTY OF RAMSEY

DISTRICT COURT  
SECOND JUDICIAL DISTRICT  
File #4713

-----  
IN THE MATTER OF THE APPLICATION  
OF HENRY L. ORME, EXECUTOR, TO  
REGISTER TITLE  
-----

STATE OF MINNESOTA )  
COUNTY OF RAMSEY ) SS

F. J. ARMSTRONG came before me personally and being first duly sworn on oath, deposes and says that he is a surveyor and civil engineer in the city of St. Paul, Minnesota; that on the reverse side hereof is a true and correct blue print of a survey made by deponent September 25, 1944, of Lots three (3), four (4), five (5), and six (6), Block twenty-three (23), Summit Park Addition to St. Paul, together with the property immediately east of said Lot three (3), and the property immediately west of said Lot six (6).

*F. J. Armstrong*  
F. J. Armstrong

Subscribed and sworn to before me  
this 25th day of September, 1944.


*Paul D. Schriber*  
PAUL D. SCHRIBER, Notary Public  
Ramsey County, Minnesota  
My commission expires July 31, 1949.

4713

(seal)

**FILED**  
SEP 25 1944  
J. J. FITZGERALD, Clerk  
By *J. J. Fitzgerald* Deputy

GRAND AVE

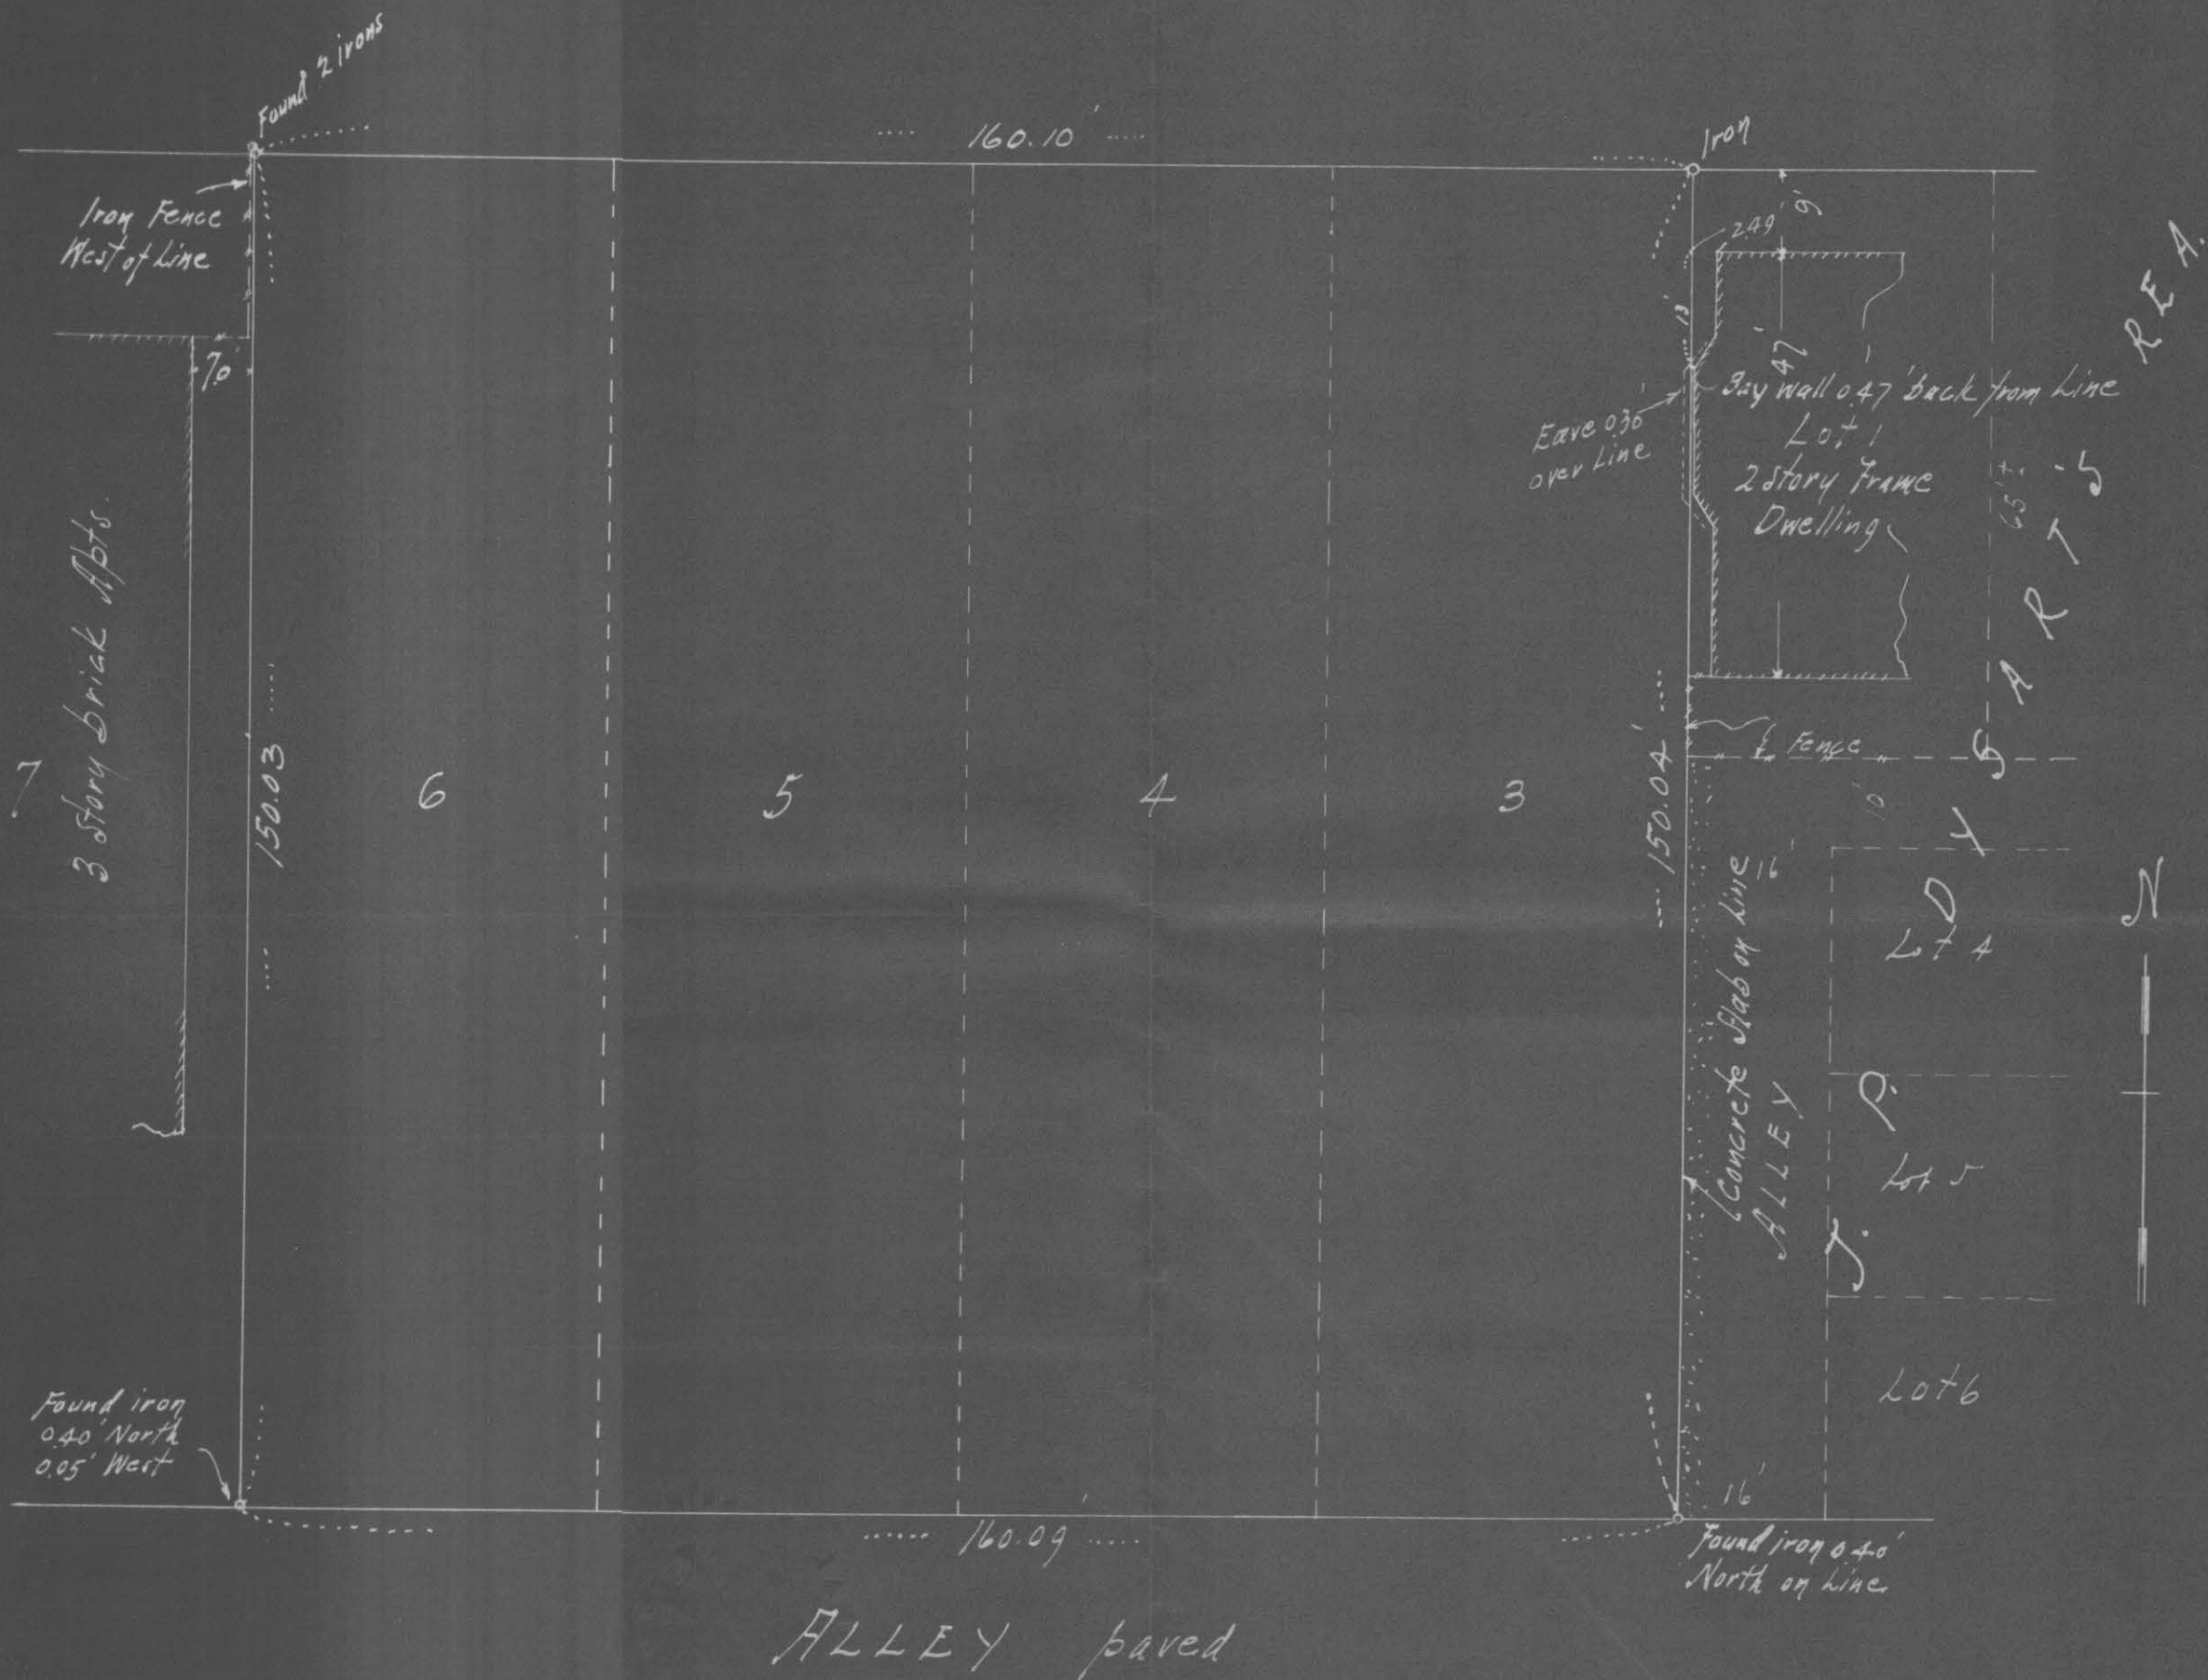

MAP OF SURVEY OF LOTS 3-4-5+6  
 BLOCK 23 SUMMIT PARK  
 ST. PAUL, MINN.

Scale 20 ft. per inch

Sept. 25<sup>th</sup> 1944  
 F. Armstrong - Civil Engr.

# 4713