


SURVEY OF

The East one-half (E 1/2) of the Northwest quarter (NW 1/4) of the Southeast quarter (SE 1/4) of Section Ten (10), Township Twenty-nine (29), Range Twenty-three (23) and the Northwest quarter (NW 1/4) of the Northwest quarter (NW 1/4) of the Southeast quarter (SE 1/4) of said Section Ten (10), Township Twenty-nine (29), Range Twenty-three (23), except the South one hundred thirty-three (S. 133) feet of the North Four hundred thirty (N. 430) feet of the West quarter of the Northwest quarter of the Southeast quarter of said Section Ten (10), Township Twenty-nine (29), Range Twenty-three (23), according to the United States Government Survey thereof

J. J. Welch, Reg. Surveyor.  
738 Murray Ave  
St. Paul, Minn.  
Tel. To. 0640. Oct 28-44.

Scale 1 inch = 200 ft.      O = Iron Monument

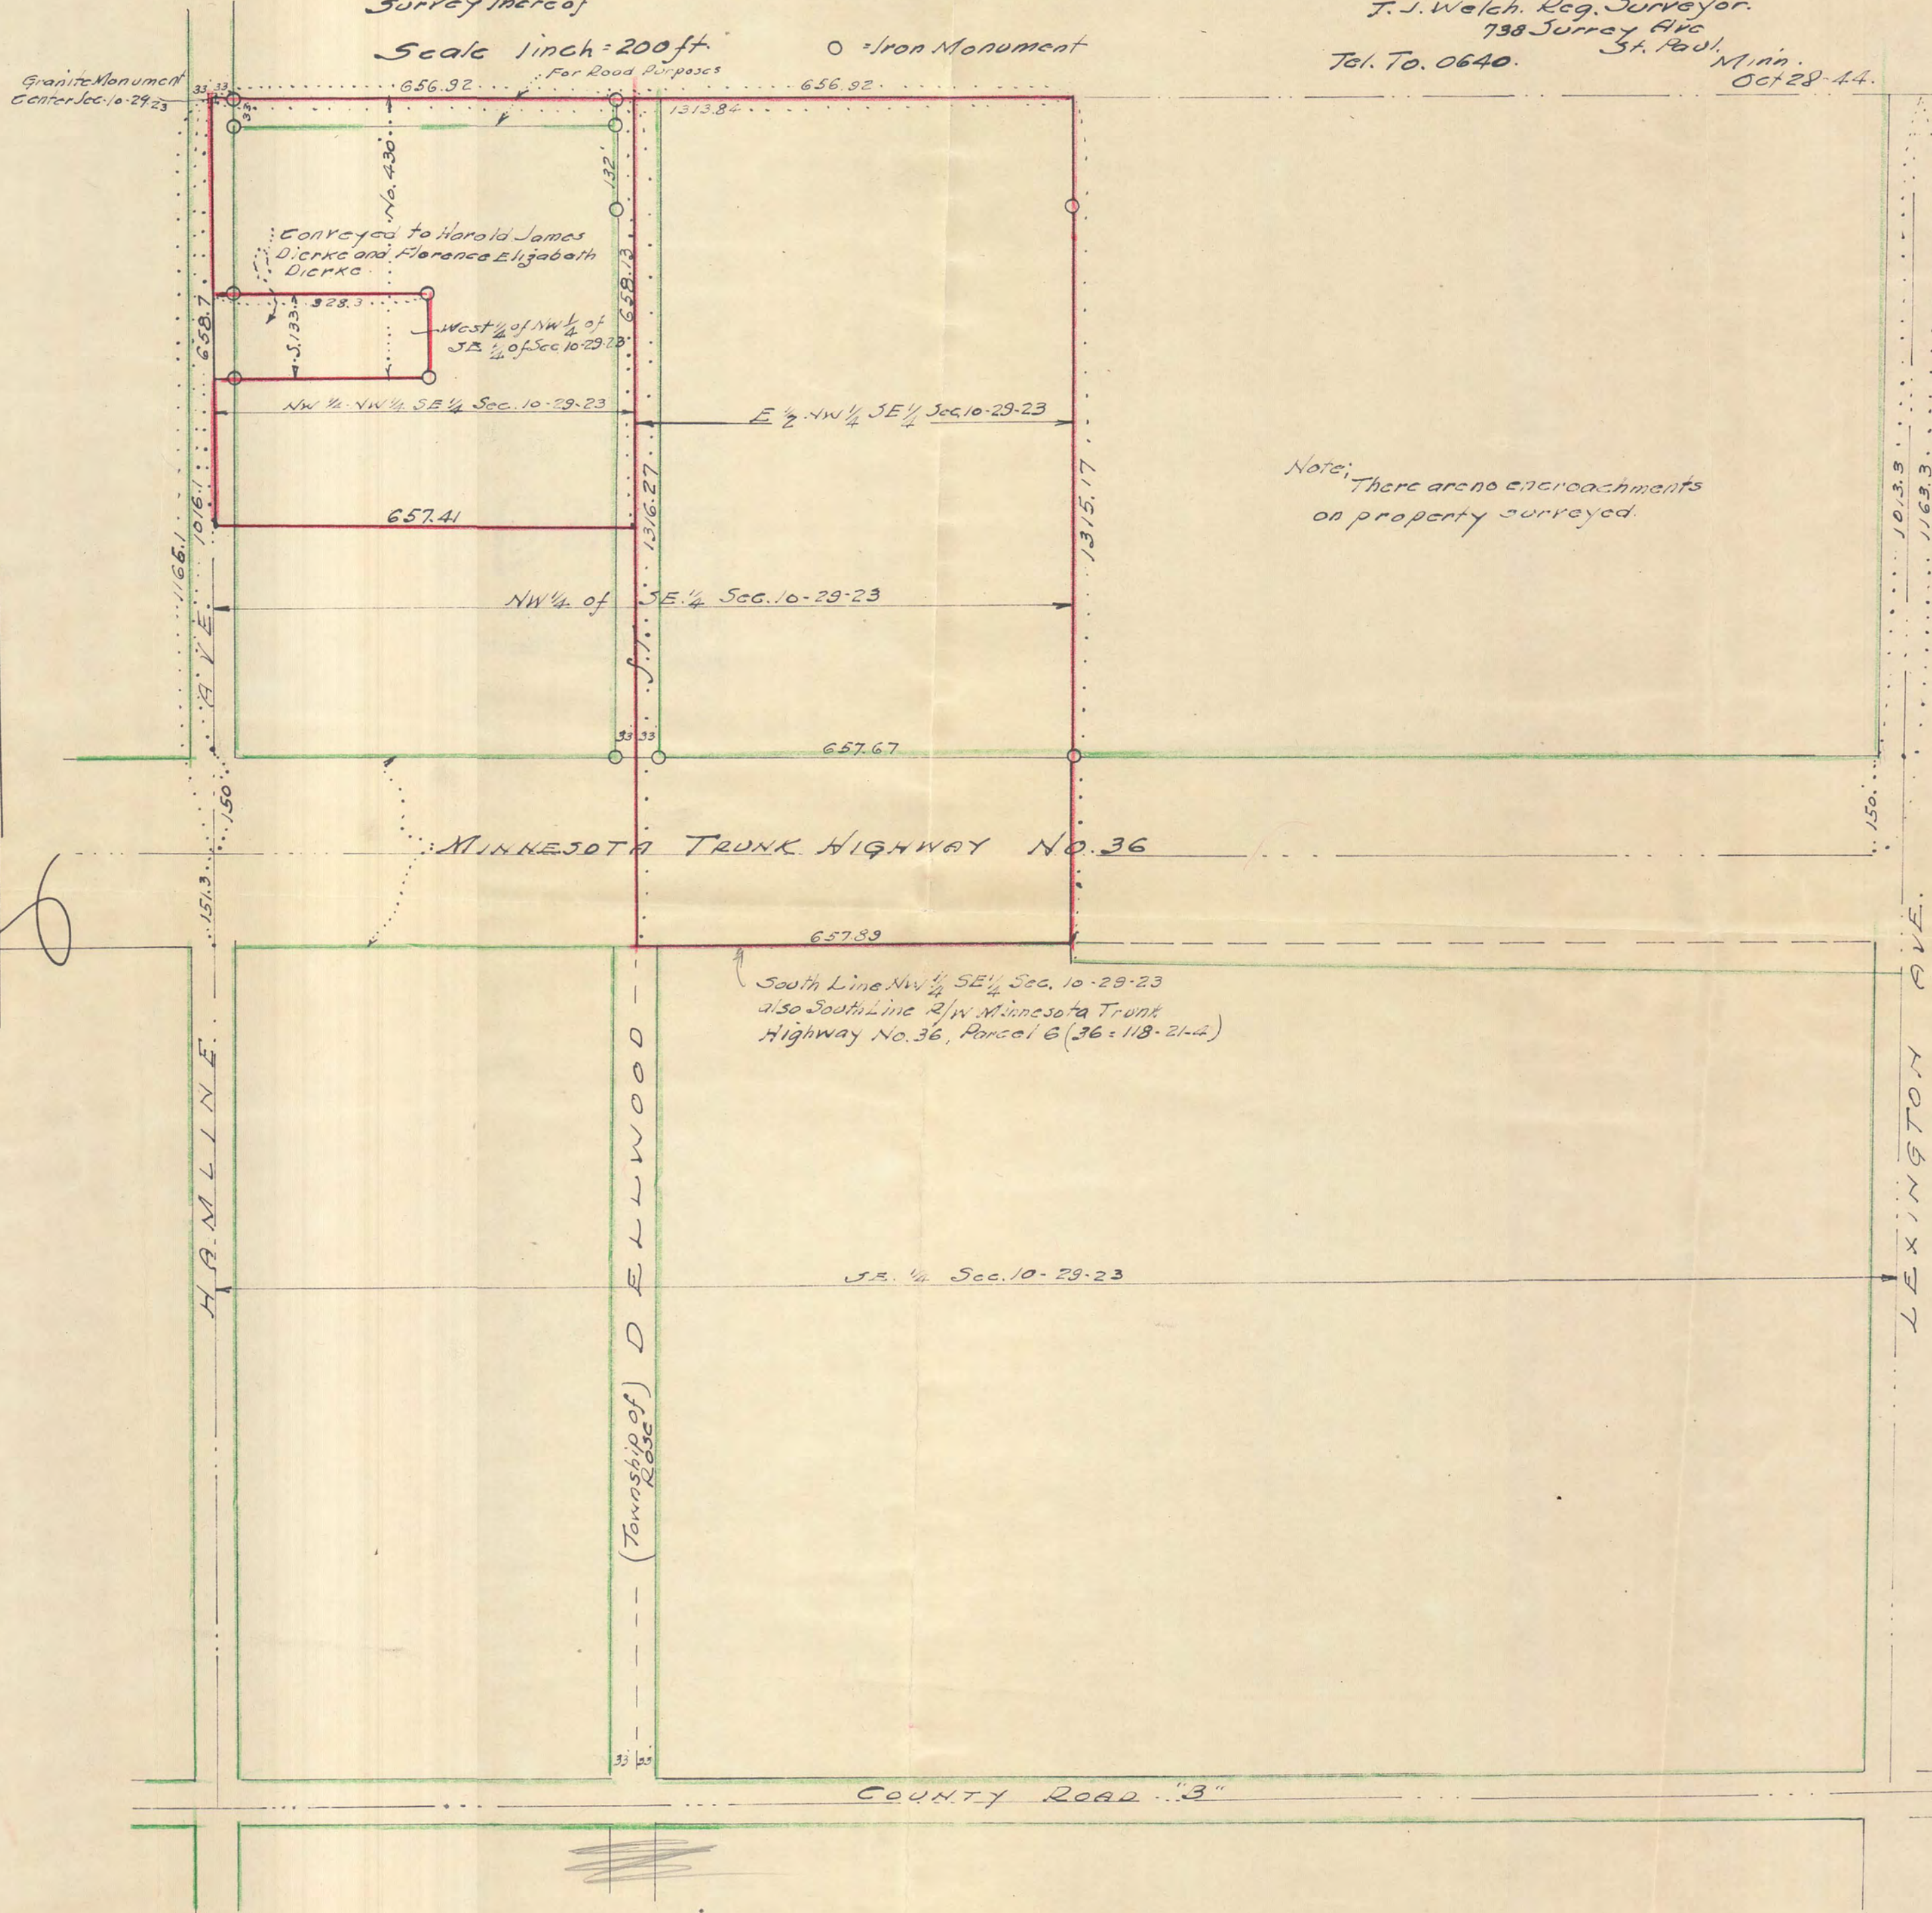

#4728

4728