


4903

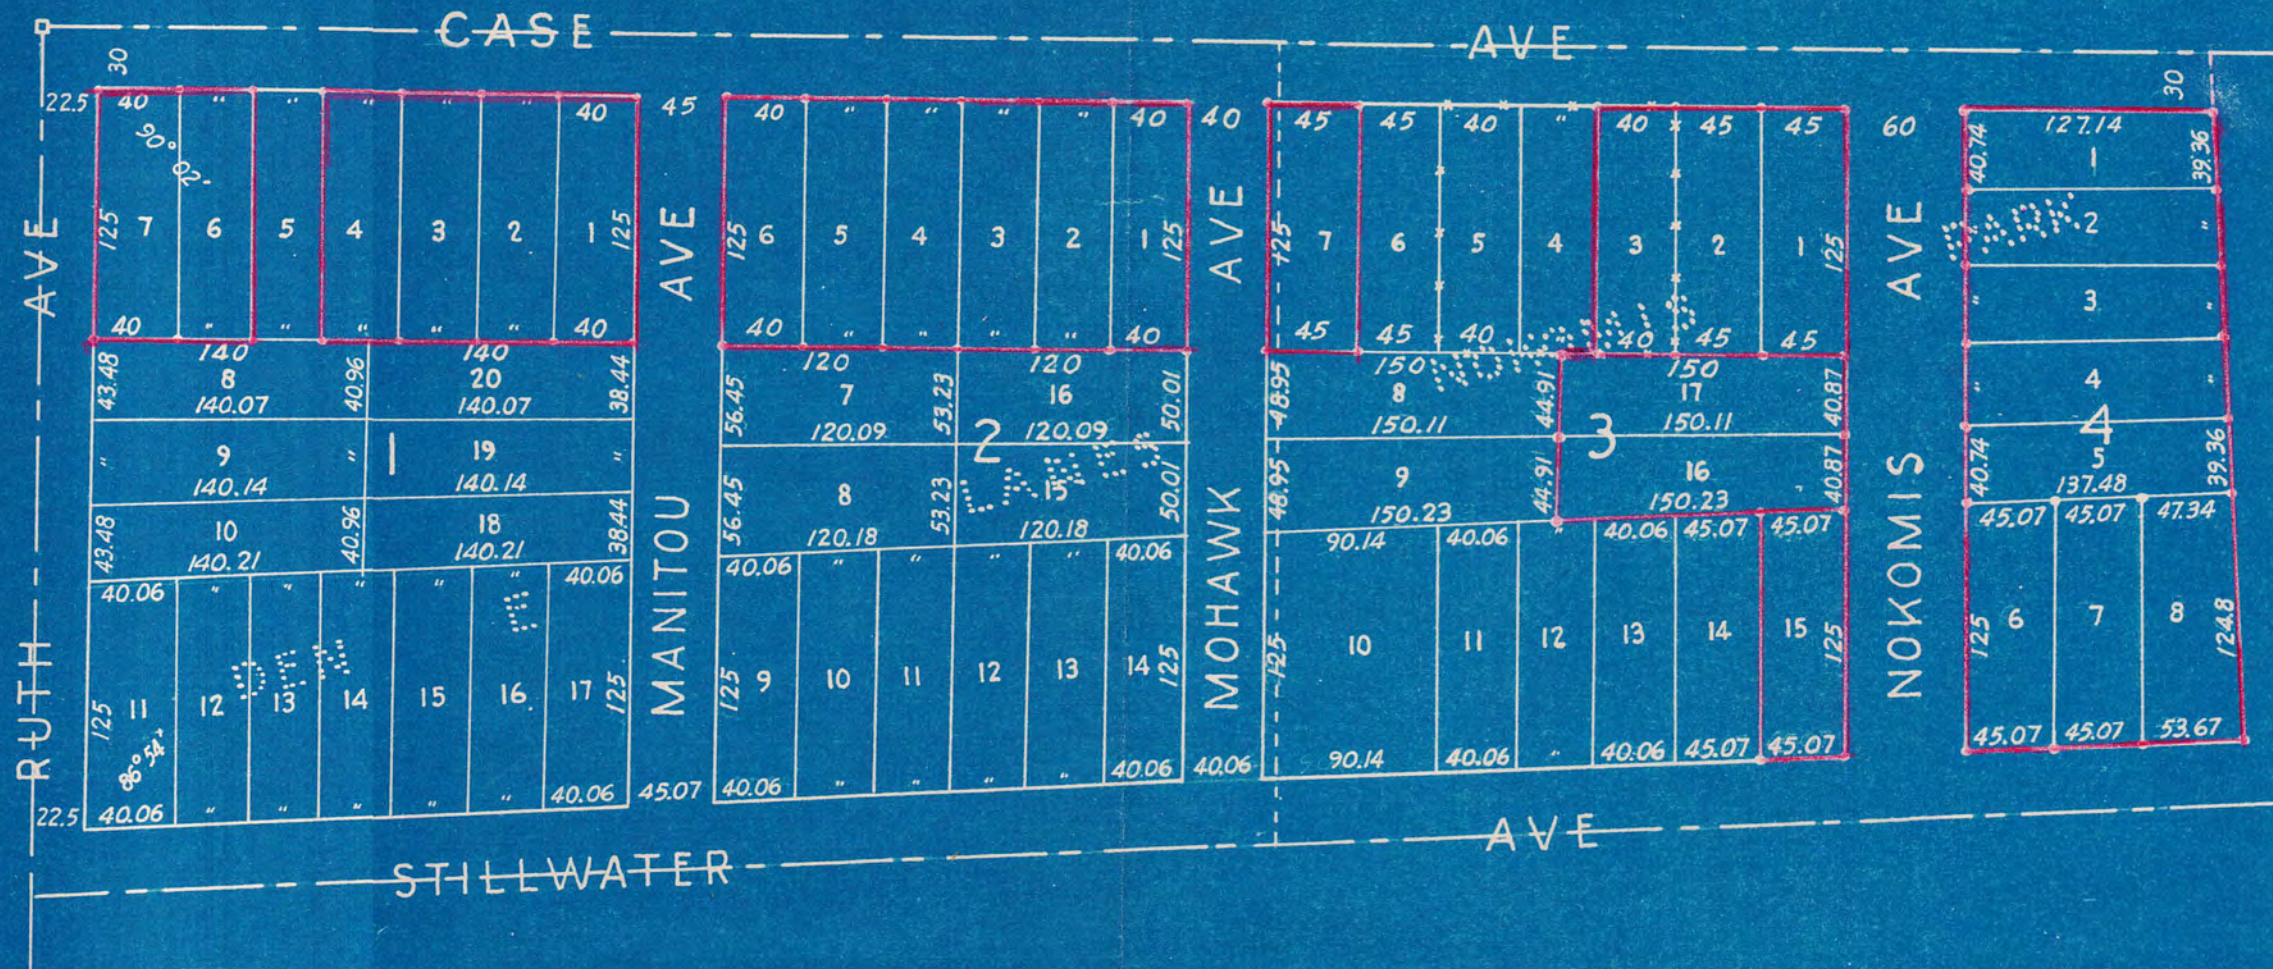

SCALE: 1" = 100'

• Indicates Iron Pipe

~~***~~ FENCES

I, Eugene B. McDonough, do hereby certify that I am a Land Surveyor duly registered under and pursuant to the laws of the State of Minnesota; that I have surveyed,

- Lots 1, 2, 3, 4, 6 and 7, in Block 1;
- Lots 1, 2, 3, 4, 5 and 6, in Block 2;
- Lots 1, 2, 3, 7, 15, 16 and 17 in Block 3;
- Lots 1, 2, 3, 4, 5, 6, 7 and 8 in Block 4;

all in Den E. Lane's Nokomis Park Addition to the City of St. Paul, according to the recorded plat thereof on file and of record in the office of the Register of Deeds, in and for Ramsey County, Minnesota; all of which are outlined in red on this plat;

that I have entered upon, and located said premises and caused to be placed iron pipes at the corners as indicated; that no person or persons are in possession of said property, or any part thereof except that Andrew and Anna M. Onsaeger have constructed a fence which surrounds Lot 3, Block 3 of said Den E. Lane's Nokomis Park Addition as indicated on said plat.

E. B. McDonough
 E. B. McDONOUGH, REGISTERED LAND SURVEYOR NO. 1990
 10-31-45

Subscribed and sworn before me
 this 13 day of October 1945

Roland J. Faricy
 Roland J. Faricy, Notary Public,
 Ramsey County, Minnesota.
 My commission expires June 21, 1952.

#4903