


# PLAT OF SURVEY

DESCRIPTION: Lots 44, 45, 46, 47, 48, 49, 50 and 52, Block 7, Burlington Heights Div. No. 2.

Scale 1 inch = 40 feet.

T. J. Welch, Reg. Surveyor,  
738 Surrey Ave.  
Saint Paul, Minn.  
Nov. 24, 1945.

Tel. To. 0640.

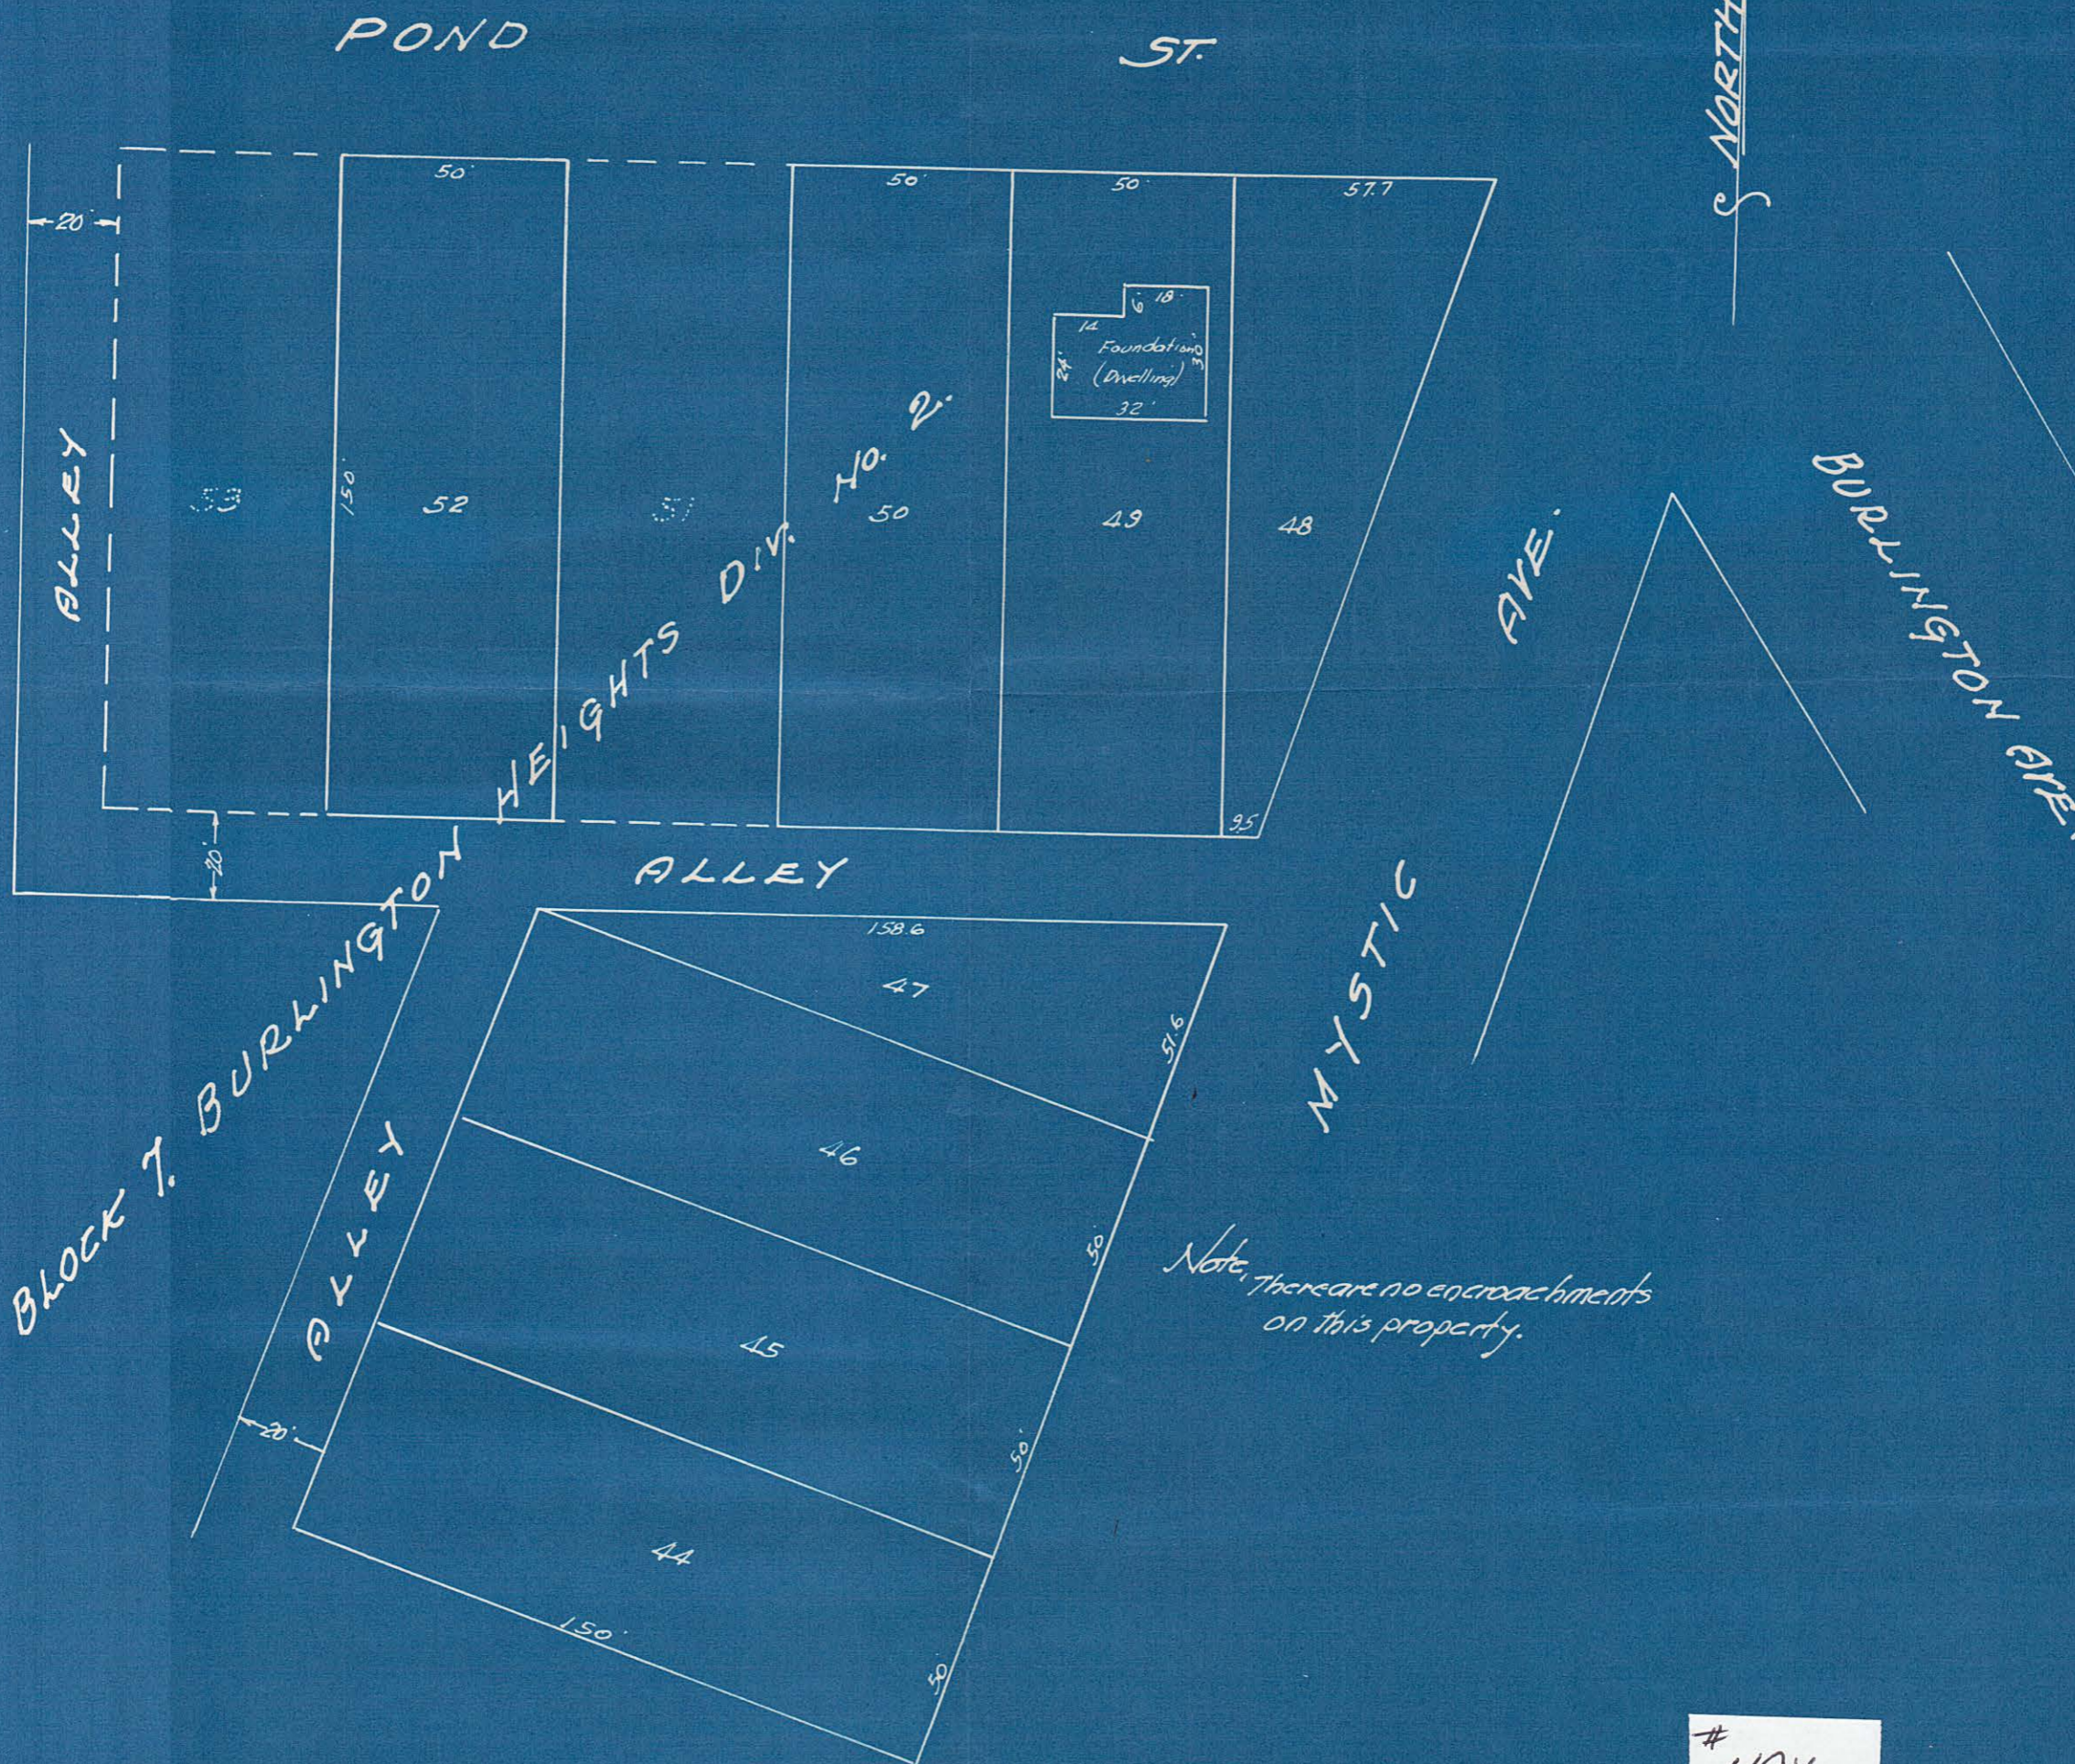

Note: There are no encroachments on this property.

# 4916