


SURVEY OF LOT 1, BLOCK 1, CENTRAL PARK.

Scale 20 Feet pr. inch.

J. Armstrong C.E.
April 1907

AURORA AVE.

AVE.

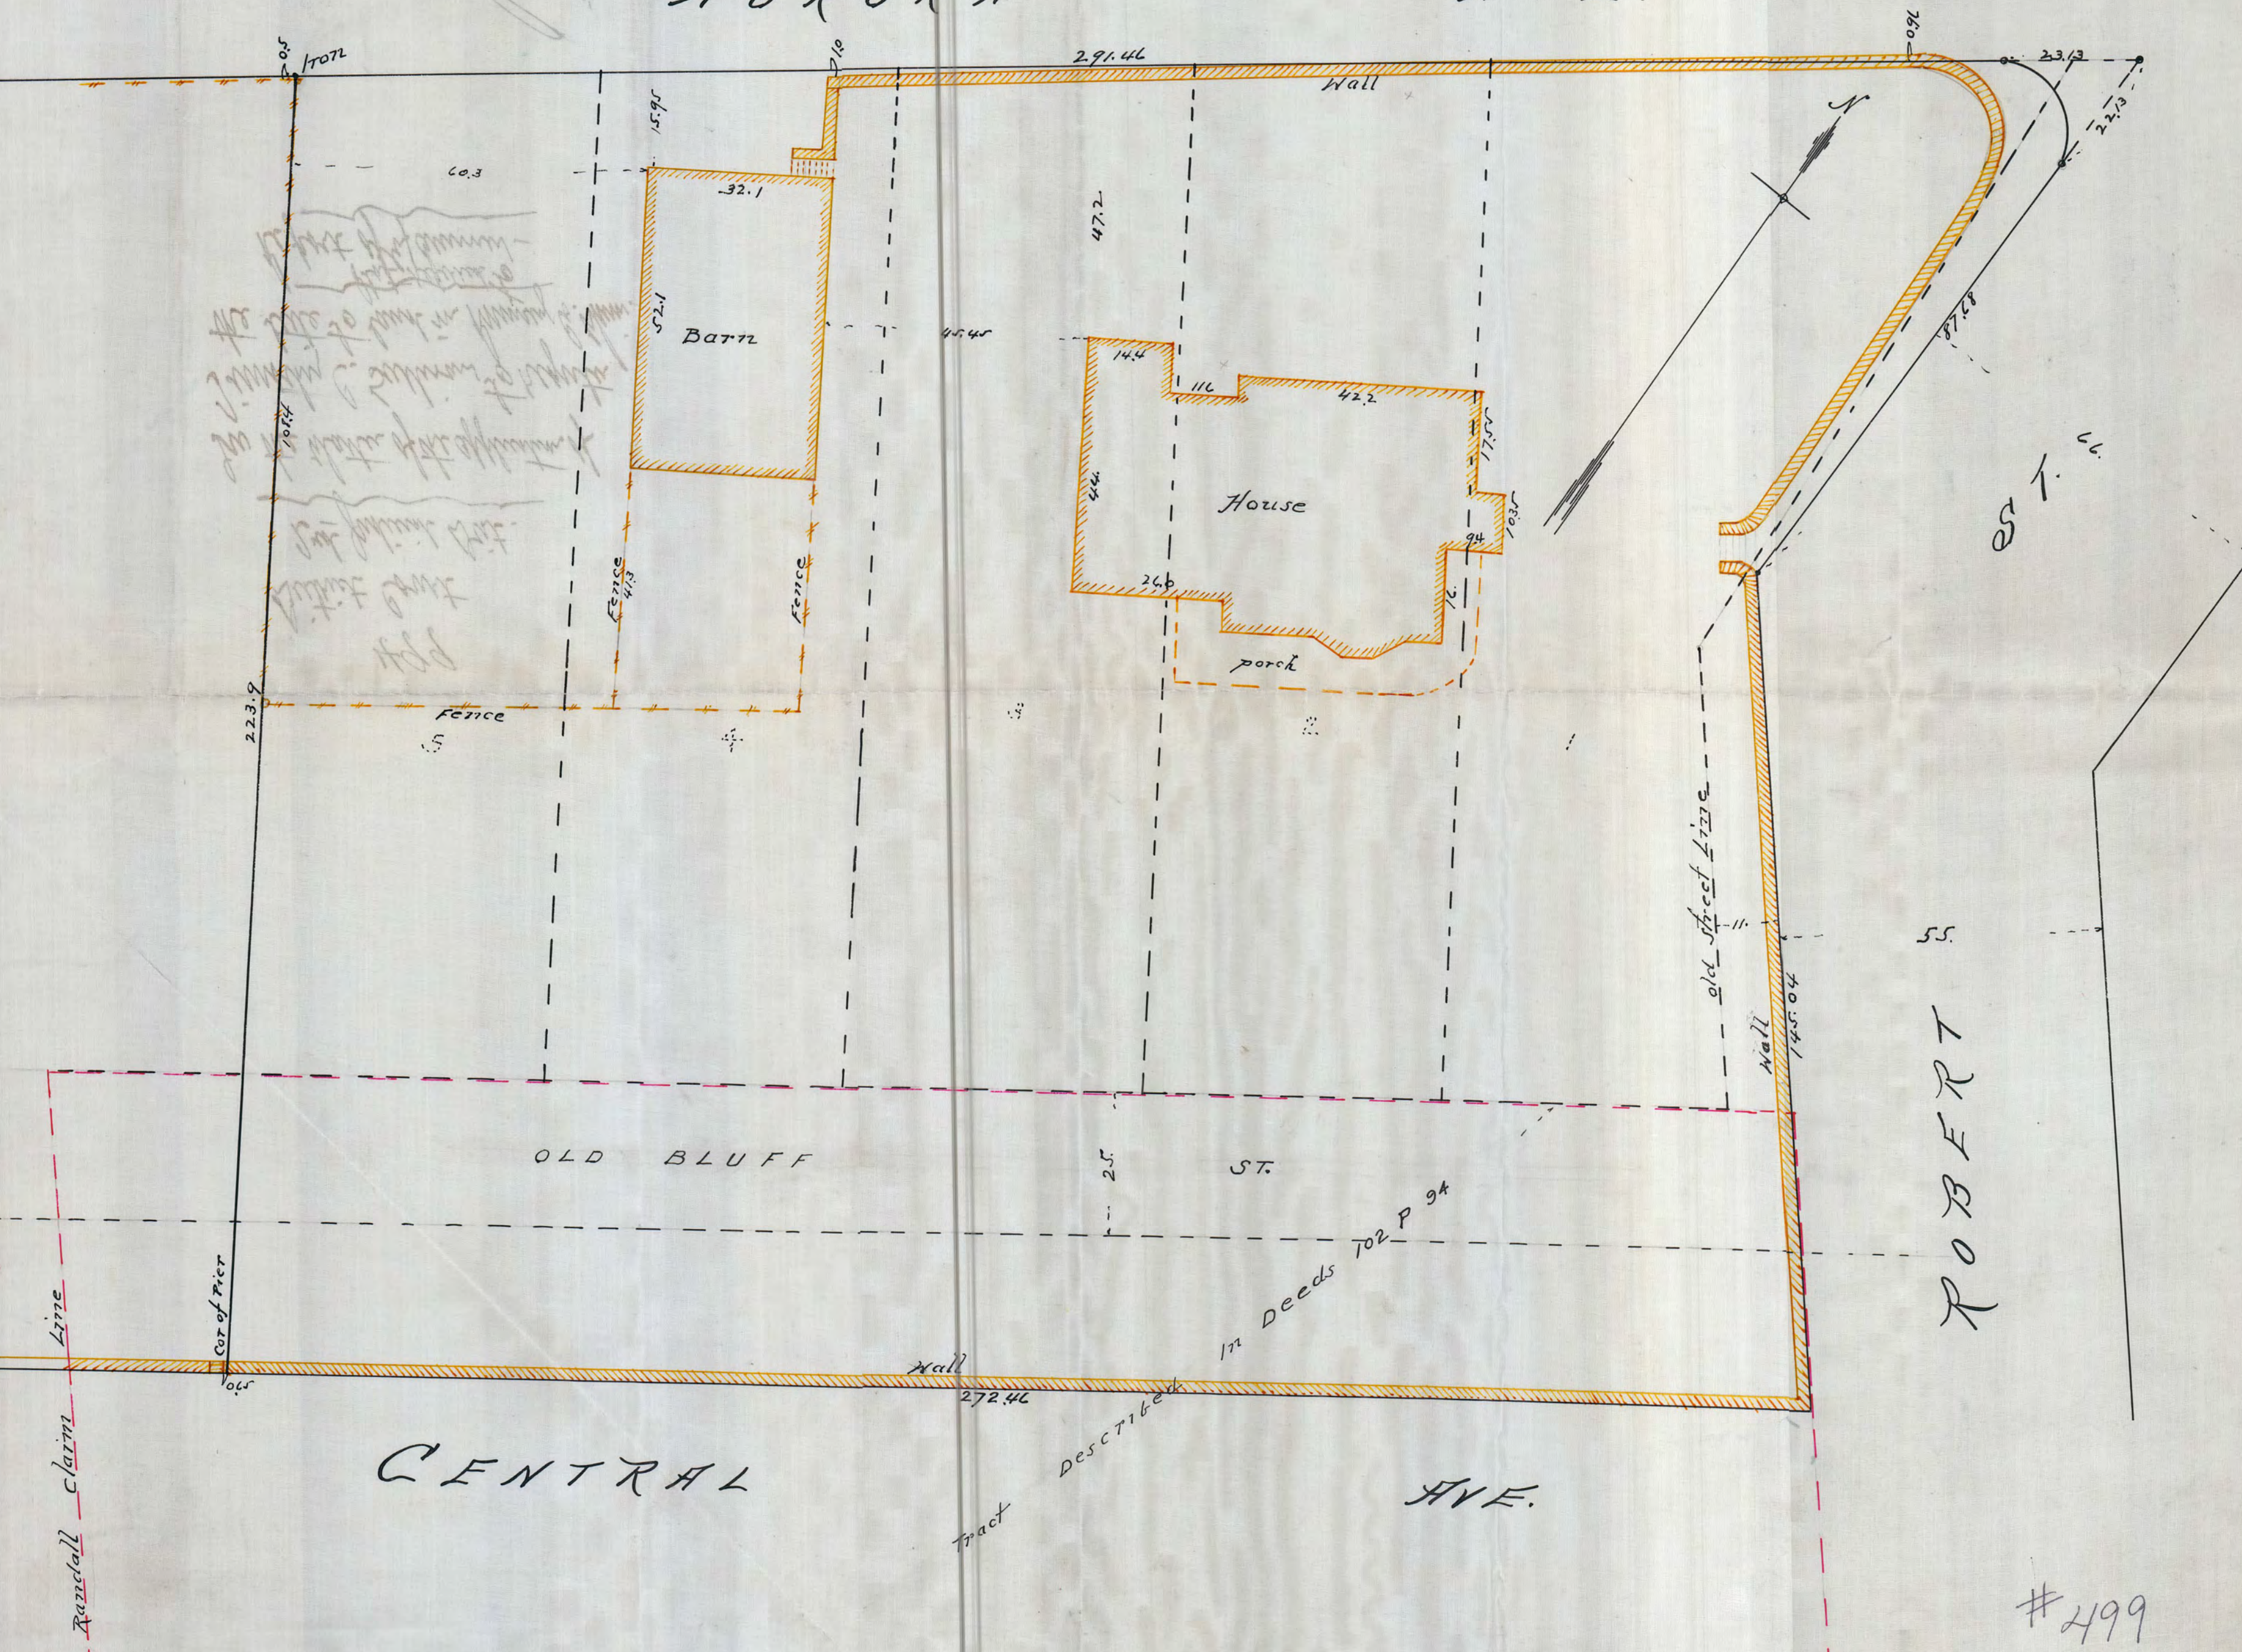


ROBERT S.

#499