

# PLAT OF SURVEY.


DESCRIPTION: (Except Northerly 113 feet and except Westerly 75 feet) Lot 52; also (Except Northerly 113 feet) Lot 53, "Hewitt's Out Lots First Division".

Scale 1 inch 30 feet.

T. J. Welch, Registered Surveyor,  
738 Surrey Ave. St. Paul, Minn.

Tel. To. 0640.

3-1-46.

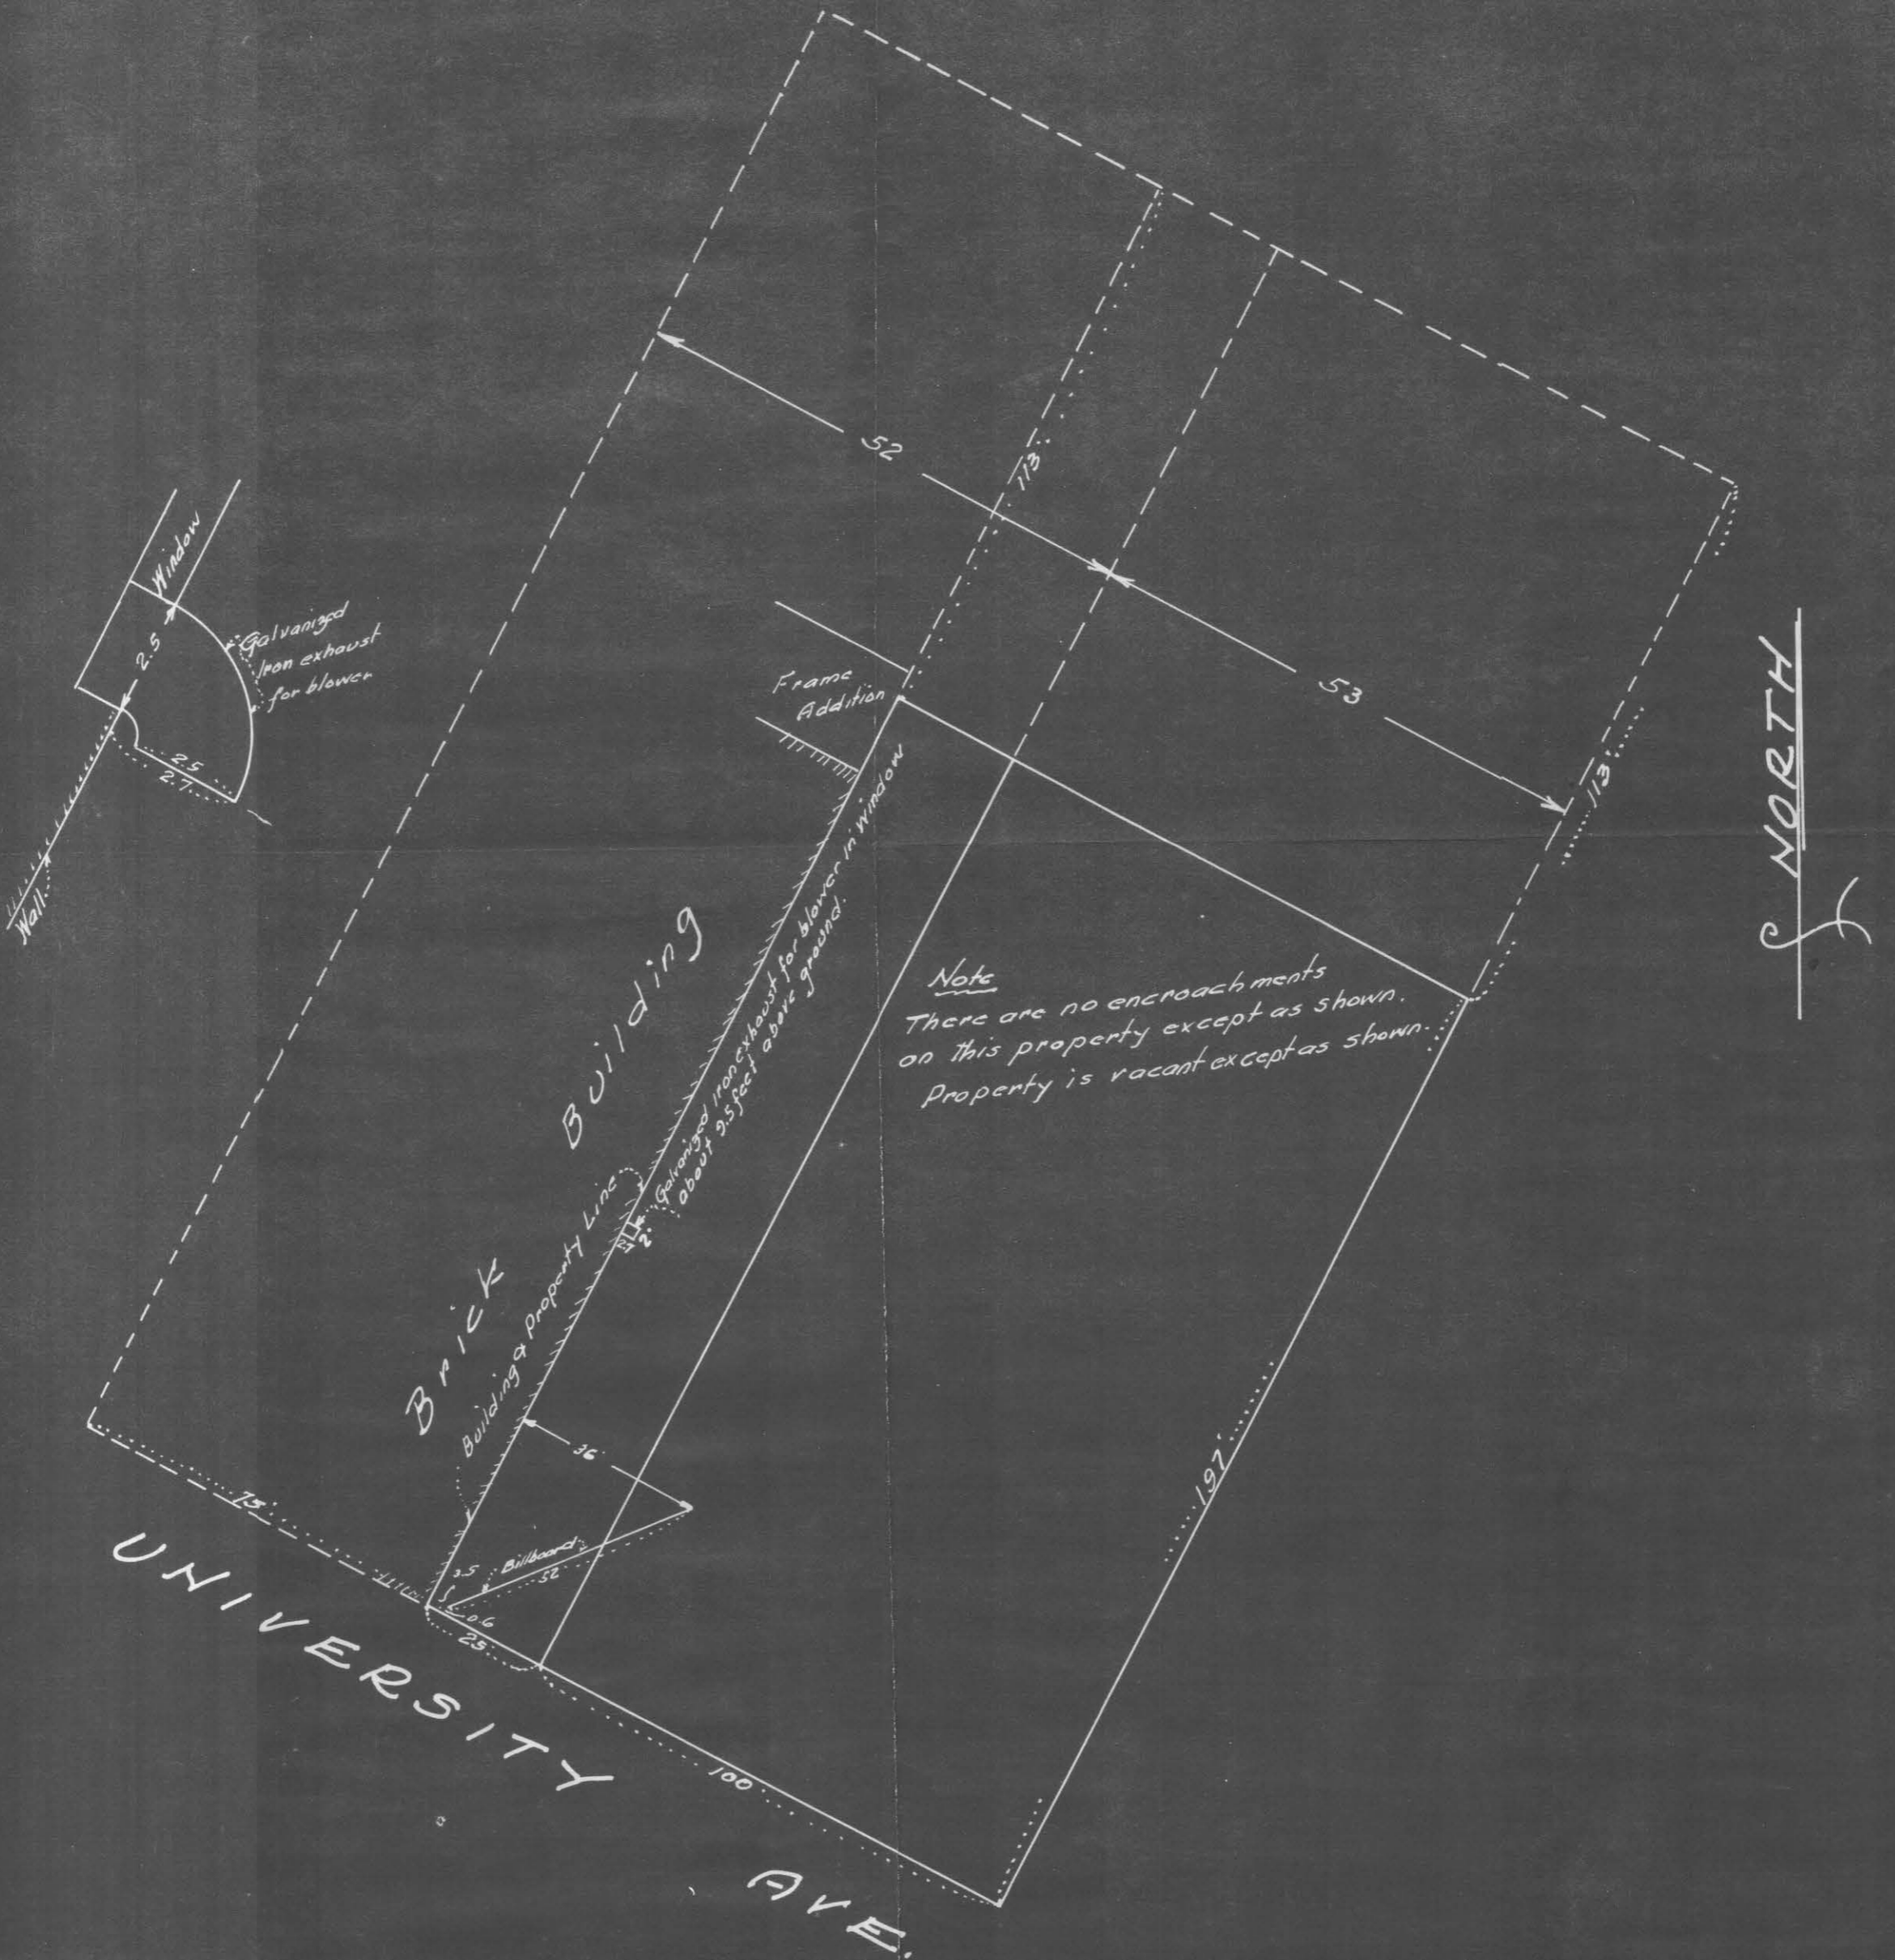

# 5089