

5105

ABSTRACT OF TITLE

Prepared by the St. Paul Abstract Company

No. 1

To

lots 3 and 4, Subdivision of Lots 16,17,18,19,20,21 & 22 Block 7,
Summit Park Addition to St. Paul in Ramsey County, State of Minnesota.

State of Minnesota }
County of Ramsey }


The St. Paul Abstract Company does hereby certify that the following exhibit, consisting of
18 sheets, from 1 to 18 inclusive (each of which bears its Corporate Seal), and
136 entries from 1 to 105,107 to 137 inclusive, is a true and complete Abstract of Title
to the real estate described in No. 1 hereof, as shown by the records in the office of the Register of Deeds in
and for said County and State, up to this 27th day of January 19 23 at 8 o'clock A.M.

THE ST. PAUL ABSTRACT COMPANY
ABSTRACTERS

[Signature]

TREASURER

-2-

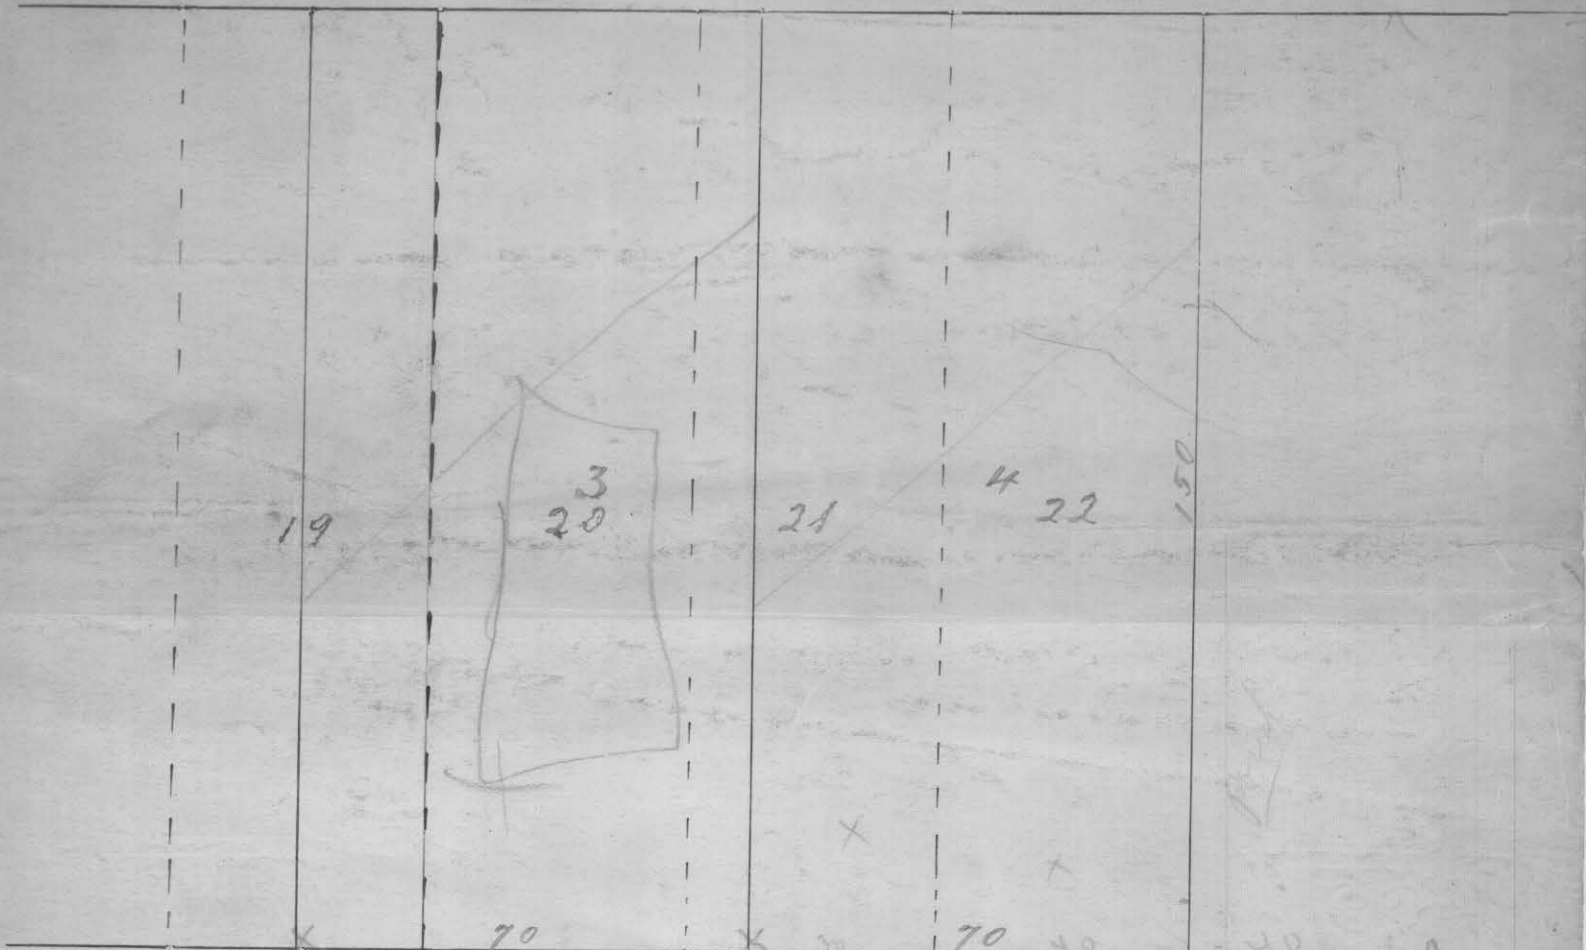

[Signature]
No. 1

Grand

ave

5105

ALLEY 20' Wide



I hereby certify that this map is a true and correct map of Lot 3 Subdivision of Lots 16-17-18-19-20-21 & 22 of Block 7 Summit Park Addition, St. Paul, Minn., that David Goldhirsch residing in the City of Minneapolis, Minn. is the owner and in possession of the above described property and there are no encroachments by others unto said Lot 3; as surveyed by me this 21st day of February 1946

F. J. Armstrong Civil Engr
St. Paul, Minn.

Scale 20 ft. per inch.

5105