


CERTIFICATE of SURVEY

F. J. ARMSTRONG
Civil Engineer and Surveyor
ST. PAUL, MINN.

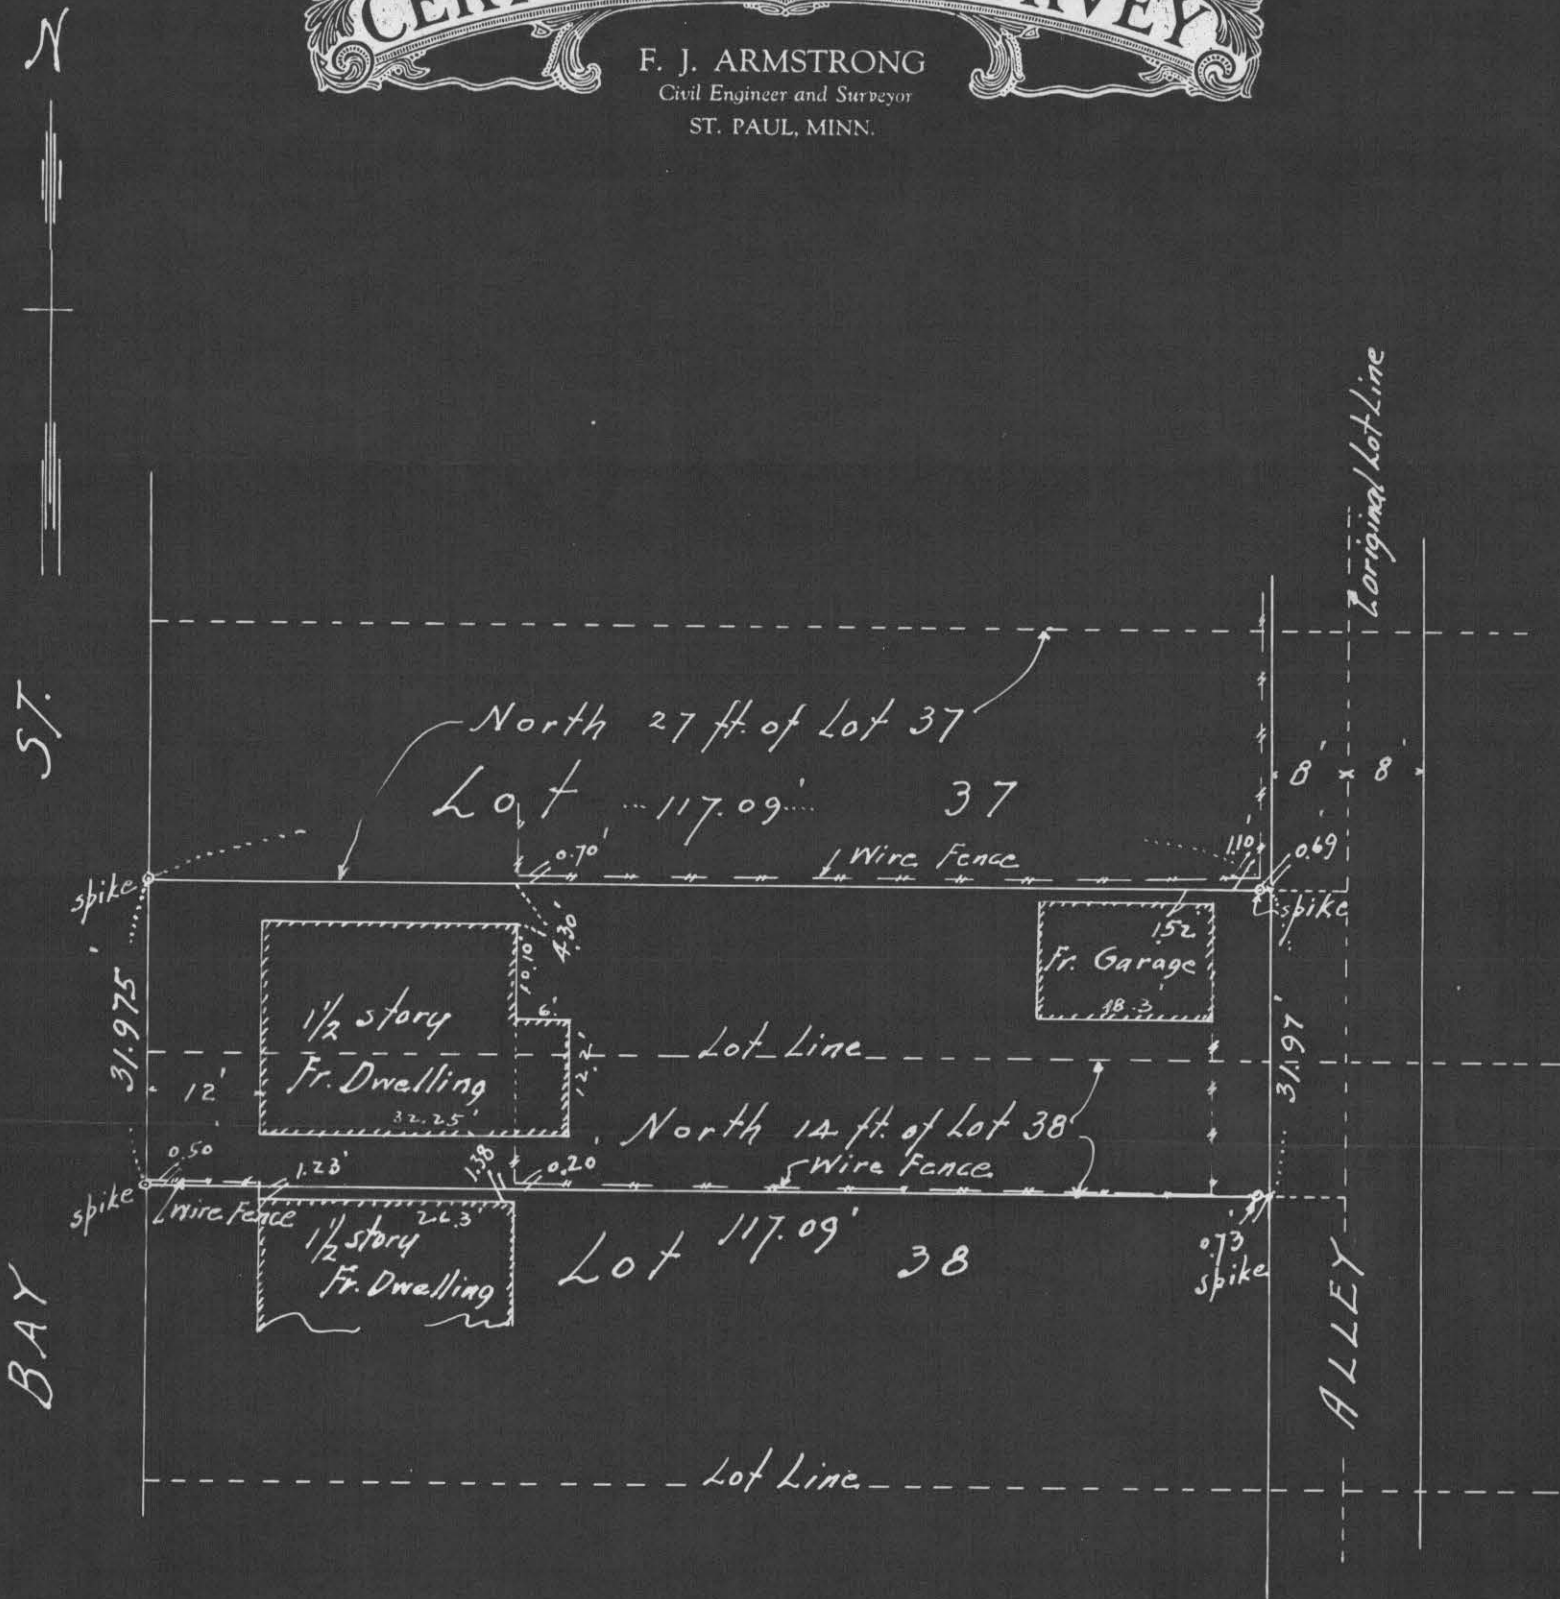

Scale 20 ft. per inch

I HEREBY CERTIFY that on the 22nd day of February A. D. 1946

I made a survey of the following described property, to-wit: Lot 37 except the North 27 feet thereof and the north 14 feet of Lot 38 in Block 19 A. Vance Brown's Sub. of Blocks 19-24th E 1/2 Block 26 Stinson-Brownth Ramsay's Addn.

and the map hereon shown is a true and correct map of said survey and that the improvements thereon indicated are correctly shown.

F. J. Armstrong Civil Engineer.

Subscribed and sworn to before me this _____ day of _____, 19_____

Notary Public.

My Commission Expires _____

5121